

APR 25 1995

**RC 1494**

**COMMISSION**

**LAND CORNER RECORDATION CERTIFICATE**  
**Filing Requirement of Act 74, Mich. P.A. 1970**

**L127797PA636**

For corners in

WAYNE (County)	Located in: TOWNSHIP OF CANTON	Corner Code #
1. Public Land Survey	T <u>2S</u> R <u>8E</u>	L-5
	T _____ R _____	_____
	T _____ R _____	_____
	T _____ R _____	_____
2. Property Controlling in Section	S _____ T _____ R _____	_____
	S _____ T _____ R _____	_____
3. Miscellaneous Property in Sec.	S _____ T _____ R _____	_____
	S _____ T _____ R _____	_____

Compliance with  
 ACT 345, P.A. 1990

APPROVED ON: 12-7-94 *DDJ*

WAYNE COUNTY REMONUMENTATION  
 PEER GROUP COMMITTEE

Register of Deeds Stamp & File Number

**RC 1494**

4. Lot No. \_\_\_\_\_, Recorded Plat \_\_\_\_\_
5. Private Claims \_\_\_\_\_

I, E. PATRICK O'ROURKE, in a field survey on OCTOBER 16, 19 94, do hereby certify that under requirements of P.A. 74, Michigan P.A. of 1970, the corner points mentioned in lines 1 and 2 above were in conformance with regulations and rules therefore as required in the current manual of survey instructions of the United States Department of the Interior, Bureau of Land Management or by a decree of a Court of Law and/or that the corner points mentioned in lines 3, 4 and 5 above were in conformance with the rules of the Michigan Board of Land Surveyors or by a Decree of a Court of Law; established, re-established, monumented, re-monumented, recovered, found as expressed below:

**NOTE: Not more than 4 corners, all in the same town and range, may be recorded on this certificate.**


	A	B	C	D	E	F	G	H	I	J	K	L
2	6	5	4	3	2	1						
3												
4	7	8	9	10	11	12						
5												
6	18	17	16	15	14	13						
7												
8	19	20	21	22	23	24						
9												
10	30	29	28	27	26	25						
11												
12	31	32	33	34	35	36						
13												

A. Description of original monument and accessories and/or subsequent restoration:  
**ORIGINAL GOVERNMENT SURVEY BY T. WAMPLER, D.S. (1815-1819)**  
 G.L.O. (1816) DESCRIPTION OF CORNER NOT STATED IN NOTES  
 WITNESSES: BEECH 7 N 17 E 8 (5.28' R) (GONE)  
 DO 11 S 73 W 20 (13.20' R) (GONE)  
**RESURVEY AT THE DIRECTION OF ALBERT E. CHAMPNEY, DIRECTOR OF WAYNE COUNTY BUREAU OF TAXATION**

\$ 16.00 MISCELLANEOUS RECORDING  
 27 DEC 94 11:02 A.M. RECEIPT# 48A  
 RECORDED  
 FOREST E. YOUNGBLOOD, REGISTER OF DEEDS  
 WAYNE COUNTY, MI

(CONTINUED ON BACK)

B. Description of corner evidence found and/or method applied in restoring or reestablishing corner:  
 FOUND 3/8" RE-ROD IN MONUMENT BOX IN CONCRETE PAVEMENT, 4" BELOW RIM.  
 DISTANCE TO M-5 MEASURED AS 2716.73'; RECORD WPA (1930s) DISTANCES OF 2716.25' AND 2715.50'  
 DISTANCE TO K-5 MEASURED AS 2732.19'; RECORD WPA (1930s) DISTANCES OF 2732.02' AND 2731.80'  
 L.18965 P.483 MONUMENT BOX WITH 1/2" ROD (1974) ACT 74 FORM  
 NORTH 48.29' DRILL HOLE WITH CHISLED SQUARE IN CURB (GONE)  
 N35E 51.56' CHISLED "X" ON SOUTHWEST RIM OF CATCH BASIN (MEASURED 51.89')  
 S10E 31.19' CHISLED "X" ON NORTHWEST RIM OF CATCH BASIN (MEASURED 31.10')  
 L.20224 P.533 FOUND IRON ROD IN MONUMENT BOX (1978) ACT 74 FORM  
 N60E 103.1 SOUTH BOLT X-WAY SIGN (MEASURED 102.97)  
 SOUTH 5.98 PAVEMENT JOINT NORTH EDGE EAST BOUND LANE (MEASURED 6.00)  
 NORTH 6.04 PAVEMENT JOINT SOUTH EDGE WEST BOUND LANE (MEASURED 6.00)  
 EAST 20.35 MEDIAN PAVEMENT JOINT (MEASURED 20.30)  
 (CONTINUED ON BACK)

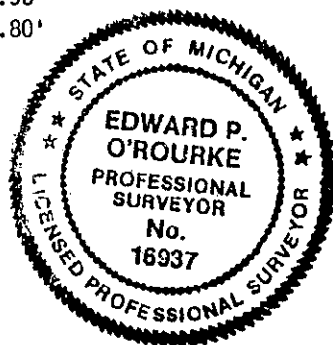

C. Description of monument for corner and accessories established to perpetuate locating the position of the corner:  
 L-5 SOUTH 1/4 CORNER SECTION 12, NORTH 1/4 CORNER SECTION 13, T.2S., R.8E  
 FOUND 3/8" RE ROD IN MONUMENT BOX, IN CONCRETE PAVEMENT, 4" BELOW RIM, AND IT IS ACCEPTED AS A CAREFUL AND FAITHFUL PERPETUATION OF THE POSITION OF THE ORIGINAL CORNER.  
 WITNESSES: N 60° E 102.97' CENTERLINE SOUTH BOLT X-WAY SIGN BASE (PREVIOUSLY USED)  
 S 10° E 31.10' CHISLED "X" ON NORTHWEST RIM OF CATCH BASIN (PREVIOUSLY USED)  
 S 5° E 49.40' CHISLED "X" ON WEST RIM OF STORM MANHOLE (PREVIOUSLY USED)  
 N 35° E 51.89' CHISLED "X" ON SOUTHWEST RIM OF CATCH BASIN (PREVIOUSLY USED)

PLACED A REMONUMENTATION BRASS TAG AND CAP #16937 ON RE-ROD.

Signed by E. Patrick O'Rourke  
 Surveyor's Michigan License No. 16937

Date 12-27-94

*CR*  
*14-D*  
*1156*

L127797PA637

SECTION A (CONTINUED)

MPA (1930s) CROSS N 13 #54

WITNESSES: NE 41.30' 30" ELM (GONE)  
SE 79.11' EDISON POLE (GONE)  
SW 12.47' CROSS (GONE)  
SW 83.21' 10" ELM (GONE)  
NW 65.45' 4" ELM (GONE)

SECTION B (CONTINUED)

L.24832 P.881 FOUND 1/2" IRON ROD IN MONUMENT BOX (1983) ACT 74 FORM  
N 60° E 102.52' SOUTHWEST BOLT X-WAY SIGN BASE (MEASURED 102.53')  
S 40° E 102.57' NAIL AND TAG NORTHEAST SIDE POWER POLE (MEASURED 102.45')  
S 5° E 49.47' CHISLED "X" IN WEST SIDE MANHOLE RIM (MEASURED 49.40')  
N 35° W 72.09' DRILLED HOLE TOP OF CURB (GONE)