

SURVEY & REMONUMENTATION

RC 1504

APR 25 1995

COMMISSION

LAND CORNER RECORDATION CERTIFICATE

Filing Requirement of Act 74, Mich. P.A. 1970

LI27797PA656

For corners in

WAYNE (County)

Located In:

Corner Code #

TOWNSHIP OF CANTON #07

1. Public Land Survey T 2S R 8E M-8
2. Property Controlling S T R
3. Miscellaneous S T R
- Property in Sec. S T R

Compliance with
ACT 345, P.A. 1990

APPROVED ON: 12-7-94
WAYNE COUNTY REMONUMENTATION
PEER GROUP COMMITTEE

Register of Deeds Stamp & File Number

4. Lot No. , Recorded Plat
5. Private Claims

I, E. PATRICK O'ROURKE, in a field survey on NOVEMBER 22, 19 94, do hereby certify that under requirements of P.A. 74, Michigan P.A. of 1970, the corner points mentioned in lines 1 and 2 above were in conformance with regulations and rules therefore as required in the current manual of survey instructions of the United States Department of the Interior, Bureau of Land Management or by a decree of a Court of Law and/or that the corner points mentioned in lines 3, 4 and 5 above were in conformance with the rules of the Michigan Board of Land Surveyors or by a Decree of a Court of Law; established, re-established, monumented, re-monumented, recovered, found as expressed below:

NOTE: Not more than 4 corners, all in the same town and range, may be recorded on this certificate.

A. Description of original monument and accessories and/or subsequent restoration:

ORIGINAL GOVERNMENT SURVEY BY T. WAMPLER, D.S. (1815-1819)

G.L.O. (1815-1819) DESCRIPTION OF CORNER NOT STATED IN NOTES

WITNESSES: A BEECH 18" S 77 E 23 (15.18' R) (GONE)

A LYNN 12" N 77 W 19 (12.54' R) (GONE)

RESURVEY AT THE DIRECTION OF ALBERT E. CHAMPNEY, DIRECTOR OF WAYNE COUNTY BUREAU OF TAXATION

(CONTINUED ON BACK)

B. Description of corner evidence found and/or method applied in restoring or reestablishing corner:

FOUND 3/4" IRON PIPE IN MODERATELY WOODED AREA.

DISTANCE TO M-9 MEASURED AS 2668.90'; RECORD WPA (1930) DISTANCE AS 2667.89'

DISTANCE TO M-7 MEASURED AS 2634.38'; RECORD WPA (1930) DISTANCE AS 2633.87'

L.18650 P.765-766 FOUND 3/4" IRON PIPE (NOVEMBER 8, 1973)

N 10°00'00" E 4.56 NAIL WITH CAP IN TWIN 6" HICKORY (FOUND) (MEAS. 4.75)

S 87°00'00" E 52.97 NAIL WITH CAP IN NORTH SIDE DETROIT EDISON POLE (FOUND) (MEAS. 53.10)

DUE SOUTH 5.40 NAIL WITH CAP IN 24" ELM (GONE)

S 75°00'00" W 17.07 PK NAIL IN SOUTH SIDE 14" MAPLE (GONE)

(CONTINUED ON BACK)

C. Description of monument for corner and accessories established to perpetuate locating the position of the corner:

M-8 EAST 1/4 CORNER SECTION 24 T.2S., R.8E

FOUND 3/4" IRON PIPE IN MODERATELY WOOD AREA OF UNIMPROVED HANNAN ROAD R.O.W. AND IT IS ACCEPTED AS A CAREFUL AND FAITHFUL PERPETUATION OF THE POSITION OF THE ORIGINAL CORNER.

WITNESSES: N 19° E 4.75' W.C.R.C. NAIL AND TAG EAST SIDE TWIN 6" HICKORY (PREVIOUSLY USED)

S 87° E 53.12' W.C.R.C. NAIL AND TAG NORTH SIDE DETROIT EDISON POLE (PREVIOUSLY USED)

S 2° E 4.70' PK NAIL NORTH SIDE 36" ELM

S 73°50' W 17.16' SET W.C.R.C. TAG AND NAIL NORTH SIDE 18" MAPLE


N 10°10' W 31.03' SET W.C.R.C. TAG AND NAIL EAST SIDE TWIN 10" MAPLE

PLACED A REMONUMENTATION BRASS DISC AND PVC CAP #16937 ON 3/4" PIPE M-8

Signed by

Date

E. PATRICK O'ROURKE
Surveyor's Michigan License No. 16937

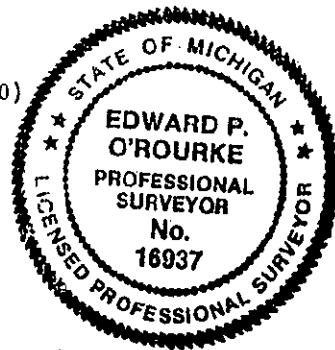

RC 1504

212
14 P
Misc

L127797PA657

SECTION A (CONTINUED)

WPA (1930 +/-) IRON (E-24) #104

WITNESSES: N 41.02 IRON
NE 82.75 5" OAK (GONE)
S 26.47 8" ELM (GONE)

WCC

WPA-(APRIL 1970) IRON (E-24) #104

WITNESSES: NNW 41.84 MONUMENT
NE 4.60 10" TWIN HICKORY (FOUND) (MEAS. 4.75)
E 52.88 DETROIT EDISON POLE (FOUND) (MEAS. 53.12)
SE 5.38 28" ASH (GONE)
SW 17.04 12" ASH (GONE)

SECTION B (CONTINUED)

WADE-TRIM TIES 1980 (NOT RECORDED) 1" IRON PIPE

NORTH 41.89 CONCRETE MONUMENT (NOT LOCATED)
NE 23.43 PK NAIL SOUTH SIDE 8" ELM (GONE)
SE 28.08 PK NAIL WEST SIDE 10" OAK (GONE)
SOUTH 4.74 PK NAIL NORTHEAST ROOT 36" OAK (MEAS. 4.70)
SW 16.93 PK NAIL NORTH SIDE 16" ELM (MEAS. 17.16)

NO OTHER L.C.R.C. AT WAYNE COUNTY REGISTER OF DEEDS