

RC 1198

LI26992PA885

LAND CORNER RECORDATION CERTIFICATE Filing Requirement of Act 74, Mich. P.A. 1970

For corners in

Wayne
(County)

Located In:

City of Detroit

OTHER

Corner Code # 6

1. Public Land Survey

T 25 R 12 E # 006

2. Property Controlling
in Section

S T R

3. Miscellaneous
Property in Sec.

S T R

4. Lot No. _____, Recorded Plat _____

5. Private Claims Point common to PC#15 & PC#18 @ centerline Mack Ave.

I, Martin C. Dunn, in a field survey on November 6, 1993, do hereby certify that under requirements of P.A. 74, Michigan P.A. of 1970, the corner points mentioned in lines 1 and 2 above were in conformance with regulations and rules theretofore as required in the current manual of survey instructions of the United States Department of the Interior, Bureau of Land Management or by a decree of a Court of Law and/or that the corner points mentioned in lines 3, 4 and 5 above were in conformance with the rules of the Michigan Board of Land Surveyors or by a Decree of a Court of Law; established, re-established, monumented, re-monumented, recovered, found as expressed below:

NOTE: Not more than 4 corners, all in the same town and range, may be recorded on this certificate.

A. Description of original monument and accessories and/or subsequent restoration:
Corner not set in original government survey.

B. Description of corner evidence found and/or method applied in restoring or reestablishing corner:

Set corner by using stone curb splits, sidewalks and buildings to establish the right-of-way lines of Mt. Elliot & Mack as per J. Breitmyers Sub'n L.9, P.47 (W.C.R.), Walker's Sub'n L.6, P.63 (W.C.R.), & A. Mylius Sub L.6, P.34 (W.C.R.).
Set 1/2" X 18" iron cap #30081 within a monument box.

C. Description of monument for corner and accessories established to perpetuate locating the position of the corner:
Wayne County Remonumentation marker and cap #30081 over 1/2 X 18" iron in monument box

Witnesses



291° AZ. - 48.13' Set masonry Nail with W.C.R. tag in walk @ NW cor. Mt. Elliott and Mack 7.70 to centerline light pole and 15.8 to Hyd.
20° AZ. - 39.67' Set P.K. Nail with W.C.R. tag @ NE cor. of Mt. Elliott and Mack in rock curb in Middle curve 7.45 to light pole and 12.3' & to centerline of door @ party store
111° AZ. - 47.78' Set P.K. Nail with W.C.R. tag @ SE cor. of Mt. Elliott and Mack P.80 to back of walk of Mack and 8.50 to back of walk of Mt. Elliott
206° AZ. - 46.80' Set masonry Nail with W.C.R. tag @ SW cor. of Mt. Elliott and Mack in sidewalk 10.65 to centerline L.P. and 4.70' to back of curb

The selected location for this Property Controlling Monument is accepted as a careful and faithful determination of the position as indicated.

Signed by Martin C. DunnDate 11/17/93Surveyor's Michigan License No. 30081Compliance with
ACT 345, P.A. 1990

APPROVED ON: 11-18-93 DRJ
WAYNE COUNTY REMONUMENTATION
PEER GROUP COMMITTEE

Register of Deeds Stamp & File Number

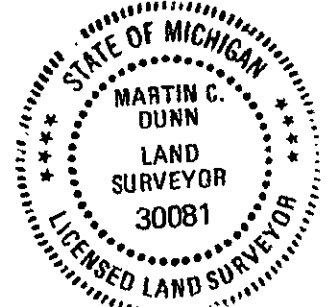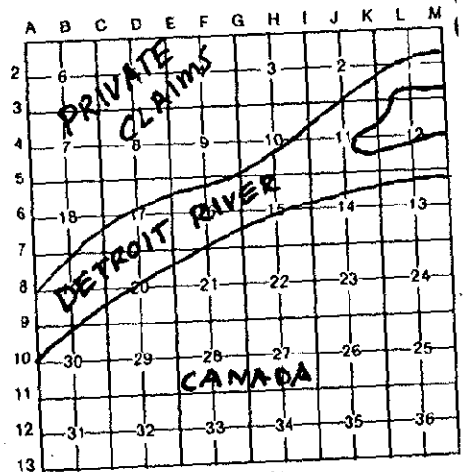

FOREST COUNTY
REGISTER OF DEEDS
WAYNE COUNTY, MI

33 NOV 30 PM 5:25