

RC 1193

LI 26992 PA 880

LAND CORNER RECORDATION CERTIFICATE Filing Requirement of Act 74, Mich. P.A. 1970

For corners in

OTHER

Corner Code # 7

Wayne

(County)

Located In:
City of Detroit

1. Public Land Survey

T 28 R 14E

007

T R

T R

T R

T R

2. Property Controlling
in Section

S T R

S T R

3. Miscellaneous
Property in Sec.

S T R

S T R

Compliance with
ACT 345, P.A. 1990

APPROVED ON: 11-18-93
WAYNE COUNTY REMONUMENTATION
PEER GROUP COMMITTEE

Register of Deeds Stamp & File Number

4. Lot No. , Recorded Plat

5. Private Claims Point common with the w. line FC/L & centerline of Gratiot Ave.

I, Martin C. Dunn, in a field survey on November 6, 19 93,
do hereby certify that under requirements of P.A. 74, Michigan P.A. of 1970, the corner points mentioned
in lines 1 and 2 above were in conformance with regulations and rules therefore as required in the
current manual of survey instructions of the United States Department of the Interior, Bureau of Land
Management or by a decree of a Court of Law and/or that the corner points mentioned in lines 3, 4 and 5
above were in conformance with the rules of the Michigan Board of Land Surveyors or by a Decree of a
Court of Law; established, re-established, monumented, re-monumented, recovered, found as
expressed below:

NOTE: Not more than 4 corners, all in the same town and range, may be recorded
on this certificate.

A. Description of original monument and accessories and/or subsequent restoration:
No corner set in original government survey.

B. Description of corner evidence found and/or method applied in restoring or reestablishing corner:

Calculated point using information obtained from City of Detroit Engineering department
Drawing No. S-443 Aug. of 1968) and S-455 (Nov. 1968).
Placed Wayne County Remonumentation marker and cap #30081 on 1/2" X 18" iron in
mon. box.

C. Description of monument for corner and accessories established to perpetuate locating the position of the corner:
Wayne County Remonumentation marker and cap #30081 on 1/2" X 18" iron in mon. box.


Witnesses

252° AZ - 34.16 -Set masonry Nail with W.C.R. tag in Island N. of Jefferson on Randolph 26.3 to strain
pole and 1.15 to back of curb
335° AZ - 54.10 -Set P.K. Nail with W.C.R. tag in asphalt St. N. of Jefferson on East side Randolph
0.10 to face of curb and 24.15 NW of 1st P. Meter on Randolph N. of Jefferson
64° AZ - 97.09 -Set P.K. Nail with W.C.R. tag in sawcut of walk 7.45 of RM cor. Rl 16 and 7.05 to back
of curb
142° AZ - 90.55 -Set masonry Nail with W.C.R. tag in walk in East medium of Jefferson 6.65 N of Light
pole and 4.55 E of back of curb

The selected location for this Property Controlling Monument is accepted as a careful and faithful determination
of the position as indicated

Signed by Martin C. DunnDate 11/17/93Surveyor's Michigan License No. 30081

FORM APPROVED BY MICHIGAN STATE BOARD OF LAND SURVEYORS, JAN. 28, 1971
REVISED MAY 14, 1975
REVISED JAN., 1983

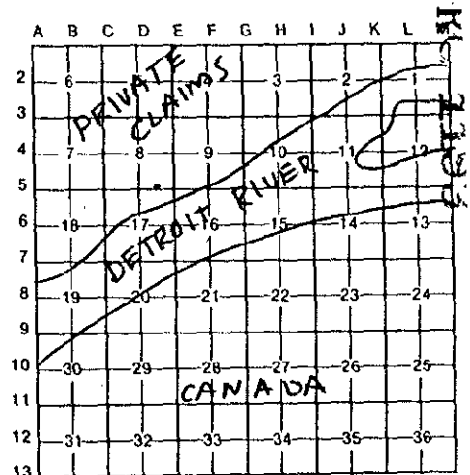

NOV 30 PM 4:25
FOREST E. YOUNGBLOOD
REGISTERED DEEDS
MICHIGAN COUNTY, MI