

RC 1200

LI 26992 PA 887

LAND CORNER RECORDATION CERTIFICATE
Filing Requirement of Act 74, Mich. P.A. 1970

For corners in

Wayne

(County)

Located In:

City of Detroit

OTHER

Corner-Code # 10

1. Public Land Survey

T 25 R 12E# 010

T _____ R _____

T _____ R _____

T _____ R _____

2. Property Controlling
in Section

S _____ T _____ R _____

S _____ T _____ R _____

3. Miscellaneous
Property in Sec.

S _____ T _____ R _____

S _____ T _____ R _____

Compliance with
 ACT 345, P.A. 1990

APPROVED ON: 11-18-93 D.G.J.
 WAYNE COUNTY REMONUMENTATION
 PEER GROUP COMMITTEE

Register of Deeds Stamp & File Number

4. Lot No. _____, Recorded Plat _____

5. Private Claims Point common to E $\frac{1}{2}$ PC/91 & PC/733 at centerline of Gratiot
and Chene St.

I, Martin C. Dunn, in a field survey on November 6, 19 93,
 do hereby certify that under requirements of P.A. 74, Michigan P.A. of 1970, the corner points mentioned
 in lines 1 and 2 above were in conformance with regulations and rules therefore as required in the
 current manual of survey instructions of the United States Department of the Interior, Bureau of Land
 Management or by a decree of a Court of Law and/or that the corner points mentioned in lines 3, 4 and 5
 above were in conformance with the rules of the Michigan Board of Land Surveyors or by a Decree of a
 Court of Law, established, re-established, monumented, re-monumented, recovered, found as
 expressed below:

NOTE: Not more than 4 corners, all in the same town and range, may be recorded
 on this certificate.

A. Description of original monument and accessories and/or subsequent restoration:
No corner set in original government survey.

B. Description of corner evidence found and/or method applied in restoring or reestablishing corner:

No evidence at corner.

Established P.C. line and right-of-way lines using found stone curbs, sidewalks, buildings.
 Established centerline of Gratiot using City of Detroit Survey monuments (Drawing No. S-455).
 Placed Wayne County Remonumentation marker and plastic cap #30081 on 1/2" X 18" iron within
 a monument box.

C. Description of monument for corner and accessories established to perpetuate locating the position of the corner:



Wayne County Remonumentation marker and plastic cap #30081 on 18" iron within a monument box.

Witnesses

- Set Masonry nail with W.C.R. tag in walk @ SW cor. Chene and Gratiot 8.35'
to centerline light pole and 5.85' to centerline GV and W. and 13.75' to Hyd. 100°AZ. - 101.41'
- Set Masonry nail with W.C.R. tag @ NW cor. Chene and Gratiot in walk 4.9'
and 14.35 to centerline storm manhole in walk. 306°AZ. - 55.04'
- Set Masonry nail with W.C.R. tag in walk @ NE cor. of Chene and Gratiot
6.9 to centerline light pole and 10.64' to cor. of building #260 Gratiot. 7°AZ. - 110.28'
- Set Masonry nail with W.C.R. tag @ SE cor. Chene and Gratiot in walk 9.1'
to centerline light pole and 20' to centerline of traffic control box. 117°AZ. - 51.93'
- The selected location for this Property Controlling Monument is accepted
as a careful and faithful determination of position as indicated.

Signed by Martin C. DunnDate 11/17/93Surveyor's Michigan License No. 30081

FORM APPROVED BY MICHIGAN STATE BOARD OF LAND SURVEYORS, JAN. 28, 1971
 REVISED MAY 14, 1975
 REVISED JAN., 1983

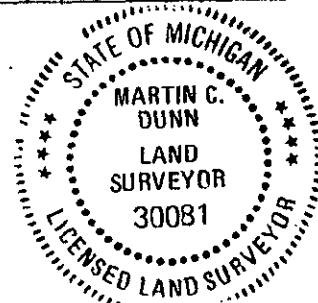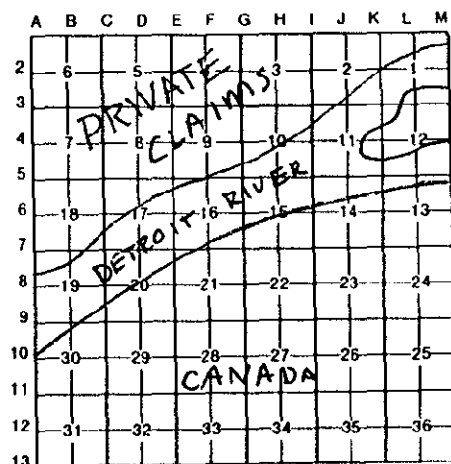

33 NOV 30 PM 1:28
 FOREST E. JUNGEL
 REGISTER OF DEEDS
 WAYNE COUNTY, MI