\$ 10.00 DEED

LAND CORNER RECORDATION CERTIFICA TEDEC 96 8:29 A.M. RECORDED Filing Requirement of Act 74, Mich. P.A. 1970

For corners in		OTHER	FUREST	Ε,			.000. COU			ER		EI):	ì
WAYNE	Located In:	-Corner Code #					4,22.						
(County)	City of Detroit	#24											
1. Public Land Survey	T_2S_R_12E_ TR_ TR	Protracted Location	Compliance with ACT 345, P.A. 1990 APPROVED ON: 12-13-1996 WAYNE COUNTY REMONUMENTATION PEER GROUP COMMITTEE Register of Deeds Stamp & File Number										
2. Property Controlling S_ in Section S_ S_ S_ Property in Sec. S_	T R T R T R												
4. Lot No, Recorded	d Plat ommon to P.C. 22 an	nd 248		<u>A</u>	В	C I	D E	F	G	н і	<u> </u>	<u>к</u> !	_ 누
Brainard St., East of Trumbull				3	- - -	- Î		9 _		10	- 1 - -11		12-
I, George M. Platz , in a field survey on December 3 , 19 96 , do hereby certify that under requirements of P.A. 74, Michigan P.A. of 1970, the corner points mentioned in lines 1 and 2 above were in conformance with regulations and rules therefore as required in the current manual of survey instructions of the United States Department of the Interior, Bureau of Land Management or by a decree of a Court of Law and /or that the corner points				3 -	18-	17	7	-16-	-	1	14 		13-
mentioned in lines 3, 4 and 5 above w	ere in conformance with the	rules of the Michigan Board of	1	<u>'</u>	+-	$\vdash \vdash$	-	- -	+-	\vdash	\dashv	+	+

A. Description of original monument and accessories and/or subsequent restoration: Line Common to P.C. 22 and P.C. 248

NOTE: Not more that 4 comers, all in the same town and range, may be recorded

re-monumented, recovered, found as expressed below:

on this certificate.

City of Detroit

The western line of P.C. 248 was originally surveyed as one tract of land in 1810. The eastern line of P.C. 22 was originally surveyed in two separate tracts of land, the first in the year 1810 and the second most likely in 1829 (see research dossier for sketch and notes) Posts were originally set at the corners only and no line stakes are called out. Many subdivisions have been platted adjacent to this line. The City of Detroit Survey Section h assembled and maintained their "Cartographical Maps" from record plat data and field work. These maps have been relied upon for a great number of years and are considered the best assembled collection of written evidence available. To the best of my knowledge, there has never been any subsequent restoration of this line, excepting the plats which were done lon ago.

B. Description of corner evidence found and/or method applied in restoring or reestablishing corner: Line Common to P.C. 22 and P.C. 248

When analyzing the record information (plats, City of Detroit Cartographical Maps) it can be seen that this line common to P.C. 22 and P.C. 248 is not delineated by actual dimensio in the subdivided land. It appears that this line has had minimal effect on past development because of this (see research dossier). Considering this important fact, I ha established this P.C. line at record dimension (384.12') westerly of the line common to P. line 248 and 24 at the southern end of P.C. 248 along Jefferson Avenue and at record dimension (384.12') westerly of the line common to P.C. line 248 and 24 at the approximate "Rear Line of the Front Concession". The remaining portion of this line has not yet been determined. The specific points held as good and the relationship of the other various points field measured are labeled in the research dossier.

- C. Description of monument for corner and accessories established to perpetuate locating the position of the corner: Line Common to P.C. 22 and P.C. 248 -- See sketch on back of this sheet
 - (B) Set 4"x 36" concrete monument w/aluminum disk stamped "WAYNE COUNTY REMONUMENTATION, SPALDING-DEDECKER, PS 38121" in a monument box in a paved road, located approximately 10 north of the centerline of Brainard Street, approximately 115' east of the centerline of Trumbull Ave. The location of this property controlling monument is accepted as a caref and faithful determination of this Private Claim line based upon all knowngevidence.

 Az. 65° 49.77'; Set P.K. nail w/WCR tag in SE face of utility pole of Michigan 101° 61 151. WE brick corner of church

Az. 101°

66.30'; Set P.K. nail w/WCR tag in conc. at the NE corner of the chur Az. 215°

Signed by


Surveyor's Michigan License No

Date

SURVEYOR No. 38121

THOVED BY MICHIGAN STATE BOARD OF LAND BURYE

Spalding - DeDecker & Assoc. SM 93-57, SM 94-44, SM 95-28, & SM 96-99

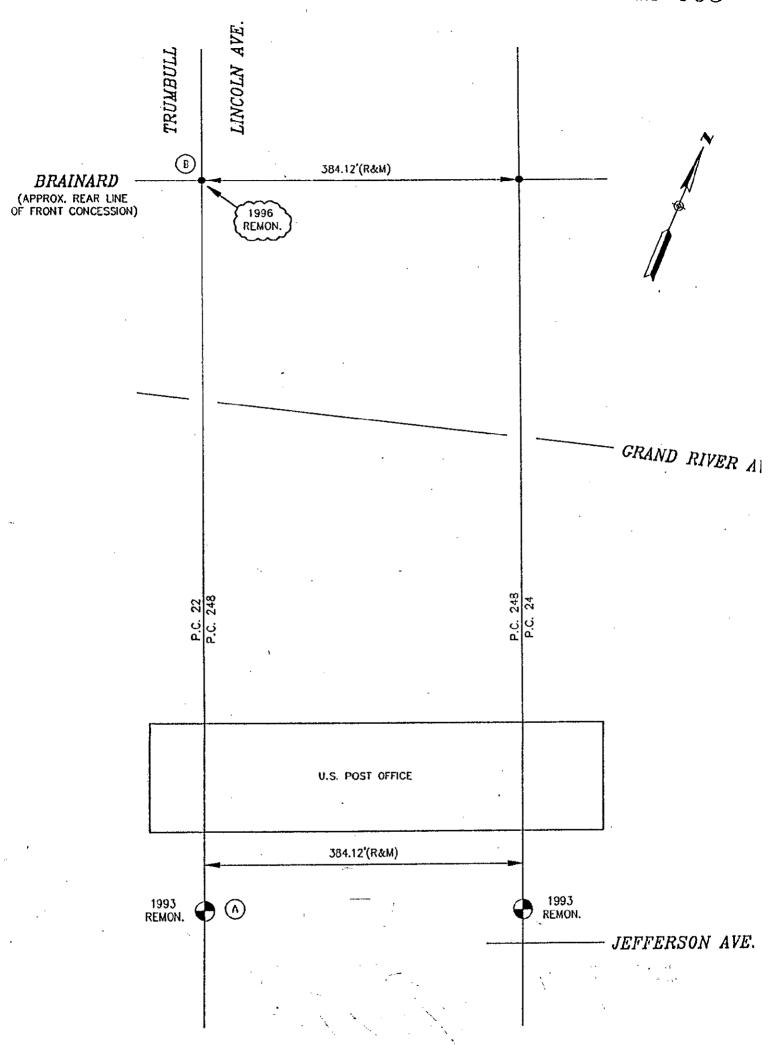

DETROIT RIVER