

FILE DO NOT MAIL

LAND CORNER RECORDATION CERTIFICATE
 Filing Requirement of Act 74, Mich. P.A. 1970

SURVEY & REMONUMENTATION

For corners in

Wayne, Van Buren Twp.
 (County)

Located in:

Corner Code #

1. Public Land Survey

T 3S. R 8E. K-6
 T ___ R ___
 T ___ R ___
 T ___ R ___

2. Property Controlling in Section

S ___ T ___ R ___
 S ___ T ___ R ___
 S ___ T ___ R ___
 S ___ T ___ R ___

3. Miscellaneous Property in Sec.

4. Lot No. _____, Recorded Plat _____
 5. Private Claims _____

MAR 17 1998

SECTION
 Compliance with
 ACT 345, P.A. 1990

APPROVED ON: 12-9-97 *JPJ*
 WAYNE COUNTY REMONUMENTATION
 PEER GROUP COMMITTEE

Register of Deeds Stamp & File Number

A	B	C	D	E	F	G	H	I	J	K	L	M
1												
2	6	5	4	3	2	1						
3												
4	7	8	9	10	11	12						
5												
6	18	17	16	15	14	13						
7												
8	19	20	21	22	23	24						
9												
10	FOREST E. YOUNGBLOOD, REGISTER OF DEEDS WAYNE COUNTY, MI											
11	Receipt #42670											
12	31	32	33	34	35	36						
13	144.00 REMONUMENTATION											

I, William L. Roskelly, in a field survey on Nov 18, 19 97 do hereby state that under requirements of P.A. 74, Michigan P.A. of 1970, the corner points mentioned in lines 1 and 2 above were in conformance with regulations and rules therefore as required in the current manual of survey instructions of the United States Department of the Interior, Bureau of Land Management or by a decree of a Court of Law and/or that the corner points mentioned in lines 3, 4 and 5 above were in conformance with the rules of the Michigan Board of Land Surveyors or by a Decree of a Court of Law; established, re-established, monumented, recovered, found as expressed below:

NOTE: Not more than 2 corners, all in the same town and range, may be recorded on this certificate.

A. Description of original monument and accessories and/or subsequent restoration:


K-6 West corner section 13, T.3 S., R.8 E., Van Buren Township

G.L.O. (1816) J. Wampler set corner post, witnesses: WO 40N 87W105 (gone), W.C.R.C. (6/2/70) E. Johns found a monument in a box, witnesses: N.E. 71.70 SW corner of house #10385 (gone), S.W. 64.85' nail in a DE pole (gone), N.W. 82.78' nail in a DE pole (gone), William G. Carlson 12/18/71 found a 1/2" dia. iron bar in a monument box, witnesses: S 59° W 61.15' PK nail in Ed. pole (gone), N 38° W 86.80' to a PK nail in an Ed. Pole (gone), N 83° E 60.25' to a PK in a 10" tree (gone). Howard W. Taft 12/19/74 found a monument, witnesses: N 60° W 85.90' NE corner garage (gone), N 45° W 87.40' utility pole (gone), N. 70° W. 74.20' SE corner garage (gone).

B. Description of corner evidence found and/or method applied in restoring or reestablishing corner:

K-6 West corner section 11, T.3 S., R.8 E., Van Buren Township

Found an iron pipe in concrete in a monument box at Haggerty road (asphalt).
 Verified the corner location by comparing field measurements with W.P.A. survey:
 Distance K-6 to K-5 Record = 2692.92', Measured = 2692.89'
 Distance K-6 to K-7 Record = 2657.16', Measured = 2656.82'
 Angle line K-6 & K-5 to K-6 & K-7 Record = 180° 08' 00", Measured = 180° 08' 49"

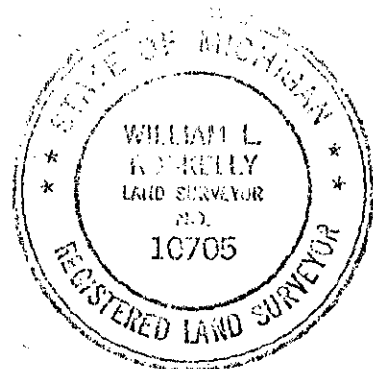

C. Description of monument for corner and accessories established to perpetuate locating the position of the corner:

K-6 West corner section 11, T.3 S., R.8 E., Van Buren Township

Found an iron pipe in concrete in a monument box at Haggerty road (asphalt).
 The selected location is accepted by the contractor and is generally accepted by professional surveyors as the best available evidence of the position of the corner.
 WITNESSES: Due North 6.05' found steel cased concrete monument in mon. box, N. 79° E. 71.54' SW house corner hse. #10385, N. 85° E. 71.54' set nail WCR tag south face 18" Crab Apple, Due east 60.01' found steel bar & cap #19836, S. 50° W. 77.14' found conc. mon. steel bar SE corner lot 1 Van Buren Est., S. 63° W. 61.47' set nail WCR tag N. face DE pole, S. 63° W. 61.50' found a nail N. face DE pole, N. 30° W. 87.61' found a P.K. nail & WCRC tag NE face DE pole.
 Placed PK nail and Wayne County Remonumentation tag and B&S tag #10705.

Signed by William L. Roskelly
 Surveyor's Michigan License No. 10705

Date 12-14-97