

SURVEY & REMONUMENTATION

RC 1580

LI27800PA079

APR 25 1995

LAND CORNER RECORDATION CERTIFICATE Filing Requirement of Act 74, Mich. P.A. 1970

16.00 MISCELLANEOUS RECORDING
28 DEC 94 8:24 A.M. RECEIVED
RECORDED
FOREST E. YOUNG CO. - REGISTER OF DEEDS
WAYNE COUNTY, MI

For corners in **COMMISSION**

Wayne (County)	Located In:	Corner Code #
1. Public Land Survey	T 3 S R 8 E	M-5
	T R	
	T R	
	T R	
2. Property Controlling In Section	S T R	
	S T R	
3. Miscellaneous Property in Sec.	S T R	
	S T R	
4. Lot No. _____, Recorded Plat _____		
5. Private Claims _____		

Compliance with
ACT 345, P.A. 1990
APPROVED ON: 12-8-94
WAYNE COUNTY REMONUMENTATION
PEER GROUP COMMITTEE

Register of Deeds Stamp & File Number

RC 1580

I, William L Roskelly, in a field survey on November 1, 19 94, do hereby certify that under requirements of P.A. 74, Michigan P.A. of 1970, the corner points mentioned in lines 1 and 2 above were in conformance with regulations and rules therefore as required in the current manual of survey instructions of the United States Department of the Interior, Bureau of Land Management or by a decree of a Court of Law and/or that the corner points mentioned in lines 3, 4 and 5 above were in conformance with the rules of the Michigan Board of Land Surveyors or by a Decree of a Court of Law; established, re-established, monumented, re-monumented, recovered, found as expressed below:

NOTE: Not more than 4 corners, all in the same town and range, may be recorded on this certificate.

	A	B	C	D	E	F	G	H	I	J	K	L	M
2	6	5	4	3	2	1							
3													
4	7	8	9	10	11	12							
5													
6	18	17	16	15	14	13							
7													
8	19	20	21	22	23	24							
9													
10	30	29	28	27	26	25							
11													
12	31	32	33	34	35	36							
13													

A. Description of original monument and accessories and/or subsequent restoration:

M-5) Southeast Corner Section 12 Common to Section 13 T.3 S., R.8 E.

G.L.O. (1830's) J. Wampler set corner, witnesses a B. 024 N11 W81 (gone) aW 02 OS.31 E46 (gone) W.P.A. (1930's) set an iron, witnesses: S.W. 30.51 5" triple Cherry (gone), S.W. 60.35 Wild Cherry (gone), S.E. 71.58 Telephone pole (gone), N.E. 33.85 14" Wild Cherry (gone), N. 992 ± iron (not located)
Wayne County Road Comm. 6/2/70 E. Johns found a steel post with punch mark in mon. box, witnesses: N.W. 34.19 M.B.T. pole (measured=34.24), S.W. 3.01 P.K. nail in A/C (gone), S.W. 3.0 P.K. nail in A/C (gone), N.E. 39.92 M.B.T. pole (gone).

(continued to page 2)

B. Description of corner evidence found and/or method applied in restoring or reestablishing corner:

M-5) Southeast Corner Section 12 Common to Section 13 T.3 S., R.8 E.

Found a 1" steel bar flat top in a monument box in the centerline of Hannan Road. Corner location supported by comparing W.P.A. survey with field measurements:
M-5 to M-6 W.P.A. = 2658.59 Measured = 2652.81 Angle M-6 sight M-7 to M-6 turn to M-5 W.P.A. = 179 57' 20" Measured = 179 58' 00"
Corner also supported by Wayne County Road Comm. 6/2/70 W.C.R.C. tag and nail N. 70 W. recorded = 34.15, measured 34.24 C.S. L. 19897, P. 551 Roskelly, Jakobson & Assoc. 9/14/77 W.C.R.C. tag and nail N. 75 W. recorded = 34.15, measured 34.24.

C. Description of monument for corner and accessories established to perpetuate locating the position of the corner:

M-5) Southeast Corner Section 12 Common to Section 13 T.3 S., R.8 E.

Found a 1" steel bar flat top in a monument box in the centerline of Hannan Road. The selected location is accepted by the Contractor and is generally accepted by professional surveyors as the best available evidence of the position of the original corner.
Witnesses:

Top bolt hydrant N.20° E. Dist. = 140.25

North line of house #9440 due South Dist. = 168.65

Set nail & tag W.C.R. S.E. face 6" Maple S.50° W. Dist. = 70.02

Set nail & tag W.C.R. N. face P. pole N.70° W. Dist. = 34.24


Placed Wayne County Remonumentation brass marker stamped with #10705

Signed by William L Roskelly

Date 12/27/94

Surveyor's Michigan License No. 10705

Page 1 of 2 pages

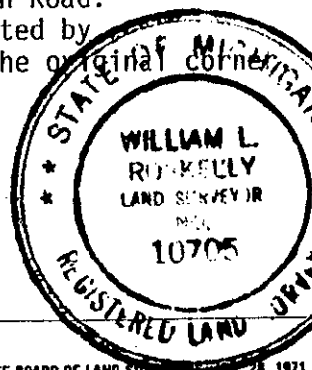

FORM APPROVED BY MICHIGAN STATE BOARD OF LAND SURVEYORS, JAN. 28, 1971
REVISED MAY 14, 1975
REVISED JAN., 1983

2R
14 D
MISC

LAND CORNER RECORDATION CERTIFICATE
Filing Requirement of Act 74, Mich. P.A. 1970

L127800PA080

For corners in

Wayne
(County)

Located In:

Corner Code ~~##~~

1. Public Land Survey

T 3 S R 8 E

M-5

T R

T R

T R

T R

2. Property Controlling
in Section

S T R

S T R

3. Miscellaneous

S T R

Property in Sec.

S T R

4. Lot No. , Recorded Plat

5. Private Claims

I, William L. Roskelly in a field survey on November 1, 1994, do hereby certify that under requirements of P.A. 74, Michigan P.A. of 1970, the corner points mentioned in lines 1 and 2 above were in conformance with regulations and rules therefore as required in the current manual of survey instructions of the United States Department of the Interior, Bureau of Land Management or by a decree of a Court of Law and/or that the corner points mentioned in lines 3, 4 and 5 above were in conformance with the rules of the Michigan Board of Land Surveyors or by a Decree of a Court of Law; established, re-established, monumented, re-monumented, recovered, found as expressed below:

NOTE: Not more than 4 corners, all in the same town and range, may be recorded on this certificate.

A. Description of original monument and accessories and/or subsequent restoration:
(continued from page 1)

C.S. L. 19897, P. 551 Roskelly, Jekabson & Assoc. 9/14/77 found a 1" steel bar in mon. box witnesses: N.40 E. 40.00 nail in 10" Hawthorne (gone), N.75 W. 34.15 nail in M.B.T. pole (measured = 34.24), P.K. nail on centerline Northerly 609.35 (not found), N.20 E. 92.95 Road sign (gone).
No R.C. found on file at Wayne County Reg. of Deeds.

B. Description of corner evidence found and/or method applied in restoring or reestablishing corner:

C. Description of monument for corner and accessories established to perpetuate locating the position of the corner:

Signed by


William L. Roskelly

Date

12/27/94

Surveyor's Michigan License No.

10705

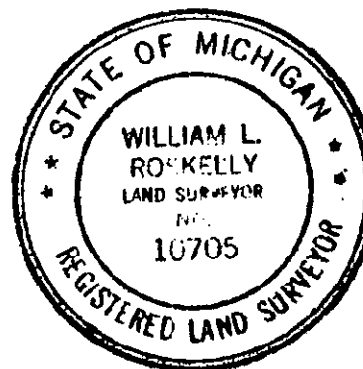

FORM APPROVED BY MICHIGAN STATE BOARD OF LAND SURVEYORS, JAN. 26, 1971
REVISED MAY 14, 1975
REVISED JAN., 1983