

APR 05 1996

LAND CORNER RECORDATION CERTIFICATE  
Filing Requirement of Act 74, Mich. P.A. 1970

\$ 4.00 REMONUMENTATION  
\$ 7.00 DEED  
7 DEC 95 11:03 A.M. RECEIPT  
RECORDED  
FOREST E. YOUNGLOOD, REGISTER  
WAYNE COUNTY, MI

For corners in COMMISSION

<u>WAYNE</u> (County)	Located in: CITY OF SOUTHGATE (TAYLOR TOWNSHIP) #14	Corner Code # <u>L-13</u>
1. Public Land Survey	T3S R10E	
	T R	
	T R	
	T R	
2. Property Controlling In Section	S T R	
	S T R	
3. Miscellaneous Property in Sec.	S T R	
	S T R	
4. Lot No. _____, Recorded Plat _____		
5. Private Claims _____		

Compliance with  
ACT 345, P.A. 1990  
APPROVED ON: 12-4-95  
WAYNE COUNTY REMONUMENTATION  
PEER GROUP COMMITTEE  
Register of Deeds Stamp & File Number

I, WALTER J. ZBIKOWSKI, in a field survey on SEPTEMBER 15, 1995, do hereby certify that under requirements of P.A. 75, Michigan P.A. of 1970, the corner points mentioned in lines 1 and 2 above were in conformance with regulations and rules therefore as required in the current manual of survey instructions of the United States Department of the Interior, Bureau of Land Management or by a decree of a Court of Law and/or that the corner points mentioned in lines 3, 4 and 5 above were in conformance with the rules of the Michigan Board of Land Surveyors or by a Decree of a Court of Law; established, re-established, monumented, remonumented, recovered, found as expressed below.

NOTE: Not more than 4 corners, all in the same town and range, may be recorded on this certificate.


	A	B	C	D	E	F	G	H	I	J	K	L	M
2	6		5		4		3		2		1		
3													
4	7		8		9		10		11		12		
5													
6	15		17		16		15		14		13		
7													
8	19		20		21		22		23		24		
9													
10	30		29		28		27		26		25		
11													
12	31		32		33		34		35		36		
13													

A. Description of original monument and accessories and/or subsequent restoration.

ORIGINAL GOVERNMENT SURVEY BY JOSEPH FLETCHER, D.S. (1815-1817)  
G.L.O. (1815-1816) DESCRIPTION OF CORNER NOT STATED IN NOTES.  
WITNESSES: WO 12 S 87 E 18 (11.88') (GONE)  
DO 12 S 25 E 26 (17.16') (GONE)

RESURVEY AT THE DIRECTION OF ALBERT E. CHAMPNEY, DIRECTOR OF WAYNE COUNTY BUREAU OF TAXATION  
W.P.A. (1930s) IRON S36 (#159)

WITNESSES: N 33.00' IRON (GONE)  
NE 55.15' NAIL SOUTHEAST SIDE 20" APPLE (GONE)  
E 15.46' MONUMENT (MEAS. 15.42')  
SE 40.27' NAIL NORTHEAST SIDE TELEPHONE POLE (GONE)  
NW 35.26' NAIL NORTHEAST SIDE 20" ELM (GONE)

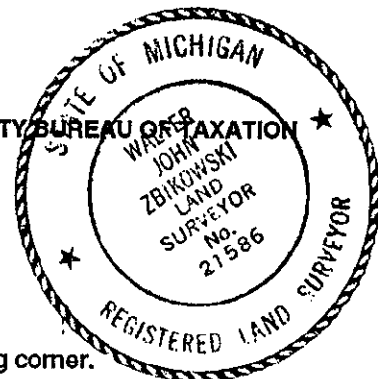

B. Description of corner evidence found and/or method applied in restoring or reestablishing corner.

DISTANCE TO K-13 MEASURED AS 2597.85'; RECORD W.P.A. (1930) DISTANCE OF 2597.95'  
DISTANCE TO M-13 MEASURED AS 2662.26'; RECORD W.P.A. (1930) DISTANCE OF 2660.96'  
L.18997 P.805 CONCRETE MONUMENT IN BOX (1974)  
N 29.02' TO SPIKE WITH BRASS TAG IN WEST SIDE OF DETROIT EDISON POLE (MEAS. 29.30')  
NE 95.19' TO SPIKE WITH BRASS TAG IN NORTHWEST SIDE OF DETROIT EDISON POLE (MEAS. 95.30')  
E 15.39' TO 3/4" IRON ROD AT NORTH 1/4 CORNER OF SEC. 1, T.4S, R.11E (MEAS. 15.42')  
SE 73.82' TO "X" CUT IN SOUTHWEST CORNER OF CONCRETE LIGHT POST BASE (MEAS. 73.83')  
SW 65.63' TO CONCRETE PROPERTY MONUMENT (MEAS. 65.57')  
NW 94.82' TO "X" CUT ON SOUTH RIM OF MANHOLE CASTING (MEAS. 94.80')

C. Description of monument for corner and accessories established to perpetuate locating the position of the corner.

L-13 SECTION CORNER SOUTH OF 36, T.3S, R.10E  
A CONCRETE MONUMENT IN A ROAD BOX AT FORDLINE AND PENNSYLVANIA ROADS, A TWO LANE ASPHALT SURFACE ROAD, AND IT IS ACCEPTED AS A CAREFUL AND FAITHFUL PERPETUATION OF THE POSITION OF THE ORIGINAL CORNER.

N.88°04'E. 29.30' FOUND SPIKE WITH BRASS TAG IN NORTHWEST SIDE OF UTILITY POLE (SUPRA)  
S.18°32'E. 95.30' FOUND SPIKE WITH BRASS TAG IN NORTHWEST SIDE OF UTILITY POLE (SUPRA)  
S.62°32'W. 73.83' FOUND "X" CUT IN SOUTHWEST CORNER OF METAL LIGHT POLE CONCRETE BASE (SUPRA)  
N.35°08'E. 94.80' FOUND "X" CUT IN SOUTH RIM OF STORM MANHOLE CASTING (SUPRA)  
EAST 15.42' FOUND 3/4" IRON ROD IN ROAD BOX (NO LID) AT NORTH 1/4 CORNER SEC. 1, T.4S, R.10E (SUPRA)

NOT A COMMON CORNER.

PLACED A REMONUMENTATION BRASS DISC AND PVC CAP #21586 ON ABOVE MONUMENT L-13 AND RESET ROAD BOX WITH LID.

Signed by Walter J. Zbikowski  
WALTER J. ZBIKOWSKI  
Surveyor's Michigan License No. 21586

Date Dec. 6, 1995

95261583

4  
7