

LAND CORNER RECORDATION CERTIFICATE

APR 05 1996 Filing Requirement of Act 74, Mich. P.A. 1970

I-05 Page 1

For corners in:	Wayne County	Located in:	Sumpter	Corner Code
1. Public Land Survey		T 4 S	R 8 E	I-05
		T	R	
		T	R	
		T	R	
2. Property Controlling in Section	S	T	R	
	S	T	R	
3. Miscellaneous Property in Sec.	S	T	R	
	S	T	R	
4. Lot No. _____, Recorded Plat _____				
5. Private Claims _____				

Compliance with ACT 345, P.A. 1990
 APPROVED ON: 11-30-95 [Signature]
 WAYNE COUNTY REMONUMENTATION PEER GROUP COMMITTEE

Register of Deeds Stamp and File Number

	A	B	C	D	E	F	G	H	I	J	K	L	M
2	6	5	4	3	2	1							
3													
4	7	8	9	10	11	12							
5													
6	18	17	16	15	14	13							
7													
8	19	20	21	22	23	24							
9													
10	30	29	28	27	26	25							
11													
12	31	32	33	34	35	36							
13													

I, Kenneth S. Wilkerson in a field survey on 06/21/1995 do hereby certify that under requirements of P.A. 74, Michigan P.A. of 1970, the corner points mentioned in lines 1 and 2 above were in conformance with regulations and rules therefore as required in the current manual of survey instructions of the United States Department of the Interior, Bureau of Land Management, or by a decree of a Court of Law and/or that the corner points mentioned in lines 3, 4 and 5 above were in conformance with the rules of the Michigan Board of Land Surveyors or by a Decree of a Court of Law, established, re-established, monumented, re-monumented, recovered, found as expressed below.


NOTE: Not more than 4 corners, all in the same town and range, may be recorded on this certificate.

A. Description of original monument and accessories and/or subsequent restorations:
 01/01/1819 Wampler G.L.O. Set post
 15" R. OAK S 80 W 21 LINKS (13.86') (GONE)
 24" W. OAK S 54 E 44 LINKS (29.04') (GONE)

(Witnesses Continued on-Back ...)

B. Description of corner evidence found and/or method applied in restoring or reestablishing corner:
 Fd. 3/4" pipe in mon. box w/ W.C.R.C. cover in asph. pvmt. @ int of cl's of Martinsville & Judd Rds. DIST TO H-5 2824.85'(R) 2824.78'(M) TO I-6 2646.06'(R) 2644.42'(M)

C. Description of monument for corner and accessories established to perpetuate locating the position of the corner:
 06/21/1995 Wilkerson 35994 O.H.M. Remon.
 SET W.C.R. WASHER & CAP ON FD. 3/4" PIPE
 1 W.C.R TAG W/NAIL S.E./S P.P. N 30 E 75.98'
 4 N.W. COR. HSE. S.E. 78.43
 5 N.E. COR. HSE.(WAS A SCHOOL) S.W. 94.74
 7 W.C.R. TAG W/PK. NAIL S./S P.P. N 40 W 46.09'
 8 TOP BOLT ON HYDRANT S 60 W 58.82'

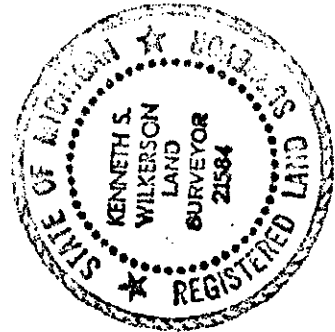

95273115

"We conclude that after careful study of the record documentation and field observations, that this corner is accepted as the best available evidence of the position of the original corner."

Signed by [Signature]
 Drafted by Kenneth S. Wilkerson
 Surveyor's Michigan License No. 21584
 Orchard, Hiltz and McCliment, Inc. 34935 Schoolcraft Road Livonia, MI 48150

Date DEC 8 1995

\$ 4.00 REMONUMENTATION
 21 DEC 95 9:18 A.M. RECEIPT# 58
 RECORDED
 FOREST E. YOUNGBLOOD, REGISTER OF DEEDS
 WAYNE COUNTY, MI
 \$ 10.00 DEED
 \$ 10.00 DEED

AK
100
125

A. (Continued) Description of original monument and accessories and/or subsequent restorations:

01/01/1930		Wayne Co. Bureau of Taxation		Iron
	1	ED. POLE N.E. 75.60'		
	2	W.C.R. SIGN POST N.E. 50.39' (GONE)		
	3	ED. POLE S.E. 44.90' (GONE)		
	4	NW COR. OF HOUSE S.E. 78.58'		
	5	NE COR. OF SCHOOL S.W. 94.73'		
	6	24" PINE S.W. 66.75' (GONE)		
	11	DIST = 2646.06' TO I-06		
	12	DIST = 2824.65' TO H-05		
	13	DIST = 2644.68' TO I-04		
	14	DIST = 2679.92' TO J-05		
06/15/1970		Johns	W.C.R.C.	Iron
	3	ED. POLE S.E. 44.71' (GONE)		
	5	NE COR. OF SCHOOL S.W. 94.73'		
	7	M.B.T. POLE N.W. 46.65'		
	8	TOP CENTER OF F. HYD. S.W. 58.33'		
09/09/1974		Crossman	9428	Fd. iron pipe
	1	ED. POLE NAIL & CAP SE SIDE OF DE POLE N 30 E 75.9		
	3	ED. POLE S 45 E 44.70' (GONE)		
	7	NAIL & CAP SW SIDE M.B.T. POLE N 40 W. 46.62'		
	8	TOP CENTER OF F. HYD. S 70 W 58.89'		
07/31/1979		Roskelly	18663	Certified Survey
	1	NAIL IN DE POLE N 30 E 75.93'		
	3	ED. POLE S 45 E 44.70'		
	5	NE COR. OLD SCHOOL S 40 W 94.75'		
	7	NAIL IN M.B.T. POLE N 45 W. 46.60'		
01/29/1986		Pitts	10702	R.C.8
	3	NAIL W/WASHER SW SIDE D.E. POLE S.E. 44.68'		
	5	BUILD. COR. S.W. 94.72'		
	7	SPIKE SW SIDE M.B.T. POLE N.W. 46.62'		
	8	TOP CENTER OF HYD. S.W. 58.91'		
04/14/1986		Raines	14981	R.C.8
	1	P.K. NAIL IN S SIDE OF DE POLE N 23 E 75.28'		
	3	P.K. NAIL IN N SIDE OF DE POLE S 40 E 44.30' (GONE)		
	7	CENTER OF F. HYD. S 60 W 59.00'		
	8	P.K. NAIL IN S SIDE OF M.B.T. POLE N 40 W 46.07'		
03/06/1990		Blanchard	27446	Certified Survey

NO WITNESSES

LIBER 28477 PAGE 199

FILED DO NOT MAIL