

MAY 10 2000

SECTION

LAND CORNER RECORDATION CERTIFICATE
Filing Requirement of Act 74, Mich. P.A. 1970

For corners in

WEXFORD
(County)

Located In:

Corner Code #

1. Public Land Survey T 21N R 9W K-12
T R
T R
T R
2. Property Controlling S T R
in Section S T R
3. Miscellaneous S T R
Property in Sec. S T R

4. Lot No. , Recorded Plat
5. Private Claims

I, CRAIG J. PULLEN, PS, in a field survey on AUGUST 13,
1999, do hereby state that under requirements of P.A. 74, Michigan P.A. of 1970, the corner
points mentioned in lines 1 and 2 above were in conformance with regulations and rules therefore
as required in the current manual of survey instructions of the United States Department of the
Interior, Bureau of Land Management or by a decree of a Court of Law and/or that the corner points
mentioned in lines 3, 4 and 5 above were in conformance with the rules of the Michigan Board of
Land Surveyors or by a Decree of a Court of Law; established, re-established, monumented,
recovered, found as expressed below:

NOTE: Not more than 2 corners, all in the same town and range, may be recorded on
this certificate.

A. Description of original monument and accessories and/or subsequent restoration:

- K-12 1848 G.L.O. RESURVEY BY O. LYON, WOOD POST, BEECH 10 N36E 28, BEECH 10 S31 1/2 W 19
1893 DEVOE (PER TEED) SURVEY IN SECTION 35 POST (CROCKERY & STONE)
1894 A. J. TEED SURVEY IN SECTION 35 FOUND CORNER SET BY DEVOE IN 1893
1899 D. E. TEED SURVEY IN SECTION 36 MAPLE 8 N47E 44 1/2, MAPLE 6 S26W 73
1901 D. E. TEED SURVEY IN SECTION 35 NO WITNESSES
1996 DANIEL E. SCHRIPEMA PS#24617 SURVEY IN SECTION 35 FOUND 1/2" IRON, S57°W 82.29' 12" SPRUCE, EAST
47.29' 18" MAPLE CLUMP, N70°E 47.98' 10" MAPLE, N48°E 58.62' 22" MAPLE

B. Description of corner evidence found and/or method applied in restoring or reestablishing corner:


- K-12 FOUND 1/2" X 18" IRON 0.5' EAST OF CENTERLINE 47 ROAD AND IN LINE WITH PLOWED FIELD WEST AND TREE LINE
EAST. REPLACED WITH 5/8" X 36" IRON AND BRASS CAP. THIS CORNER IS ACCEPTED AS THE BEST AVAILABLE
EVIDENCE OF THE POSITION OF THE CORNER.

C. Description of monument for corner and accessories established to perpetuate locating the position of the corner:

- K-12 1/4 CORNER COMMON TO SECTIONS 35 & 36, T21N, R9W
5/8"X36" IRON & BRASS CAP STAMPED: CJP, 39095, 1999, 1/4, 35, 36
N45°E 20" MAPLE 58.63'
S87°E 20" TRIPLE MAPLE 47.19'
S19°E 14" TRIPLE ELM 64.12'
S52°W 14" SPRUCE 82.17'

Peer Group Reviewed and Approved

Date: 12 Nov 99
Richard D. Wilcox
Richard D. Wilcox, Wexford County Surveyor

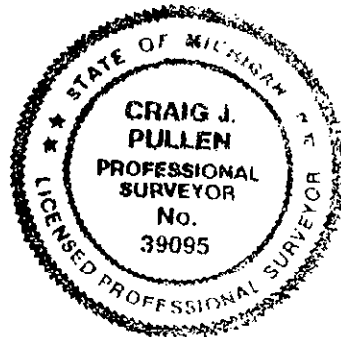

RECEIVED

1999 DEC -3 PM 12: 44

Linda Loughmiller
WEXFORD COUNTY, MI
REGISTER OF DEEDS

Register of Deeds Stamp & File Number

1	A	B	C	D	E	F	G	H	I	J	K	L	M
2		6		5		4		3		2		1	
3													
4		7		8		9		10		11		12	
5													
6		18		17		16		15		14		13	
7													
8		19		20		21		22		23		24	
9													
10		30		29		28		27		26		25	
11													
12		31		32		33		34		35		36	
13													

Signed by Craig J. Pullen

Date October 21, 1999

Surveyor's Michigan License No. 39095

FORM APPROVED BY MICHIGAN STATE BOARD OF PROFESSIONAL SURVEYORS, JAN. 28, 1971

REVISED MAY 14, 1975

REVISED JAN., 1983

REVISED OCT., 1995