

RECEIVED

NOV 13 PM 4: 27

JAN 17 1996

LAND CORNER RECORDATION CERTIFICATE
Filing Requirement of Act 74, Mich. P.A. 1970

For corners in
WEXFORD

COMMISSION

(County)

Located In:

Corner Code =#

Linda Loughmiller
WEXFORD COUNTY, MI
REGISTER OF DEEDS

- | | | | | | |
|------------------------------------|---|-----|---|-----|------|
| 1. Public Land Survey | T | 21N | R | 11W | M-10 |
| | T | | R | | |
| | T | | R | | |
| | T | | R | | |
| 2. Property Controlling in Section | S | T | R | | |
| | S | T | R | | |
| 3. Miscellaneous | S | T | R | | |
| Property in Sec. | S | T | R | | |

Register of Deeds Stamp & File Number

4. Lot No. _____, Recorded Plat _____
5. Private Claims _____

	A	B	C	D	E	F	G	H	I	J	K	L	M
2	6		5		4		3		2		1		
3													
4	7		8		9		10		11		12		
5													
6	18		17		16		15		14		13		
7													
8	19		20		21		22		23		24		
9													
10	30		29		28		27		26		25		
11													
12	31		32		33		34		35		36		
13													

I, CRAIG J. PULLEN, in a field survey on SEPTEMBER 16, 1995, do hereby certify that under requirements of P.A. 74, Michigan P.A. of 1970, the corner points mentioned in lines 1 and 2 above were in conformance with regulations and rules therefore as required in the current manual of survey instructions of the United States Department of the Interior, Bureau of Land Management or by a decree of a Court of Law and/or that the corner points mentioned in lines 3, 4 and 5 above were in conformance with the rules of the Michigan Board of Land Surveyors or by a Decree of a Court of Law; established, re-established, monumented, re-monumented, recovered, found as expressed below:

NOTE: Not more than 4 corners, all in the same town and range, may be recorded on this certificate.

A. Description of original monument and accessories and/or subsequent restoration:

- M-10 1837 GLO SURVEY BY J. BRINK, WOOD POST HEM 10 S20½W 54 BLACK ASH 10 N52½W 41
- 1895 A.J. TEED SURVEY IN SEC.25, T21N, R11W FOUND BY ONE WITNESS - OK - SET GOOD STAKE. NO WITNESSES GIVEN.
- 1970 USFS SURVEY BY R. GRIFFIN, PS #13584 L.C.R.C. L.1, P.232 INTERSECTED THE CENTERLINES OF THE OLD ROADS N-S-E & W. THIS POINT OF INTERSECTION CHECKS WELL WITH THE SMALL STREAM (GLO - 50 LKS NORTH OF CORNER) AND THE RECOVERED NE CORNER OF SECTION 25, T21N, R11W. BASED ON THE ABOVE EVIDENCE, I PRESUME THIS TO BE A RECOVERED CORNER.
- SET 5" X 36" CONCRETE MONUMENT WITH BRASS CAP 60 PENNY SPIKE AND BRASS TAG IN P. POLE S33°E 76.80' 10" DOCK SPIKE MAPLE 11" S22°W 148.34' 10" DOCK SPIKE CHERRY 16" S72°W 105.96'

B. Description of corner evidence found and/or method applied in restoring or reestablishing corner:



- M-10 FOUND USFS MONUMENT AND ALL 3 WITNESSES FROM 1970, ALTHOUGH THE CHERRY TREE HAD NO SPIKE IN IT. THIS CORNER IS ACCEPTED AS A CAREFUL AND FAITHFUL RE-ESTABLISHMENT OF THE POSITION OF THE ORIGINAL CORNER, BEING THE ¼ CORNER COMMON TO SECTION 25, T21N, R11W, AND SECTION 30, T21N, R10W.

Peer Group Reviewed and Approved

Date: 10 Nov 95
Richard D. Wilcox
Richard D. Wilcox, Wexford County Surveyor

C. Description of monument for corner and accessories established to perpetuate locating the position of the corner:

- M-10 EAST ¼ CORNER, SECTION 25, T21N, R11W
- 5" X 36" CONCRETE MONUMENT WITH BRASS CAP
- S33°E CUT OFF POWER POLE 76.80'
- S60°W 6" WHITE PINE 97.43'
- S22°W 10" DOCK SPIKE IN 20" MAPLE 148.34'
- S49°E 6" TRI-MAPLE 45.91'

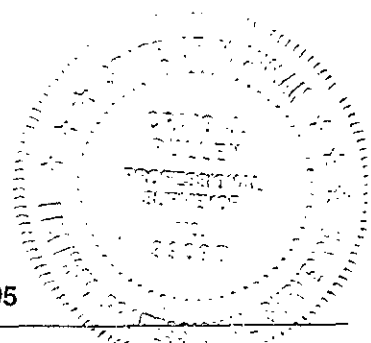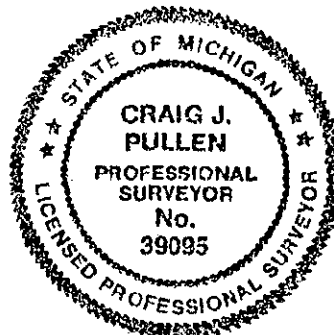

Signed by Craig J. Pullen Date NOVEMBER 9, 1995

Surveyor's Michigan License No. 39095

LIBER 04 PAGE 367