

COMMISSION

JAN 17 1996

LAND CORNER RECORDATION CERTIFICATE
COMMISSION
Filing Requirement of Act 74, Mich. P.A. 1970

RECEIVED

1995 DEC 14 PM 3:50

Linda Longmiller
 WEXFORD COUNTY, MI
 REGISTER OF DEEDS

For corners in

Wexford
 (County)

Located In:

Corner Code #

- | | | |
|------------------------------------|---------------------------|------------|
| 1. Public Land Survey | T <u>22N</u> R <u>11W</u> | <u>M-4</u> |
| | T _____ R _____ | _____ |
| | T _____ R _____ | _____ |
| | T _____ R _____ | _____ |
| 2. Property Controlling in Section | S _____ T _____ R _____ | _____ |
| | S _____ T _____ R _____ | _____ |
| 3. Miscellaneous Property in Sec. | S _____ T _____ R _____ | _____ |
| | S _____ T _____ R _____ | _____ |

Register of Deeds Stamp & File Number

4. Lot No. _____, Recorded Plat _____
5. Private Claims _____

	A	B	C	D	E	F	G	H	I	J	K	L	M
2	6	5	4	3	2	1							
3													
4	7	8	9	10	11	12							
5													
6	18	17	16	15	14	13							
7													
8	19	20	21	22	23	24							
9													
10	30	29	28	27	26	25							
11													
12	31	32	33	34	35	36							
13													

I, George D. Smith, in a field survey on December 11, 19 95, do hereby certify that under requirements of P.A. 74, Michigan P.A. of 1970, the corner points mentioned in lines 1 and 2 above were in conformance with regulations and rules therefore as required in the current manual of survey instructions of the United States Department of the Interior, Bureau of Land Management or by a decree of a Court of Law and/or that the corner points mentioned in lines 3, 4 and 5 above were in conformance with the rules of the Michigan Board of Land Surveyors or by a Decree of a Court of Law; established, re-established, monumented, re-monumented, recovered, found as expressed below:

NOTE: Not more than 4 corners, all in the same town and range, may be recorded on this certificate.

A. Description of original monument and accessories and/or subsequent restoration:

1837 GLO Quarter Section post by John Brink, Deputy Surveyor, Sugar 8 S 70½° W 36, Sugar 8 N 13°W23

B. Description of corner evidence found and/or method applied in restoring or reestablishing corner:


Set 5/8" x 30" iron with Wexford County brass cap stamped: E 1/4 12, 1995 PS #39098 by single proportionate measure between found Northeast corner Section 12 and found Southeast corner Section 12, T23N, R11W and at midpoint of North-South ROW fences to East and West. This corner is accepted as a careful and faithful re-establishment of the position of the original corner, being the 1/4 corner common to Section 12, T22N, R11W and Section 7, T22N, R10W.

Peer Group Reviewed and Approved

Date: 18 Dec 95
Richard D. Wilcox
 Richard D. Wilcox, Wexford County Surveyor

C. Description of monument for corner and accessories established to perpetuate locating the position of the corner:

5/8" x 30" iron with Wexford County brass cap ±2' West centerline road North-South, ±16' S'y of fence line West.
 12" Twin Elm North 112.19'
 Power pole N 20°E 93.14'
 4" Steel corner fence post (filed "x" on post) N 65°W 48.90'
 5" Elm S 68° W 50.28'
 R.O.W. fences to East and West ±33'

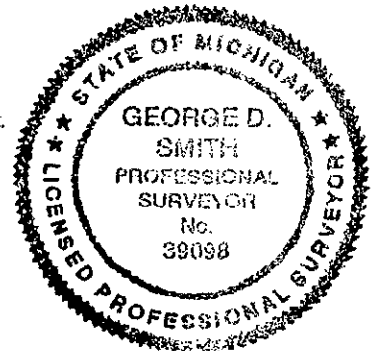

Signed by George D. Smith
 Surveyor's Michigan License No. 39098

Date 12-14-95