

LAND CORNER RECORDATION CERTIFICATE
FILING REQUIREMENT OF ACT 74, MICH. P.A.1970

FOR CORNERS OF--:	LOCATED IN--:	CORNER CODE NUMBER
1. PUBLIC LAND SURVEY	T. 24 N. R. 10	I-7; I-8; I-9
2. PROPERTY CONTROLLING IN SECTION 22	T. 24 N. R. 10	16
3. MISCELLANEOUS PROPERTY IN SECTION	T. S. R. E. W.	
4. LOT NO.	RECORDED PLAT	
5. PRIVATE CLAIMS		

REGISTER OF DEEDS STAMP AND
FILING NUMBER

I, Carl F. Roser, do hereby certify that under requirements of P.A. 74, Michigan P.A. of 1970, the corner points mentioned in lines 1 and 2 above were, in a field survey on August 18, 1976, established, re-established, monumented, re-monumented, recovered or restored as expressed below and in conformance with regulations and rules therefore as required in the current manual of survey instructions of the United States Department of the Interior, Bureau of Land Management or by a decree of a court of law. Furthermore, that the corner points mentioned in lines 3, 4 and 5 above were, in a field survey on _____, 19____, found, recovered, restored, established or re-established as expressed below and in conformance with the rules of the Michigan State Board of Registration for Land Surveyors or, by a Decree of a Court of law:

~~A. Description of original monument and accessories and of subsequent restorations~~

C. (continued)

	16
Drove 1 1/4"x18" Rod	
12" Maple	N09°E 29.10
7" Maple	N50°W 39.45
10" Maple	S16°E 50.24
Ctr. E-W dirt rd. Due S	6'
Set cedar post w/loc. tag	
Due N	33.0'

B. Description of corner evidence found and/or method applied in restoring or re-establishing corner:

I-7 Found 1/2" rerod in gravel road intersection N-S-E-W, (b'top road to W & S).
I-8 Found well point (deep) in E shoulder of N-S road, in line with fence to E. Found corner fits very close to midway and on line between section corners to N & S.
I-9 Found well point(0.4' deep) in gravel road intersection N-S-E-W (b'top to E & N).
16 Established 1/16 corner per standard B.L.M. instructions. Corner fits old fence to South.

C. Description of monument for corner and accessories established to perpetuate locating the position of the corner:

I-7	I-8	I-9
Found 1/2" rerod	Found well point	Found well point
P. Pole N40°W 38.89	18" Maple S15°E 75.00	14" Oak N65°W 75.27
P. Pole N68°E 69.62	7" R. Pine S41°E 49.08	4" Apple N33°W 69.97
7" R. Pine S31°E 90.71	8" Maple clstr. N40°W 68.65	8" B.Cherry S27°W 50.18
PI of Co. Rd. E-W-N-S	6" Maple clstr. S76°W 63.88	Set cedar post w/loc. tag
Loc. tag on post S50°W 55.0	Set ced.post w/loc. tag Due W 46'	N45°W 47'
	Ctr. N-S b'top co. rd. Due W 13'	

SIGNED BY

Carl F. Roser

DATE 10-31-77

SURVEYOR'S MICHIGAN REGISTRATION NO. 12028

FOR STATE AND UNITED STATES AGENCIES:

SIGNED BY


CHIEF OF SURVEY PARTY

DATE

APPROVED AND SIGNED BY

MICHIGAN REGISTERED LAND SURVEYOR

DATE

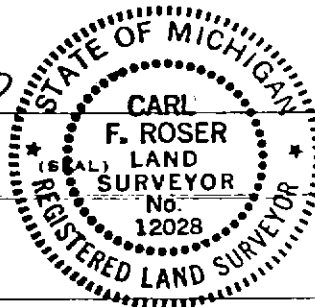

SURVEYOR'S MICHIGAN REGISTRATION NO. _____

GREENWOOD TOWNSHIP
WEXFORD COUNTY