


LAND CORNER RECORDATION CERTIFICATE
Filing Requirement of Act 74, Mich. PA 1970

Wexford (County) Located In Corner Code #
1. Public Land Survey T 24N R 11W K12
2. Property Controlling in Section S T R
3. Miscellaneous Property in Section S T R
4. Lot No: Recorded Plat:
5. Private Claims:

Register of Deeds Stamp & File Number

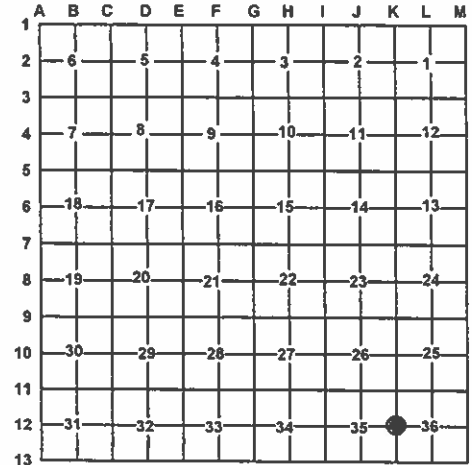

I, Craig W. McVean, in a field survey on Oct. 17, 2012 do hereby state that under requirements of PA 74, Michigan PA of 1970, the corner points mentioned in lines 1 and 2 above were in conformance with regulations and rules therefore as required in the current manual of survey instructions of the United States Department of the Interior, Bureau of Land Management or by a decree of a Court of Law and/or that the corner points mentioned in lines 3, 4 and 5 above were in conformance with the rules of the Michigan Board of Land Surveyors or by a Decree of a Court of Law; established, re-established, monumented, recovered, found as expressed below:

NOTE: Not more than 2 corners, all in the same town and range, may be recorded on this certificate.

A. Description of original monument and accessories and/or subsequent restoration:

- K12 - 1839 - GLO - J. Brink - N. 40:00
Set 1/4 post. 1) Pitch Pine 10" N27°W 16 L.
2) Pitch Pine 10" S66°E 15 L.
- 1913 - Fargo Eng. - No US evidence
Correct temp. 1/4 post 1.20 N. & 6.60 3/8 Chs. E.
Set iron pipe w/ crockery. 3) WPS 18" N9°W 82 L.
4) WPS 24" S51°E 30 L.
- 1937 - F. L. VanSickle - Random Line - N 39.63 inter 13 L. E. of CP Co. Cor.
- 1939 - M. Schaaf notes - [Apparently using VanSickle's Random line] - North random from corner 35 & 36. 22.48 "Intersect very definite Hem. site 2 L. west of random [GLO - 22.50 Hemlock 10"]; 40.04 - Intersect 1/4 Cor. 2 L. west of post. Found SE stump in

place and NW site very definite and roots and hole down and rotten. Took NBT's; 5) WP Stp. 24" S10°E 60; 6) WP stp. 16" N46°W 1.10; 7) Green J.P. 16" N38°E 61'; 8) Green J.P. 15" N2°W 66'; 9) Con. Power Cor. is S20°W 42 1/2 L. From a point 39 lks due west of 1/4 cor. Extended a new random along edge of fire line by picket line. 56.55 (original chaining cont'd) intersect 14" Wh. P. Stp. -64 lks East of random[GLO-56.50-White Pine 14"].
- 1973 - LCRC - L. 2, p. 622 - Recovered Fargo corner by digging and finding butter dish. Added DNR Mon. & Cedar guard post. 10) R. Pine N82°W 64.0'; 11) 15" R. Pine N60°E 60.9'; 12) 15" W. Pine S77°E 101.8'; N-S Dirt Road due West 25'

B. Description of corner evidence found and/or method applied in restoring or re-establishing corner:

K12 - 1/4 Corner common to Sections 35 & 36, T24N, R11W -No evidence of a Schaaf monument was found. Set Department of Natural Resources (DNR) monument per Schaaf's record tie S20°W 28.05' to the Fargo position. This DNR monument fit remains of witnesses # 5 & 8 closely. Condition of witnesses as follows: #1, 2, 6 and 7 are gone #5 - S11°E 40' ± to remains of white pine stump to ground; #8 - N2°02'W(grid) 43.4' to set spike in centerline 15"± Jack Pine stump; # 3, 4, 10, 11 and 12 to rejected Fargo position. Measured grid bearing and distance of S1°41'00"W 2647.99' (2640'-GLO, 2642.64'-MS) to 'K13' and N1°53'08"E 2635.71' (2640'-GLO, 2641.32'-MS) to 'K11'. Centerline of North-South sand road is 35' west. Schaaf had original bearing trees stump and site as well as line tree site to south and line tree stump to north to restore this position, thus the DNR monument is accepted as careful and faithful perpetuation of the position of the original corner.

-Reference Point- S20°52'W(grid) 28.05' from 'K12' to found 4" Department of Conservation Aluminum Cap on 1" x 36" long galvanized iron pipe per Roser at Fargo's proportional position. Rejected this DOC monument as the proper GLO position. DOC monument not utilized as 'K12' in this survey. Removed the DOC monument and also a found butter dish alongside and reset a 1/2" x 18" long iron rebar in its place.

C. Description of monument for corner and accessories established to perpetuate locating the position of the corner:

K12 - Stamped 4" DNR Aluminum Cap on 1" x 36" long galvanized iron pipe.
Set blue carsonite post 1' north.
N81°W 60.02' to set nail and tag (N&T) in N. side 14" White Pine scribed 'XBT'
N55°E 47.73' to set N&T in NW. side 14" Red Pine scribed 'XBT'
S49°E 38.00' to set N&T in NE. side 5" White Pine
N81°E 43.38' to set N&T in S. side 18" Red Pine with found blazes and scribed 'NBT'
S20°52'W 28.05' to Reference Point - 1/2" x 18" rebar

Signed by:

Craig W. McVean

Date:

11/14/2012

Surveyor's Michigan License No.:

39088

