

SURVEY & REMONUMENTATION

RECORDED
WASHTENAW COUNTY, MI

MAR 09 1998

JAN 22 8 32 AM '98

LAND CORNER RECORDATION CERTIFICATE

Filing Requirement of Act 74, Mich. P.A. 1970
PEGGY M. HAINES
COUNTY CLERK/REGISTER

SECTION

- COPY -

For corners in
Washtenaw
(County)

Located In: Corner Code #

1. Public Land Survey T 2S R 5E L-5
T _____ R _____
T _____ R _____
T _____ R _____

2. Property Controlling in Section S _____ T _____ R _____
S _____ T _____ R _____

3. Miscellaneous Property in Section S _____ T _____ R _____
S _____ T _____ R _____

4. Lot No. _____, Recorded Plat _____

5. Private Claims _____

- COPY -

Liber **00002** Page **0065** RM
Register of Deed Stamp & File Number

	A	B	C	D	E	F	G	H	I	J	K	L	M
1													
2	6		5		4		3		2		1		
3													
4	7		8		9		10		11		12		
5													
6	18		17		16		15		14		13		
7													
8	19		20		21		22		23		24		
9													
10	30		29		28		27		26		25		
11													
12	31		32		33		34		35		36		
13													

I, Thomas L. Sutherland, in a field survey on 11/18, 1997 do hereby state that under requirements of P.A. 74, Michigan P.A. of 1970, the corner points mentioned in lines 1 and 2 above were in conformance with regulations and rules therefore as required in the current manual of survey instructions of the United States Department of the Interior, Bureau of Land Management or by a decree of a Court of Law and/or that the corner points mentioned in lines 3, 4 and 5 above were in conformance with the rules of the Michigan Board of Land Surveyors or by a Decree of a Court of Law; established, re-established, monumented, recovered, found as expressed below:

NOTE: Not more than 2 corners, all in the same town and range, may be recorded on this certificate.

A. Description of original monument and accessories and/or subsequent resortation:

- G.L.O. 1819, Field Notes
- 1) 17" W.O. N08°E 42 Links
- 2) 20" Do S12°W 92 Links
- Atwell-Hicks, R. Jagow, #6998, 12/3/73, L.C.R.C., Liber 3, Page 323 Found nothing. Set Iron Pipe on line between SW Corner Section 12 and SE Corner 12 at Midpoint
- 3/4" Iron Pipe
- 3) 18" Elm N67°W 228.0
- 4) 16" Elm S20°E 147.5
- 5) Iron Pipe on Section Line S85°E 305.19
- 6) Iron Pipe on Section Line N85°W 403.64

B. Description of corner evidence found and/or method applied in restoring or re-establishing corner:


Found a 3/4" Iron Pipe on line between corners K-5 and M-5, 2509.64 feet from M-5 and 2535.52 feet from K-5. Based on an Atwell-Hicks L.C.R.C., Liber 3, Page 323, by R. Jagow dated 12/3/73 and a survey by H.H. Atwell dated September 1926, I determined that this corner should be equidistant from corners K-5 and M-5. Set 3/4" x 24" Iron Pipe with aluminum Remonumentation Cap stamped 24620 on line and 2522.58 feet from corners K-5 and M-5, 12.94 feet West of the Pipe set by R. Jagow.

C. Description of monument for corner and accessories established to perpetuate locating the position of the corner:

- 3/4" x 24" Iron Pipe with Aluminum Remonumentation Cap stamped 24620
- 4) 26" Cherry S14°E 150.05 to Remon Tag on Westerly Side
- 3) 30" Elm N73°W 215.61 to Remon Tag on Northwest Side
- 16" Pine North 98.90 to Remon Tag on West Side
- 4" Oak S62°W 71.67 to Remon Tag on Northwest Side
- 12" Oak S85°E 133.76 to Remon Tag on South Side
- 3/4" Iron Pipe East 12.94

APPROVED
DATE 12-2-97
CO. REP. K

I conclude after careful study and field observation that this corner is accepted as a careful and faithful re-establishment of the position of the original corner.

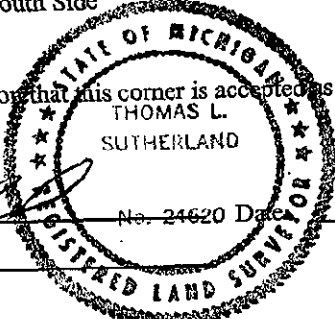

Signed by: Thomas L. Sutherland
Surveyor's Michigan License No. 24620

No. 24620 Date 12-4-97