

APPROVED
DATE 9-23-96
CO. REP. K

LAND CORNER RECORDATION CERTIFICATE
Filing Requirement of Act 74, Mich. P.A. 1970

For corners in

Washtenaw
(County)

Located In:

Corner Code ==

1. Public Land Survey T 3S R 6E J-11
 T R _____
 T R _____
 T R _____
2. Property Controlling S T R _____
 in Section S T R _____
3. Miscellaneous S T R _____
 Property in Sec. S T R _____

Liber 00001 Page 0611am

Register of Deeds Stamp & File Number

4. Lot No. _____, Recorded Plat _____
5. Private Claims _____

I, Todd D. Shelly, in a field survey on 3-22, 19 96, do hereby certify that under requirements of P.A. 74, Michigan P.A. of 1970, the corner points mentioned in lines 1 and 2 above were in conformance with regulations and rules therefore as required in the current manual of survey instructions of the United States Department of the Interior, Bureau of Land Management or by a decree of a Court of Law and/or that the corner points mentioned in lines 3, 4 and 5 above were in conformance with the rules of the Michigan Board of Land Surveyors or by a Decree of a Court of Law; established, re-established, monumented, re-monumented, recovered, found as expressed below:

NOTE: Not more than 4 corners, all in the same town and range, may be recorded on this certificate.

- A. Description of original monument and accessories and/or subsequent restoration:
See back of sheet.

- B. Description of corner evidence found and/or method applied in restoring or reestablishing corner:

Found 10" x 3/4" re-bar over 15" deep 4" conc. filled IP with brass cap 3-12-96.
See back of sheet.

SURVEY &
REMONUMENTATION

MAY 05 1997

COMMISSION

- C. Description of monument for corner and accessories established to perpetuate locating the position of the corner:
Found 10" x 3/4" re-bar over 15" deep 4" conc. filled IP with brass cap. Removed re-bar and witnessed center of brass cap.

3) 26" Walnut	N82°E	143.00'	to nail & RT
6) 20" Hickory	S62°E	67.71'	to nail & RT
8) 18" Tw. Ash	S67°W	39.49'	to nail & RT
10) 34" Tree	N55°E	47.72'	to nail & RT
15) 8" White pine	N12°W	38.50'	to nail & RT


COPY

I believe that this point should be accepted as a careful and faithful perpetuation of the position of the original corner.

Signed by Todd D. Shelly
Surveyor's Michigan License No. 41111

Date Nov 25 1996

FORM APPROVED BY MICHIGAN STATE BOARD OF LAND SURVEYORS, JAN 28, 1993
NO. REVISED MAY 14, 1993
41111 REVISED JAN 1993

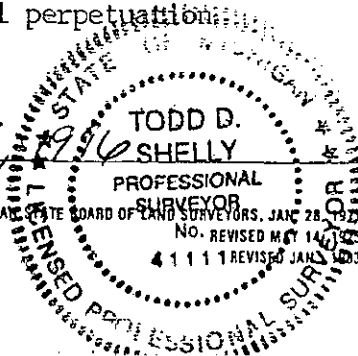

11-18-1887 C.S. Woodard

Stake, tile, brick and stone.

- 1) 10" Hickory
- 2) 12" B. Walnut

N75°W
N64°E

135.6'
83.2'

No date F.J.W. Stoll

Grid Book

No description of monument.

- 3) 12" B. Walnut
- 4) 12" Hickory
- 5) 10" Hickory
- 6) 12" Hickory
- 7) 12" Locust
- 8) 6" Tw. Ash
- 9) 5" Elm
- 10) 1½" Jew tree

N79°E
S63°E
S62°E
S61°E
S17°E
S62°W
S56°W
N51°E

143.6'
67.8'
74.9'
67.3'
28.7'
40.5'
45.8'
47.0'

No date State Highway Dept.

A-H Grid Book

4" pipe filled with concrete with bronze tab on top.

- 4) 16" Hickory
- 8) 23" forked Ash
- 10) 17" Ailanthus

S64°E
S62°W
N52°E

67.85'
40.16'
46.84'

5-27-1958 C. Wilson

A-H book 660-6

Found steel encased mon. 0.3' below surface of road.

11-10-1971 N. Fahrner No. 17620

LCRC L.1, P.385

4" I.P. filled with concrete.

- 3) 24" B. Walnut
- 4) 18" Hickory
- 5) 15" Hickory
- 6) 16" Hickory
- 7) 18" Locust
- 8) 18" Tw. Ash
- 10) 17" Ailanthus
- 11) 24" Catalpa
- 12) 23" forked Ash
- 13) I.P.
- 14) I.P.
- 15) 10" Hickory

N79°E
S63°E
S62°E
S64°E
S17°E
S62°W
N52°E
N51°E
S62°W
N'ly
S'ly
S61°E

143.6'
67.8'
74.9'
67.85'
28.7'
40.5'
46.84'
47.0'
40.16'
33.00'
33.00'
69.0'

12-9-1971 N. Fahrner No. 17620

Survey L.1386, P.689

Found 4" I.P. filled with concrete.

- 3) 24" B. Walnut
- 4) 18" Hickory
- 7) 18" Locust
- 8) 18" Tw. Ash
- 13) I.P.
- 14) I.P.

N79°E
S63°E
S17°E
S62°W
N'ly
S'ly

143.6'
67.8'
28.7'
40.5'
33.0'
33.0'

1-6-1976 Paul Schwimmer

A-H book 782-52

Found steel encased monument with brass plate.

- 3) 30" B. Walnut
- 7) 14" Locust
- 8) 16" Tw. Ash
- 10) 24" Jew tree
- 16) Range of fence line

N80°E
S17°E
S62°W
N51°E
S'ly

143.5'
28.7'
40.5'
47.0'

5-16-1977 A. Ivey No. 6519

LCRC L.4, P.204

A 4" steel pipe with bronze cap stamped "State of Michigan" in S'ly edge of gravel of Merritt Road.

- 4) 16" Hickory
- 8) 23" forked Ash
- 10) 17" Ailanthus (Chinese Sumac)

S64°E
S62°W
N52°E

67.85'
40.16'
46.84'

4-30-1980 Morris Levine No. 11076

Survey L.1757, P.244

Concrete monument with brass.

- 3) 30" Walnut
- 4) 20" Hickory
- 8) 24" Ash
- 17) 10" Pine N54°W

N65°E
S62°E
S66°W
68.47' N & W

47.75' N & W
67.54' N & W
39.39' N & W

1-7-1987 R. Macomber

A-H Drw. 535-138

Found concrete monument with brass cap.

- 3) 30" B. Walnut
- 4) 18" Hickory
- 8) 16" Tw. Ash
- 10) 30" Jew tree
- 18) 10" Cedar

N79°E
S61°E
S62°W
N51°E
N60°W

143.5'
67.50' to nail
39.32' to nail
47.80' to nail
81.1'

8-10-1988 R. Montoye

A-H book 852-42

Found monument with metal cap.

- 3) 32" B. Walnut
- 4) 18" Shag. Hickory
- 5) 12" Shag. Hickory
- 8) 18" Tw. Ash
- 10) 30" Tree of Heaven

N79°E
S61°E
S62°E
S62°W
N51°E

143.6'
67.3'
74.9'
40.5' to nail, S. face
47.8' to nail, S. face

3-18-94 R. Macomber

A-H drw. 535-163

Found conc. monument.

- 3) 30" B. Walnut
- 5) 12" Hickory
- 6) 18" Hickory
- 8) 16" Tw. Ash
- 10) 24" tree

N79°E
S62°E
S61°E
S62°W
N51°E

143.6'
74.9'
67.3'
40.5'
47.0'

3-12-1996 Atwell-Hicks, Inc.

Remonumentation

Found 10" x 3/4" re-bar over 15" deep 4" conc. filled I.P. with brass cap.
Removed re-bar and witnessed center of brass cap.

- 3) 26" Walnut
- 6) 20" Hickory
- 8) 18" Tw. Ash
- 10) 34" Tree
- 15) 8" White pine

N82°E
S62°E
S67°W
N55°E
N12°W

143.00' to nail & RT
67.71' to nail & RT
39.49' to nail & RT
47.72' to nail & RT
38.50 to nail & RT