

MAY - 1 1995

COPY

LIBER

1 PAGE 205 RM  
- Copy -

LAND CORNER RECORDATION CERTIFICATE  
Filing Requirement of Act 74, Mich. P.A. 1970

For corners in COMMISSION

Washtenaw (County)	Located In:	Corner Code #
1. Public Land Survey	T 4S R 3E	K-12
	T R	
	T R	
	T R	
2. Property Controlling in Section	S T R	
	S T R	
3. Miscellaneous Property in Sec.	S T R	
	S T R	

RECORDED  
WASHTENAW COUNTY, MI  
DEC 1 11 39 AM '94  
PEGGY M. HAINES  
COUNTY CLERK/REGISTRAR  
- COPY -  
Register of Deeds Stamp & File Number

4. Lot No. \_\_\_\_\_, Recorded Plat \_\_\_\_\_  
5. Private Claims \_\_\_\_\_

	A	B	C	D	E	F	G	H	I	J	K	L	M
2	6	5	4	3	2	1							
3													
4	7	8	9	10	11	12							
5													
6	18	17	16	15	14	13							
7													
8	19	20	21	22	23	24							
9													
10	30	29	28	27	26	25							
11													
12	31	32	33	34	35	36							
13													

I, Patrick L. Hastings in a field survey on October 7, 19 94,  
do hereby certify that under requirements of P.A. 74, Michigan P.A. of 1970, the corner points mentioned  
in lines 1 and 2 above were in conformance with regulations and rules therefore as required in the  
current manual of survey instructions of the United States Department of the Interior, Bureau of Land  
Management or by a decree of a Court of Law and/or that the corner points mentioned in lines 3, 4 and 5  
above were in conformance with the rules of the Michigan Board of Land Surveyors or by a Decree of a  
Court of Law; established, re-established, monumented, re-monumented, recovered, found as  
expressed below:

NOTE: Not more than 4 corners, all in the same town and range, may be recorded  
on this certificate.

A. Description of original monument and accessories and/or subsequent restoration:

1816	Subdivision of Township.	Set post at 40 chains
(1)	Poplar 10"	N 40° E 14 lks
(2)	Poplar 4"	N 50° W 36 lks
1824	Township GLO Plat by John M. Mack	
1971	W.C.R.C. Grid Book (witnesses by Washtenaw Engineering Co., June 21, 1971) Found 1" iron pipe	
(3)	S 20° E 22.0'	30" Maple
(4)	S 85° E 10.7'	Steel fence post

CONTINUED ON BACK

B. Description of corner evidence found and/or method applied in restoring or reestablishing corner:


1994	Found a 1/2" Hex bar 7" below surface and 3' west of west edge of trav- eled gravel road. There is no occupation line to the west or east.		
(4)	S 85° E 38.5'±	To base of steel fence post leaning west	
(10)	N 45° E 41.15'	10" Ash	to PK
(11)	S 10° W 29.96'	20" Willow	to Side Center
(12)	N 05° W 32.93'	10" Ash	to Nail

C. Description of monument for corner and accessories established to perpetuate locating the position of the corner:

After a careful study of the record documentation and field observations, made under my  
direct supervision, I find this corner as remonumented to be the best available evidence of  
the position of the original corner.

CONTINUED ON BACK

igned by Patrick L. Hastings Date \_\_\_\_\_  
urveyor's Michigan License No. 37277

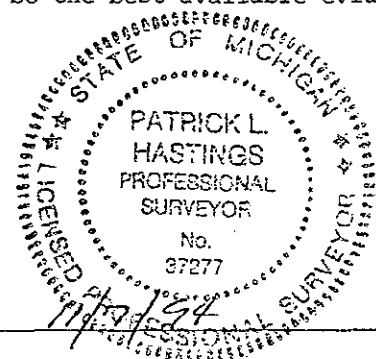

-copy-

SECTION 'A' CONTINUED

1971 (5) S 30° E 103.5' 18" Fir  
 (6) S 70° E 70.0' 20" Fir  
 (7) N 75° W 42.0' Tele. Pole  
 (8) 7.2' east of east edge of pavement (M-52) and in gravel shoulder  
 \*Note: The above witness appears to be for some corner other than the W 1/4 of Section 36 (K-12).

1991 Witnesses from Walter Frazier & Associates  
 (9) East 10' Centerline of road  
 (10) N 45° E 41.15' 10" Ash  
 (11) S 10° W 28.92' 20" Willow

1991 Survey by Gerald Myers, found a 1/2" Hex. rebar  
 (10) N 45° E 41.59' 12" Ash  
 (11) S 10° W 28.96' 20" Willow  
 (12) N 05° W 32.93' 10" Ash

SECTION 'C' CONTINUED

Set 1" x 24" iron pipe over hex bar with standard remon. cap stamped #37277 6" below surface.

(10)	N 45° E	41.59'	12" Ash	RT & PK Blazed
(11)	S 10° W	28.96'	24" Willow	RT & PK Blazed
(12)	N 05° W	32.93'	10" Ash	RT & PK Blazed
(13)	S 45° W	41.54'	12" Willow	RT & PK Blazed

APPROVED

DATE 11/7/94CO. REP. K<sub>4</sub>

7