

SURVEY & REMONUMENTATION

MAY - 1 1995

COPY

COMMISSION

LAND CORNER RECORDATION CERTIFICATE
Filing Requirement of Act 74, Mich. P.A. 1970

For corners in

WASHTENAW
(County)

Located In:

Corner Code #

1. Public Land Survey

T 4S R 3E

K-13

T R

T R

T R

2. Property Controlling
in Section

S T R

S T R

3. Miscellaneous
Property in Sec.

S T R

S T R

4. Lot No. , Recorded Plat

5. Private Claims

RECORDED
WASHTENAW COUNTY, MI
Dec 1 11 39 AM '94
PEGGY M. HAINES
COUNTY CLERK/REGISTER

1 PAGE 207 RM

LIBER

Register of Deeds Stamp & File Number

- Copy -

	A	B	C	D	E	F	G	H	I	J	K	L	M
2	6	5	4	3	2	1							
3													
4	7	8	9	10	11	12							
5													
6	18	17	16	15	14	13							
7													
8	19	20	21	22	23	24							
9													
10	30	29	28	27	26	25							
11													
12	31	32	33	34	35	36							
13													

I, PATRICK L. HASTINGS, in a field survey on OCT. 7, 19 94, do hereby certify that under requirements of P.A. 74, Michigan P.A. of 1970, the corner points mentioned in lines 1 and 2 above were in conformance with regulations and rules therefore as required in the current manual of survey instructions of the United States Department of the Interior, Bureau of Land Management or by a decree of a Court of Law and/or that the corner points mentioned in lines 3, 4 and 5 above were in conformance with the rules of the Michigan Board of Land Surveyors or by a Decree of a Court of Law; established, re-established, monumented, re-monumented, recovered, found as expressed below:

NOTE: Not more than 4 corners, all in the same town and range, may be recorded on this certificate.

A. Description of original monument and accessories and/or subsequent restoration:

1815

Township Boundary Set Post, Hough, P.S.

(1) R. Oak 16" N 21° W 56 lks

(2) B. Oak 10" N 54° E 70 lks

1816

Subdivision of Township

1824

Township GLO Plat by John M. Mack, P.S.

W.C.R.C. Grid Book - Nothing

CONTINUED ON BACK

B. Description of corner evidence found and/or method applied in restoring or reestablishing corner:

1994


Found a mon. box 4' south of the N. edge of US-12 and along CL of Hudson Road to N. - no iron

(3) N 09° E 140.00' 18" Walnut No Tag
(6) S 65° W 76.23' Telephone Pole Nail and Disc
(7) N 34° W 51.4' Fence Post MDOT Tag Leaning N.W.

C. Description of monument for corner and accessories established to perpetuate locating the position of the corner:

After a careful study of the record documentation and field observations, made under my direct supervision, I find this corner as remonumented to be the best available evidence of the position of the original corner.

CONTINUED ON BACK

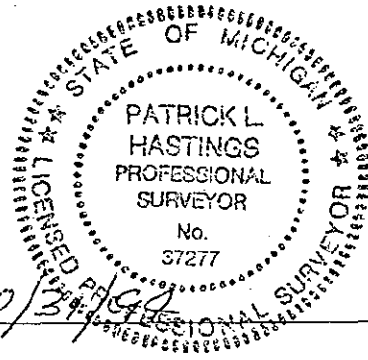

Signed by Patrick L. Hastings Date 10/31/94

Surveyor's Michigan License No. 37277

- copy -

SECTION 'A' CONTINUED

From Walter Frazier & Assoc. From records of Charles E. Snyder, P.E. 10-24-1956.
Original corner destroyed during construction of highway in 1929.

Set railroad spike in cone joint at north edge concrete slab.

(3)	N 09° E	140.45'	14" Walnut MDOT Tag
(4)	N 50° E	63.33'	24" Oak MDOT Tag
(5)	S 83° E	160.90'	21" Hickory MDOT Tag
(6)	S 65° W	76.84'	Telephone Pole MDOT Tag
(7)	N 34° W	50.92'	Fence Post MDOT Tag
(8)	N 24° W	69.00'	24" Elm MDOT Tag

1964 Survey by Walter Frazier, found spike in N. edge pavement.

SECTION 'C' CONTINUED

Set 1" x 24" iron pipe and steel remonumentation cap stamped #37277 center in existing monument box.

(3)	N 09° E	140.00'	18" Walnut	RT & PK
(6)	S 65° W	76.23'	Tele. Pole	RT & PK and nail and shinner
(9)	S 05° W	10.9'	Mon. Box on	Painted CL
(10)	N 45° W	51.22'	6" Elm	RT & PK
(11)	N 35° W	63.77'	10" Elm	RT & PK
(12)	N 40° E	55.25'	6" Oak	RT & PK
(13)	N 30° W	81.08'	12" Elm	RT & PK

APPROVED

DATE 10/24/94CO. REP. 4