

SURVEY &
REMONUMENTATION

COPY

RECORDED
WASHTENAW COUNTY, MI

MAY - 1 1995

LAND CORNER RECORDATION CERTIFICATE
Filing Requirement of Act 74, Mich. P.A. 1970

FEB 1 8 49 AM '95

For corners in COMMISSION

WASHTENAW

(County)

Located In:

Corner Code #

1. Public Land Survey

T 4 S R 4 E

1-13

T R

T R

T R

T R

2. Property controlling
in Section

S

T R

S

T R

3. Miscellaneous

S

T R

Property in Sec.

S

T R

4. Lot No. , Recorded Plat

5. Private Claims

PEGGY M. HAINES
COUNTY CLERK/REGISTER

-COPY-

LIBER

1 PAGE 342 RM
COPY

Register of Deeds Stamp & File Number

I, Paul V. Schwimmer, in a field survey on October 28, 19 93, do hereby certify that under requirements of P.A. 74, Michigan P.A. of 1970, the corner points mentioned in lines 1 and 2 above were in conformance with regulations and rules therefore as required in the current manual of survey instructions of the United States Department of the Interior, Bureau of Land Management or by decree of a Court of Law and/or that the corner points mentioned in lines 3, 4 and 5 above were in conformance with the rules of the Michigan Board of Land Surveyors or by Decree of a Court of Law; established, re-established, monumented, re-monumented, recovered, found as expressed below:

NOTE: Not more than 4 corners, all in the same town and range, may be recorded on this certificate

A. Description of original monument and accessories and/or subsequent restoration:

From page 330

Set post in prairie GLO

August 31, 1819

1) Ash 6" N 66° W 4 links

2) Ash 5" S 33° E 6 links

Iron pipe

5) Elm 3" N 05° W 14.38' to nail

6) Elm 5" N 50° E 24.12' to spike

7) Elm 3" N 55° E 27.62' to nail

Glenn E. Richard LS# 13040

Survey Job #739234

5/3/73

Set 3/4" iron pipe 18" deep
on line between N 1/4 corner &
NE corner of Section 3 T5S, R4E
at GLO record distance.

5) Elm 3" N 05° W 14.38' to nail

6) Elm 5" N 50° E 24.12' to spike

7) Elm 3" N 55° E 27.62' to nail

8) Steel post N 10.50'

Glenn E. Richard LS# 13040

LCRC L3 P147

5/23/73

Found 3/4" iron pipe
buried 1.0'

5) Elm 3" N 05° W 14.38' to nail

6) Elm 5" N 50° E 24.12' to spike

7) Elm 3" N 55° E 27.62' to nail

9) 2" Steel post S 80° E 114.83'

on fence line E & S

Control Survey notes

8/3/75

From page 389

Set post

3) W. Oak 9" N 44° E 8 links

4) D0 30" S 53° E 31 links

no date on this page of notes

B. Description of corner evidence and/or method applied in restoring or reestablishing corner:

Found 3/4" iron pipe 1.0' below surface of cultivated area 4' south of edge of field and 2' north of E-W fence line extended westerly.

Found remaining witnesses:

5) Elm 12" N 05° W 14.29' to PK nail set on E side.

8) Steel post Nly. 10.50'

Offset pipe then removed it to check for evidence of other monuments. Found nothing else.

C. Description of monument for corner and accessories established to perpetuate locating the position of the corner:
Set 1" x 24" iron pipe with 2" aluminum Remonumentation cap 18" below surface of field at location of found pipe.
Set additional accessories:

10) Elm 14" N 80° W 35.62' to PK nail set in S. side.

11) Elm 6" N 75° E 34.02' to PK nail set in S. side.


9) 2" Steel fence corner post S 80° E 114.95'

I believe this point should be accepted as the best available evidence of the original corner.

Signed by Paul V. Schwimmer

Date 12/20/94

Surveyor's Michigan License No. 24618

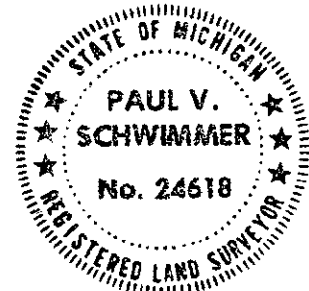

APPROVED

DATE 12/12/94

CO. REP. KA