

REMONUMENTATION

COPY

MAY - 1 1995

LAND CORNER RECORDATION CERTIFICATE
Filing Requirement of Act 74, Mich. P.A. 1970

For corners in COMMISSION

WASHTENAW

(County)

Located In:

Corner Code #

- | | | | |
|---------------------------------------|-------|-------|------|
| 1. Public Land Survey | T 4 S | R 4 E | K-11 |
| | T | R | |
| | T | R | |
| | T | R | |
| 2. Property controlling in Section | S | T | R |
| | S | T | R |
| 3. Miscellaneous Property in Sec. | S | T | R |
| | S | T | R |
| 4. Lot No. _____, Recorded Plat _____ | | | |
| 5. Private Claims _____ | | | |

RECORDED
WASHTENAW COUNTY, MI
FEB 1 8 50 AM '95
PEGGY M. HAINES
COUNTY CLERK/REGISTER
-copy-

Register of Deeds Stamp & File Number

	A	B	C	D	E	F	G	H	I	J	K	L
2	6	5	4	3	2	1						
3												
4	7	8	9	10	11	12						
5												
6	15	17	16	15	14	13						
7												
8	19	20	21	22	23	24						
9												
10	30	29	28	27	26	25						
11												
12	31	32	33	34	35	36						
13												

I, Paul V. Schwimmer, in a field survey on October 14, 19 93, do hereby certify that under requirements of P.A. 74, Michigan P.A. of 1970, the corner points mentioned in lines 1 and 2 above were in conformance with regulations and rules therefore as required in the current manual of survey instructions of the United States Department of the Interior, Bureau of Land Management or by decree of a Court of Law and/or that the corner points mentioned in lines 3, 4 and 5 above were in conformance with the rules of the Michigan Board of Land Surveyors or by Decree of a Court of Law; established, re-established, monumented, re-monumented, recovered, found as expressed below:

NOTE: Not more than 4 corners, all in the same town and range, may be recorded on this certificate

A. Description of original monument and accessories and/or subsequent restoration:

Wood Post GLO 1819

- 1) Ironwood 6" S 28° E 16 links
2) Ironwood 6" N 46° W 23 links

- Found brinks and stones.
Set 1 1/2" X 40" iron pipe, stones, and bricks.
3) Elm 30" North 59.0'
4) Hickory 24" S 87° E 15.3'
5) Pear 14" S 70° W 79.8'

W. J. Armstrong
Grid Book
December 29, 1941

Found 1 1/2" Iron Pipe

- 4) Hickory 24" S 87° E 15.33 ft to spike in S. side
6) Ash 6" N 44° E 74.10 ft to spike in E. side
3) Stump 30" North 60.0 ft
7) Hickory 27" S 87° E 83.77 ft to spike in N. side
K C Sudens field notes
1952

CONTINUED ON BACK

B. Description of corner evidence and/or method applied in restoring or reestablishing corner:

- Found 1 1/2" Iron Pipe at fence corner from remaining witnesses.
4) Hickory 24" S 87° E 15.33 ft to nail in S. side
6) Ash 12" N 44° E 74.12 ft
7) Hickory 27" S 87° E 83.64 ft

RECORDED
WASHTENAW COUNTY, MI
FEB 1 8 50 AM '95
PEGGY M. HAINES
COUNTY CLERK/REGISTER

C. Description of monument for corner and accessories established to perpetuate locating the position of the corner:

Set 3/4" iron pipe inside 1 1/2" iron pipe and set remonumentation cap over this pipe.

Additional accessories set:

- 9) Hickory 24" N 01° W 144.18 ft to PK nail set on W. side.
10) Maple 6" N 07° E 17.83 ft to PK nail set on W. side.
11) Elm 15" S 80° W 93.34 ft to PK nail set on N. side.
12) Cherry 6" S 45° E 28.28 to PK nail set on W. side
6) Ash 12" N 44° E 74.12 ft to PK nail set on S. side
7) Hickory 27" S 87° E 83.64 ft to PK nail set on N. side

I believe this point should be accepted as the best available evidence of the original corner.

Signed by


Paul V. Schwimmer

Date

12/29/94

Surveyor's Michigan License No.

24618

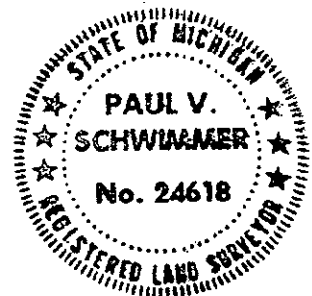

CORNER K-11, T4S, R4E

Description of original monument and accessories and/or subsequent restoration (continued from front page)

Found 1 1/2" Iron pipe
from Grid Book witnesses

- 4) Hickory 27" S 87° E 15.3'
- 5) Pear 16" S 70° W 79.8'
- 8) Walnut 27" North 127.5'

Norman N. Fahrner LS #17620
LCRC L1 P513
11/24/71Found 1 1/2" iron pipe under
fence corner post.

- 4) Hickory 24" S 87° E 15.33' to spike
- 7) Hickory 27" S 87° E 83.77' to spike
- 6) Ash 6" N 44° E 74.10' to spike

R. Timothy Tietsema RLS 20712
Survey Job #454E35-75-242
10/75

Found 1 1/2" Iron

- 4) Hickory 20" S 86° E 15.33'
- 3) Stump 24" North 59.06' to nail
- 6) Ash 6" N 45° E 74.11' to nail

Werner Sommer RLS 12030

LCRC L4, P56

Surveys 11/05/75 and 7/12/76 (no changes)

APPROVED

DATE 12/12/74

CO. REP. M