


Township N. 40. N. Range 19 W. Mer. Mich.

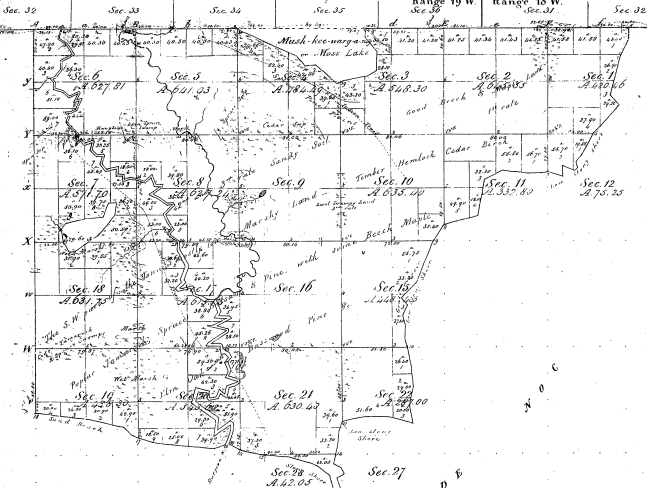

Number of	Acres	Value	Assessed	Value	Assessed	Value	Assessed
46	3						
Total of open land later of the St. No. 11							

46-13

Total number of acres 405 20 63

Survey designated	By whom surveyed	Date of capture	Survey of	When surveyed	Who claimed
Traverse lines	H. J. Smith	Feb. 6, 1854	St. No. 11	1854	H. J. Smith
Traverse lines	H. J. Smith	Feb. 6, 1854	St. No. 11	1854	H. J. Smith

All above lots of Township of the North of Range 19 West of the
 Principal Meridian Michigan, is hereby approved to the full value
 of the same for purposes in the above named laws, and approved
 Henry S. Smith, Clerk
 Recorder, April 14, 1854

Richard J. ...
 Recorder