


Re Survey  
**Township 1<sup>st</sup> 26<sup>N</sup> Range 3<sup>rd</sup> 9<sup>th</sup> W. Mex. Mich.**

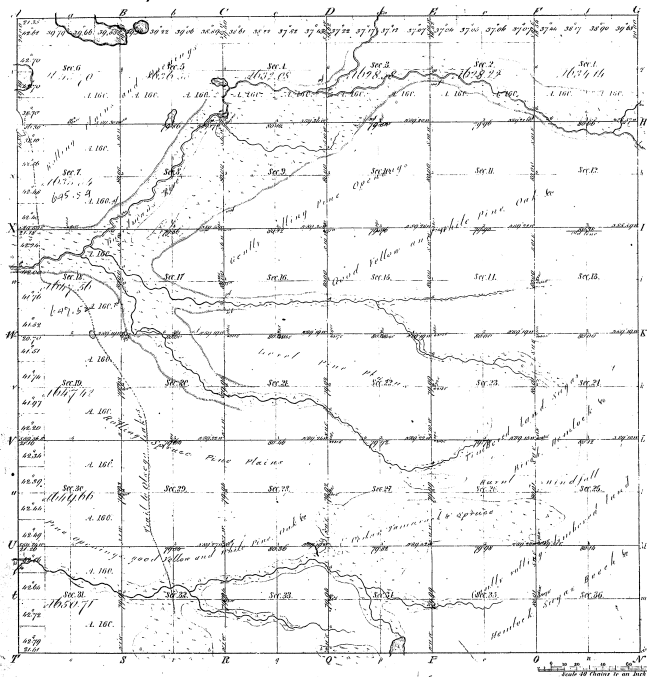

Total number of Acres 230,34.16

Survey designated	By whom surveyed	Date of Contract	Amount of Survey	When Surveyed	Where Surveyed
Township Area	Wm. Bond	May 25, 1852	36 36 36	5-1852	Sec. 10, 11, 12, 13, 14, 15, 16, 17, 18, 19, 20, 21, 22, 23, 24, 25, 26, 27, 28, 29, 30, 31, 32, 33, 34, 35, 36
Subdivisions	L. S. Swanson	May 11, 1852	60 22 56	5-1852	Sec. 10, 11, 12, 13, 14, 15, 16, 17, 18, 19, 20, 21, 22, 23, 24, 25, 26, 27, 28, 29, 30, 31, 32, 33, 34, 35, 36

The above copy of Township 1<sup>st</sup> 26<sup>th</sup> N. of Range 3<sup>rd</sup> 9<sup>th</sup> W. of the 1<sup>st</sup> Principal Meridian, Michigan, is hereby returned to the field notes of the survey filed in file in this office, which have been examined and approved.  
 Surveyor General's Office. *Marin Miller* Sur. Gen.  
 Detroit Dec. 2, 1852

Memoranda of  
 Public Courses 1852 Public Courses 1853 Public Courses 1854

16-20

16-20

Memoranda of  
 Public Courses

13