


Resurvey
Township N^o 31. N. Range N^o 5 E. Mer. Mich.

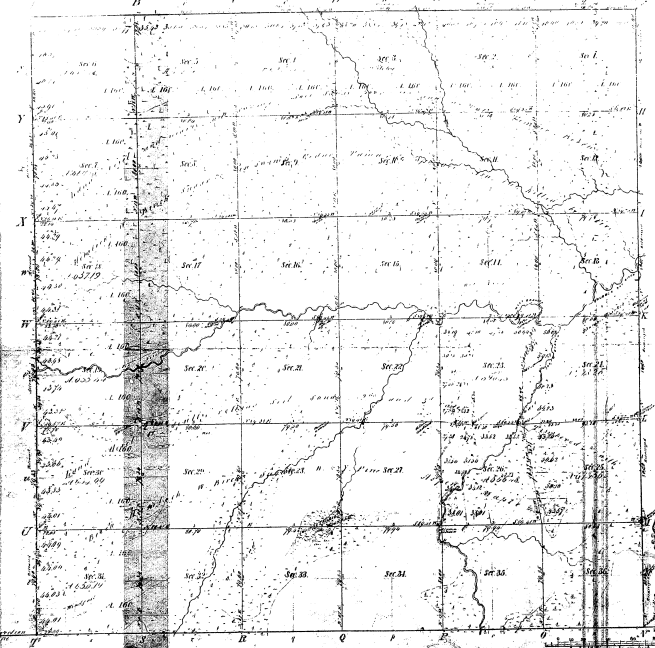

Warrant No. _____
 Date of Survey _____

32

Total number of Acres 6122.57

Survey designated	By whom	Date of contract	Area Surveyed	Area returned
Township Survey	James C. Smith	May 10 th 1816	6122.57	6122.57
Subdivisions of	James C. Smith	May 28 th 1816	600 000 00	575 000 00
of Township	James C. Smith	May 28 th 1816	6 22 57	597 500 00

The above copy of Warrant No. _____ is a copy of the original Warrant of the Principal Surveyor of Michigan is hereby referred to the fact that the same shall be the original and correct copy of the same.

James C. Smith
 Surveyor General
 Detroit April 22 1858

Secunde C. Smith
 April 22 1858

Each sheet of this map is to be preserved as a separate sheet.

James C. Smith
 Surveyor General