


Township N. VII north, Range N. II East Mer. (Mc. Tor.)

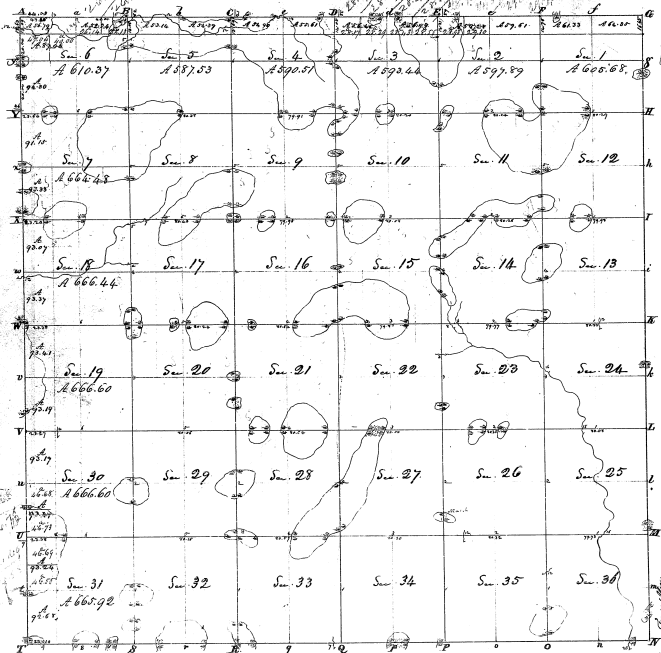

Total Acres 23915.46

Surveyors	Robt. Cook	July 17, 1836	6.03.1837	of 1837	of 1837
Subscribers	Henry Cook	2.2.1837	59.66.97	1837	1837

The above Map of Township N. VII N. of Range N. II East of the Principal Meridian, Michigan, has been examined and found to conform to the General Notes of the Survey, though no file in this office, which have been examined and approved.
 Surveyor General's Office,
 18. June 1837.
 M. T. Williams

Certificate					
Sections	Acres	Acres	Sections	Acres	Acres

23-14
83114