


Return

Township 1st 18. N. Range 1st 2 W. Mer. Mich.

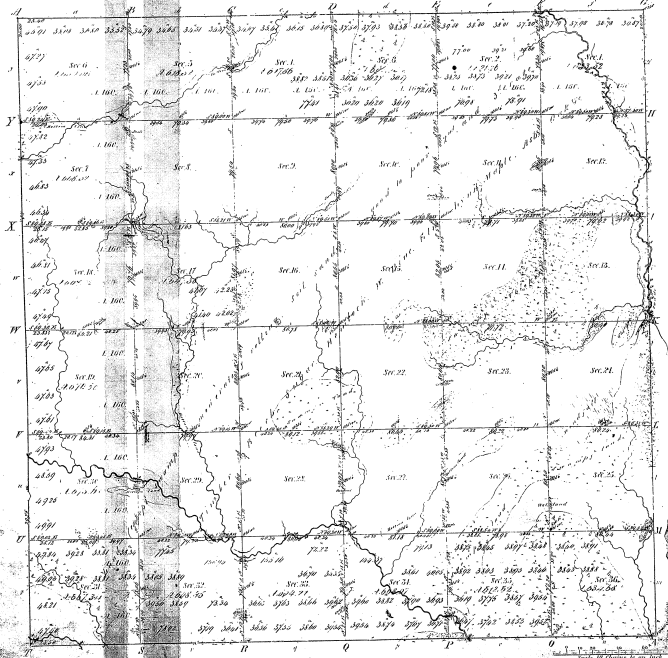

State of Michigan
County of ...

13-10

13-10

Total number of Acres 2207.00

Survey/Designation	When Surveyed	Date of Contract	When Contracted
...	...	July 27 1851	...
...	...	April 1850	...

The above copy of Township 18 N. 2 E. 2 West of the Principal Meridian of Michigan is truly conformable to the field notes of the survey thereon in the records of the Surveyor General and approved by me
David Chapman
Surveyor General

Carte: Copy made