


Township XXV north Range III west Mer. (M.T.)

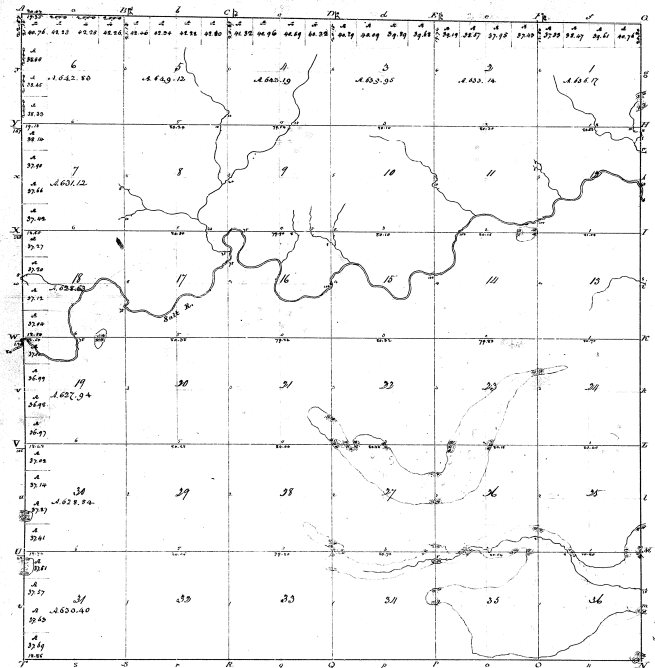

13-23

13-23

Total number of Acres 22,001.33

Survey completed	By John Long	Date of final plat of survey	17 th Nov. 1830
From boundaries of	John Long	Sec. 17-30-91	3 rd of 1832 3 rd of 1832

The plan Map of Township No. 25 North of Range No. 3 West Meridian, showing a survey of sections 6, 7, 17, 18, 19, 20, 21, 22, 23, 24, 25, 26, 27, 28, 29, 30, 31, 32, 33, 34, 35, 36 in the Office which have been examined and approved.

Surveyor General's Office
 Cincinnati, Sept. 25th 1832

M. T. Williams
 Secy