


Township N. 11 North, Range N. 14 East Mer. (M. Ten.)

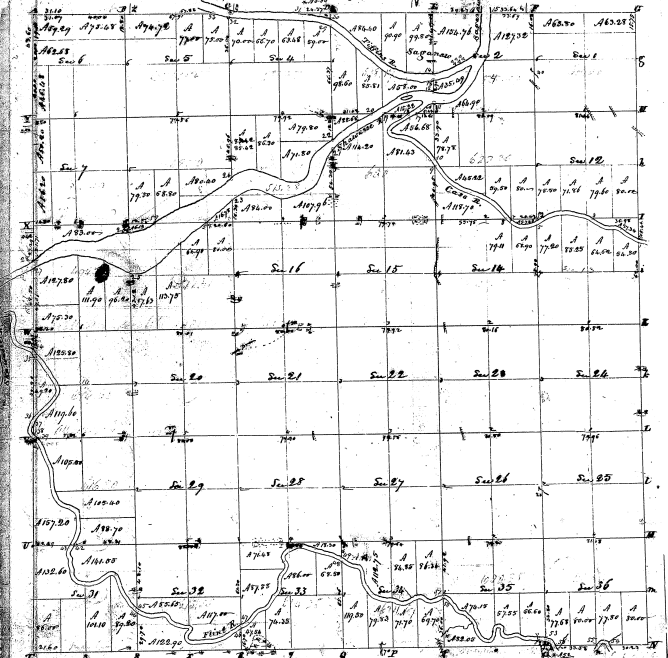

23-40
23-40

As a witness to a contract with and instructions from George W. Brown, General of the United States Army, dated the 1st day of August 1864, and to certify that the above described lands both actual and potential as are represented on attached and correct in the field notes made during said survey, and also to certify that the same are the property of the United States.

Witness my hand and seal of office this 1st day of August 1864.

Wm. W. W. W.

