


Township 50<sup>n</sup>. Range 31<sup>w</sup>. Mer. Mich.

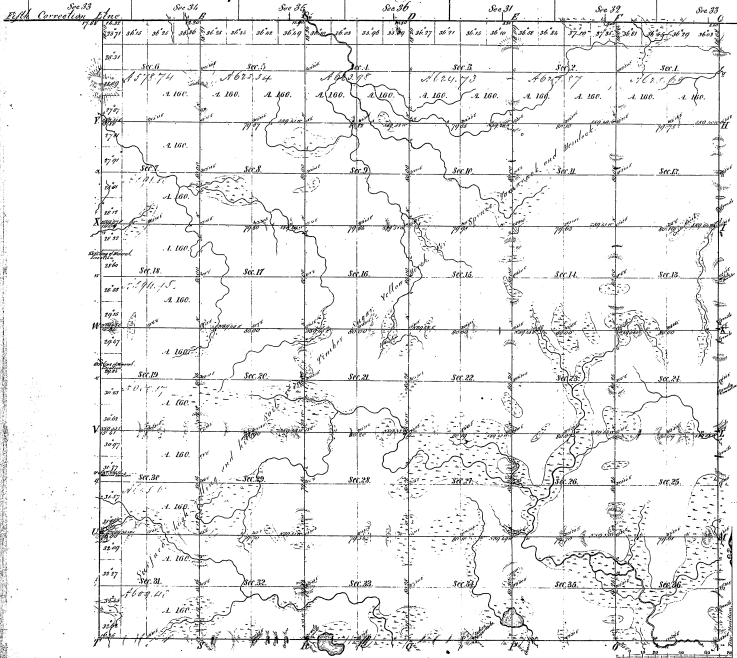

Merrill's co.		Merrill's co.	
Acres	Value	Acres	Value

45-2

Total number of Acres 22,706.61

Survey designated	By Whom Surveyed	Date of Contract	Amount of Survey	When Surveyed	When 1/2 Sec. and all the Section 36 was
Township 50 <sup>n</sup> .	W. C. ...	Sept. 7 1846	75 98.50	1 <sup>st</sup> Class: 1846	
Subdivisions	City of ...	Nov. 15 1852	89 65.10	3 <sup>rd</sup> Class: 1852	

The above Map of Township 50 North of Range 31 West of the Principal Meridian Michigan is hereby pronounced to be the field notes of the survey thereof as filed in this Office which has been examined and approved.

Deputy General Office  
 Detroit Sept. 15 1853

*[Signature]*