


Township No 45 N. Range No 2 E.

Mer. Mich.

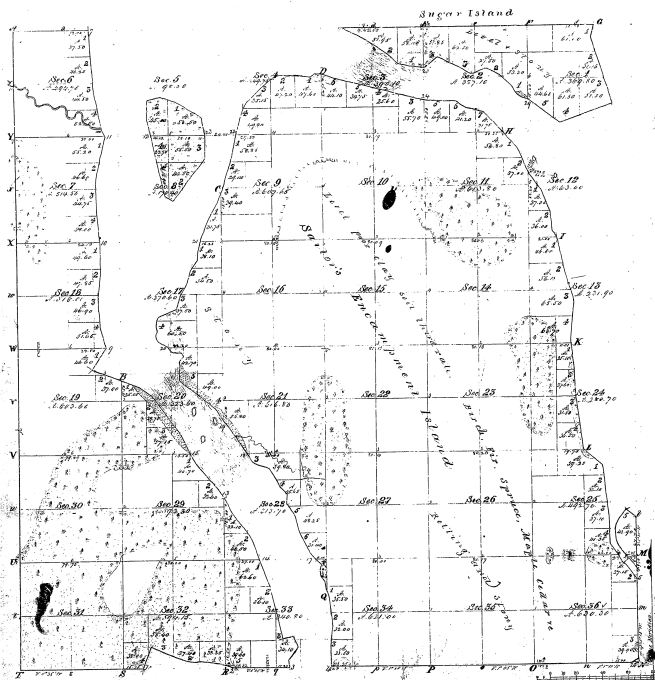

Total number of acres 172,286.0

Survey suggested	By whom suggested	Date of contract	Amount of survey in Acs & Fcs	When surveyed	Who surveyed the land
Primary line	John A. Black	Aug 15 1864	172,286.0	1st of 1864	John A. Black
Subdivisions	John Muller	1864	172,286.0	1st of 1864	John A. Black


The above map of Township No 45 north of Range No 2 East of the Principal Meridian, Michigan, is fully conformable to the full series of the survey maps on file in this Office, which have been examined and approved.

Surveyor General's Office
 Detroit, Aug 21 1864
 Success Lyon, Secy Genl

Description of					
Tract	Acres	Owner	Value	County	State
33	8				
33	8				

TOWNSHIP 45 NORTH, RANGE 2 EAST, OF THE MICHIGAN MERIDIAN, MICHIGAN.
SURVEY OF ISLANDS

33-8

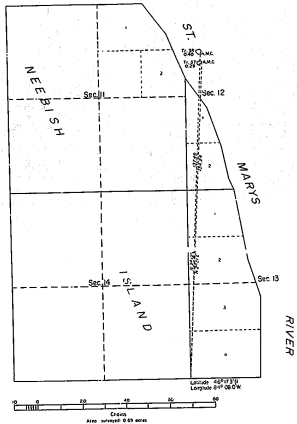

A history of surveys is contained in the field notes.

This plat represents the survey of two islands in St. Marys River, T. 45 N., R. 2 E., Michigan Meridian, Michigan.

Except as indicated herein, the listings and areas are as shown on the plat approved January 31, 1864.

Survey executed by Gary L. Kratz, Cadastral Surveyor, beginning May 23, 1978, and completed June 6, 1978, pursuant to Special Instructions dated June 3, 1977, for Group No. 74, Michigan.

UNITED STATES DEPARTMENT OF THE INTERIOR
BUREAU OF LAND MANAGEMENT
Denver, Colorado November 19, 1981

This plat is strictly conformable to the approved field notes, and the survey, having been correctly executed in accordance with the requirements of law and the regulations of this Bureau, is hereby accepted.

For the Director

Acting Chief, Cadastral Survey
Registration and Approval Staff