


Township N° 45 N. Range N° 6 W. Mer. Mich.

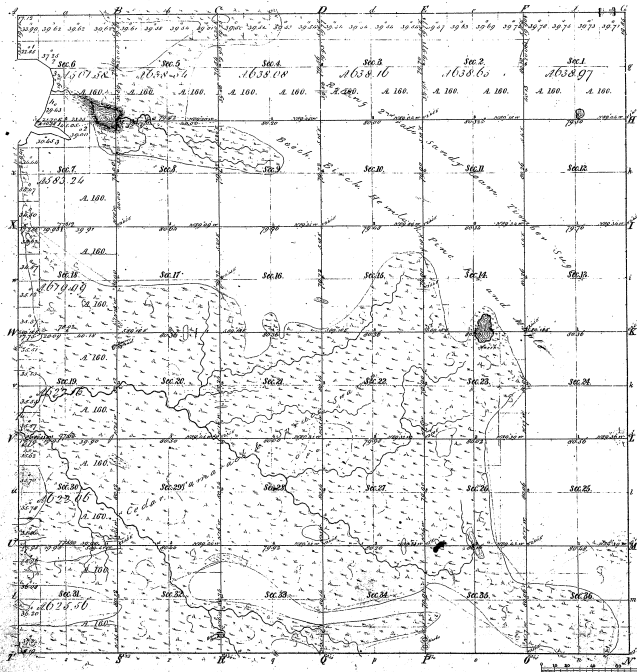

Total number of Acres 10767.80

Survey Designated	By Whom Surveyed	Date of Contract	Amount of Survey	When Surveyed
Township	Wm. B. Mack	June 19 1860	36 Secs.	78
Subdivisions	Hells Run	June 29 1862	66 1/2	1862

The above Map of Township N° 45 North of Range N° 6 West of the Principal Meridian Michigan is hereby returned to the field notes of the survey shown on file in this Office which have been examined and approved.
 Surveyor General Office
 Detroit June 5 1867
 Charles F. W. Turner

Measures of
 Field Courses N 25° W 162
 Field Courses N 25° W 162
 Field Courses N 25° W 162
 Field Courses N 25° W 162

34-22

34-22

