


Township 45 N. Range 9 W. Mer. Mich.

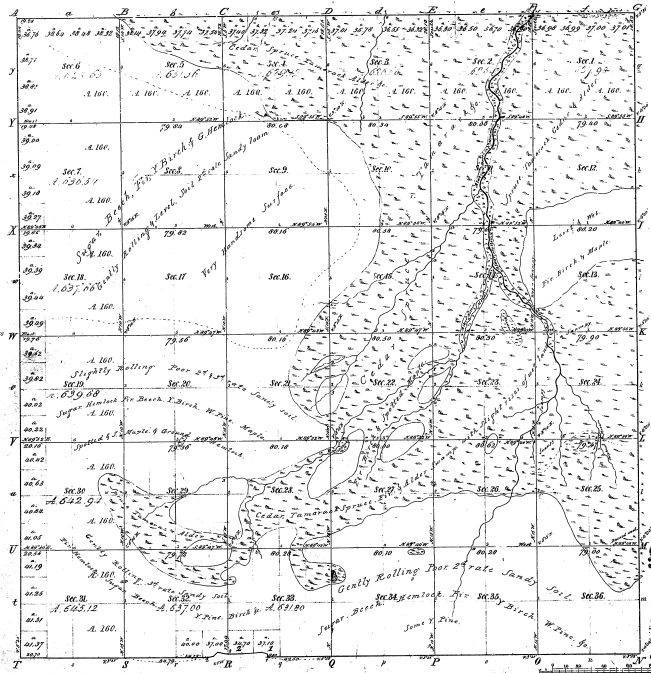

Structure of  
 (Post Course 1812) (Post Course 1812) (Post Course 1812)

35-26

35-26

Total number of Acres. 22,960.89

Survey Designated	By Whom Surveyed	Date of Convey	Amount of Survey	When Surveyed	Area of the Survey in Acres
Survey No. 1	William A. Durr	July 1st 1857	36.00	1857	36.00
Subdivisions	William A. Durr	June 7, 1859	62.20	1859	62.20

The above copy of Township 45 N. Range 9 W. Mer. Mich. is a true and correct copy of the original Township Map as the same appears on file in the office of the Surveyor General of the State of Michigan.

Surveyor General of the State of Michigan  
 Charles J. Smith

Made At \_\_\_\_\_  
 Date \_\_\_\_\_