


Township 1° 49' N. Range 1° 9' W. Mer. Mich.

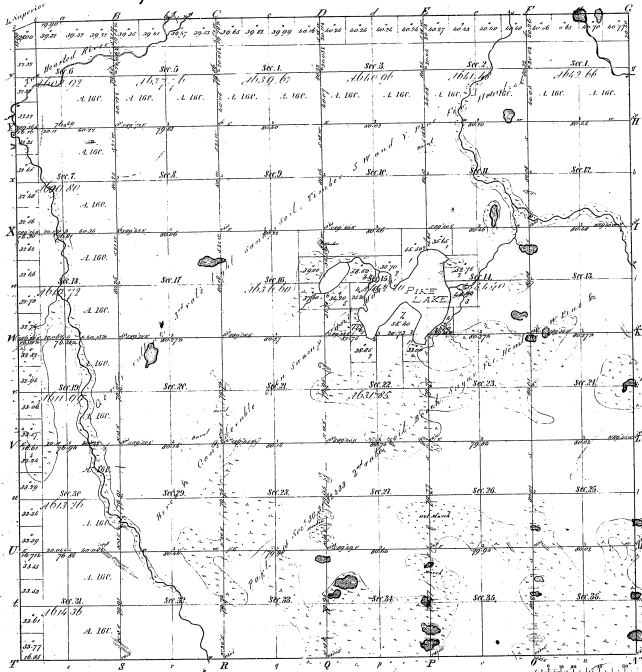

Boundaries of
 Public Lands in 1842 Public Lands in 1846 Public Lands in 1850

316

35-8

Altered
 5 miles west of M.

Total number of Acres 22,570.68

Persons designated	By whom designated	Date of Grant	Amount of Acres	When received
Benjamin Hope	William & David	April 1 1842	25 76 50	25 th June 1842
William & David	William & David	April 1 1842	25 76 50	25 th June 1842
Subscribers	Henry Weston	April 1 1842	65 58 67	25 th June 1842

The above copy of Township 1° 49' North of Range 1° 9' West of the
 Principal Meridian in Michigan is hereby referred to the public notice
 of the survey being on file in this office, which has been examined and approved.

George S. Jencks, Office
 Detroit Jan 10 1852

Charles F. Smith
 Surveyor