


Township 1. VIII south, Range 1. I west (M. Ter.)

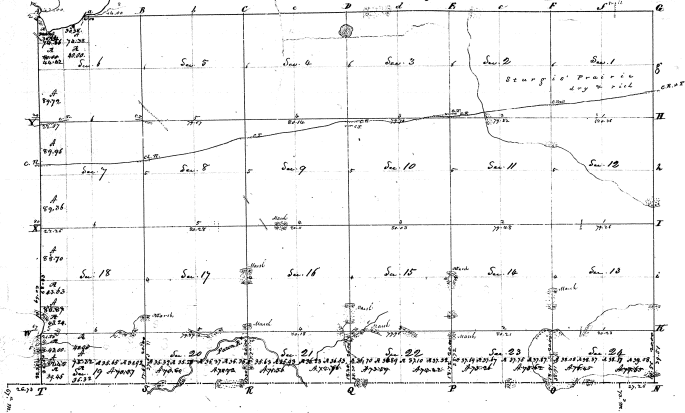

Surveyed in May 1888. by Robert Clark jun. S. L.

Scale 40 Feet to an inch

Corners		Perchals	
Acres	Perchals	Acres	Perchals
Sec. 1	600		
2	600		
3	600		
4	600		
Sec. 1	70 38		
Sec. 2	74 68		
Sec. 3	80		
Sec. 4	89 72		
Sec. 5	82 24		
Sec. 6	80		
Sec. 7	89 91		
Sec. 8	80		
Sec. 9	89 38		
Sec. 10	600		
Sec. 11	600		
Sec. 12	600		
Sec. 13	600		
Sec. 14	600		
Sec. 15	600		
Sec. 16	600		
Sec. 17	600		
Sec. 18	600		
Sec. 19	600		
Sec. 20	600		
Sec. 21	600		
Sec. 22	600		
Sec. 23	600		
Sec. 24	600		
Sec. 25	600		
Sec. 26	600		
Sec. 27	600		
Sec. 28	600		
Sec. 29	600		
Sec. 30	600		
Sec. 31	600		
Sec. 32	600		
Sec. 33	600		
Sec. 34	600		
Sec. 35	600		
Sec. 36	600		
Sec. 1	70 38		
Sec. 2	84 74		
Sec. 3	80		
Sec. 4	89 72		
Sec. 5	80		
Sec. 6	74 57		
Sec. 7	75 52		
Sec. 8	82 48		
Sec. 9	80		
Sec. 10	74 72		
Sec. 11	80		
Sec. 12	70 60		
Sec. 13	80		
Sec. 14	78 74		
Sec. 15	80		
Sec. 16	71 52		
Sec. 17	80		
Sec. 18	80		
Sec. 19	74 62		
Sec. 20	80		
Sec. 21	80		
Sec. 22	70 59		
Sec. 23	80		
Sec. 24	70 62		
Sec. 25	80		
Sec. 26	78 24		
Sec. 27	80		
Sec. 28	77 62		
Sec. 29	80		
Sec. 30	74 62		
Sec. 31	80		
Sec. 32	70 50		

2-35