




NORTH CAMPGROUND TOILET

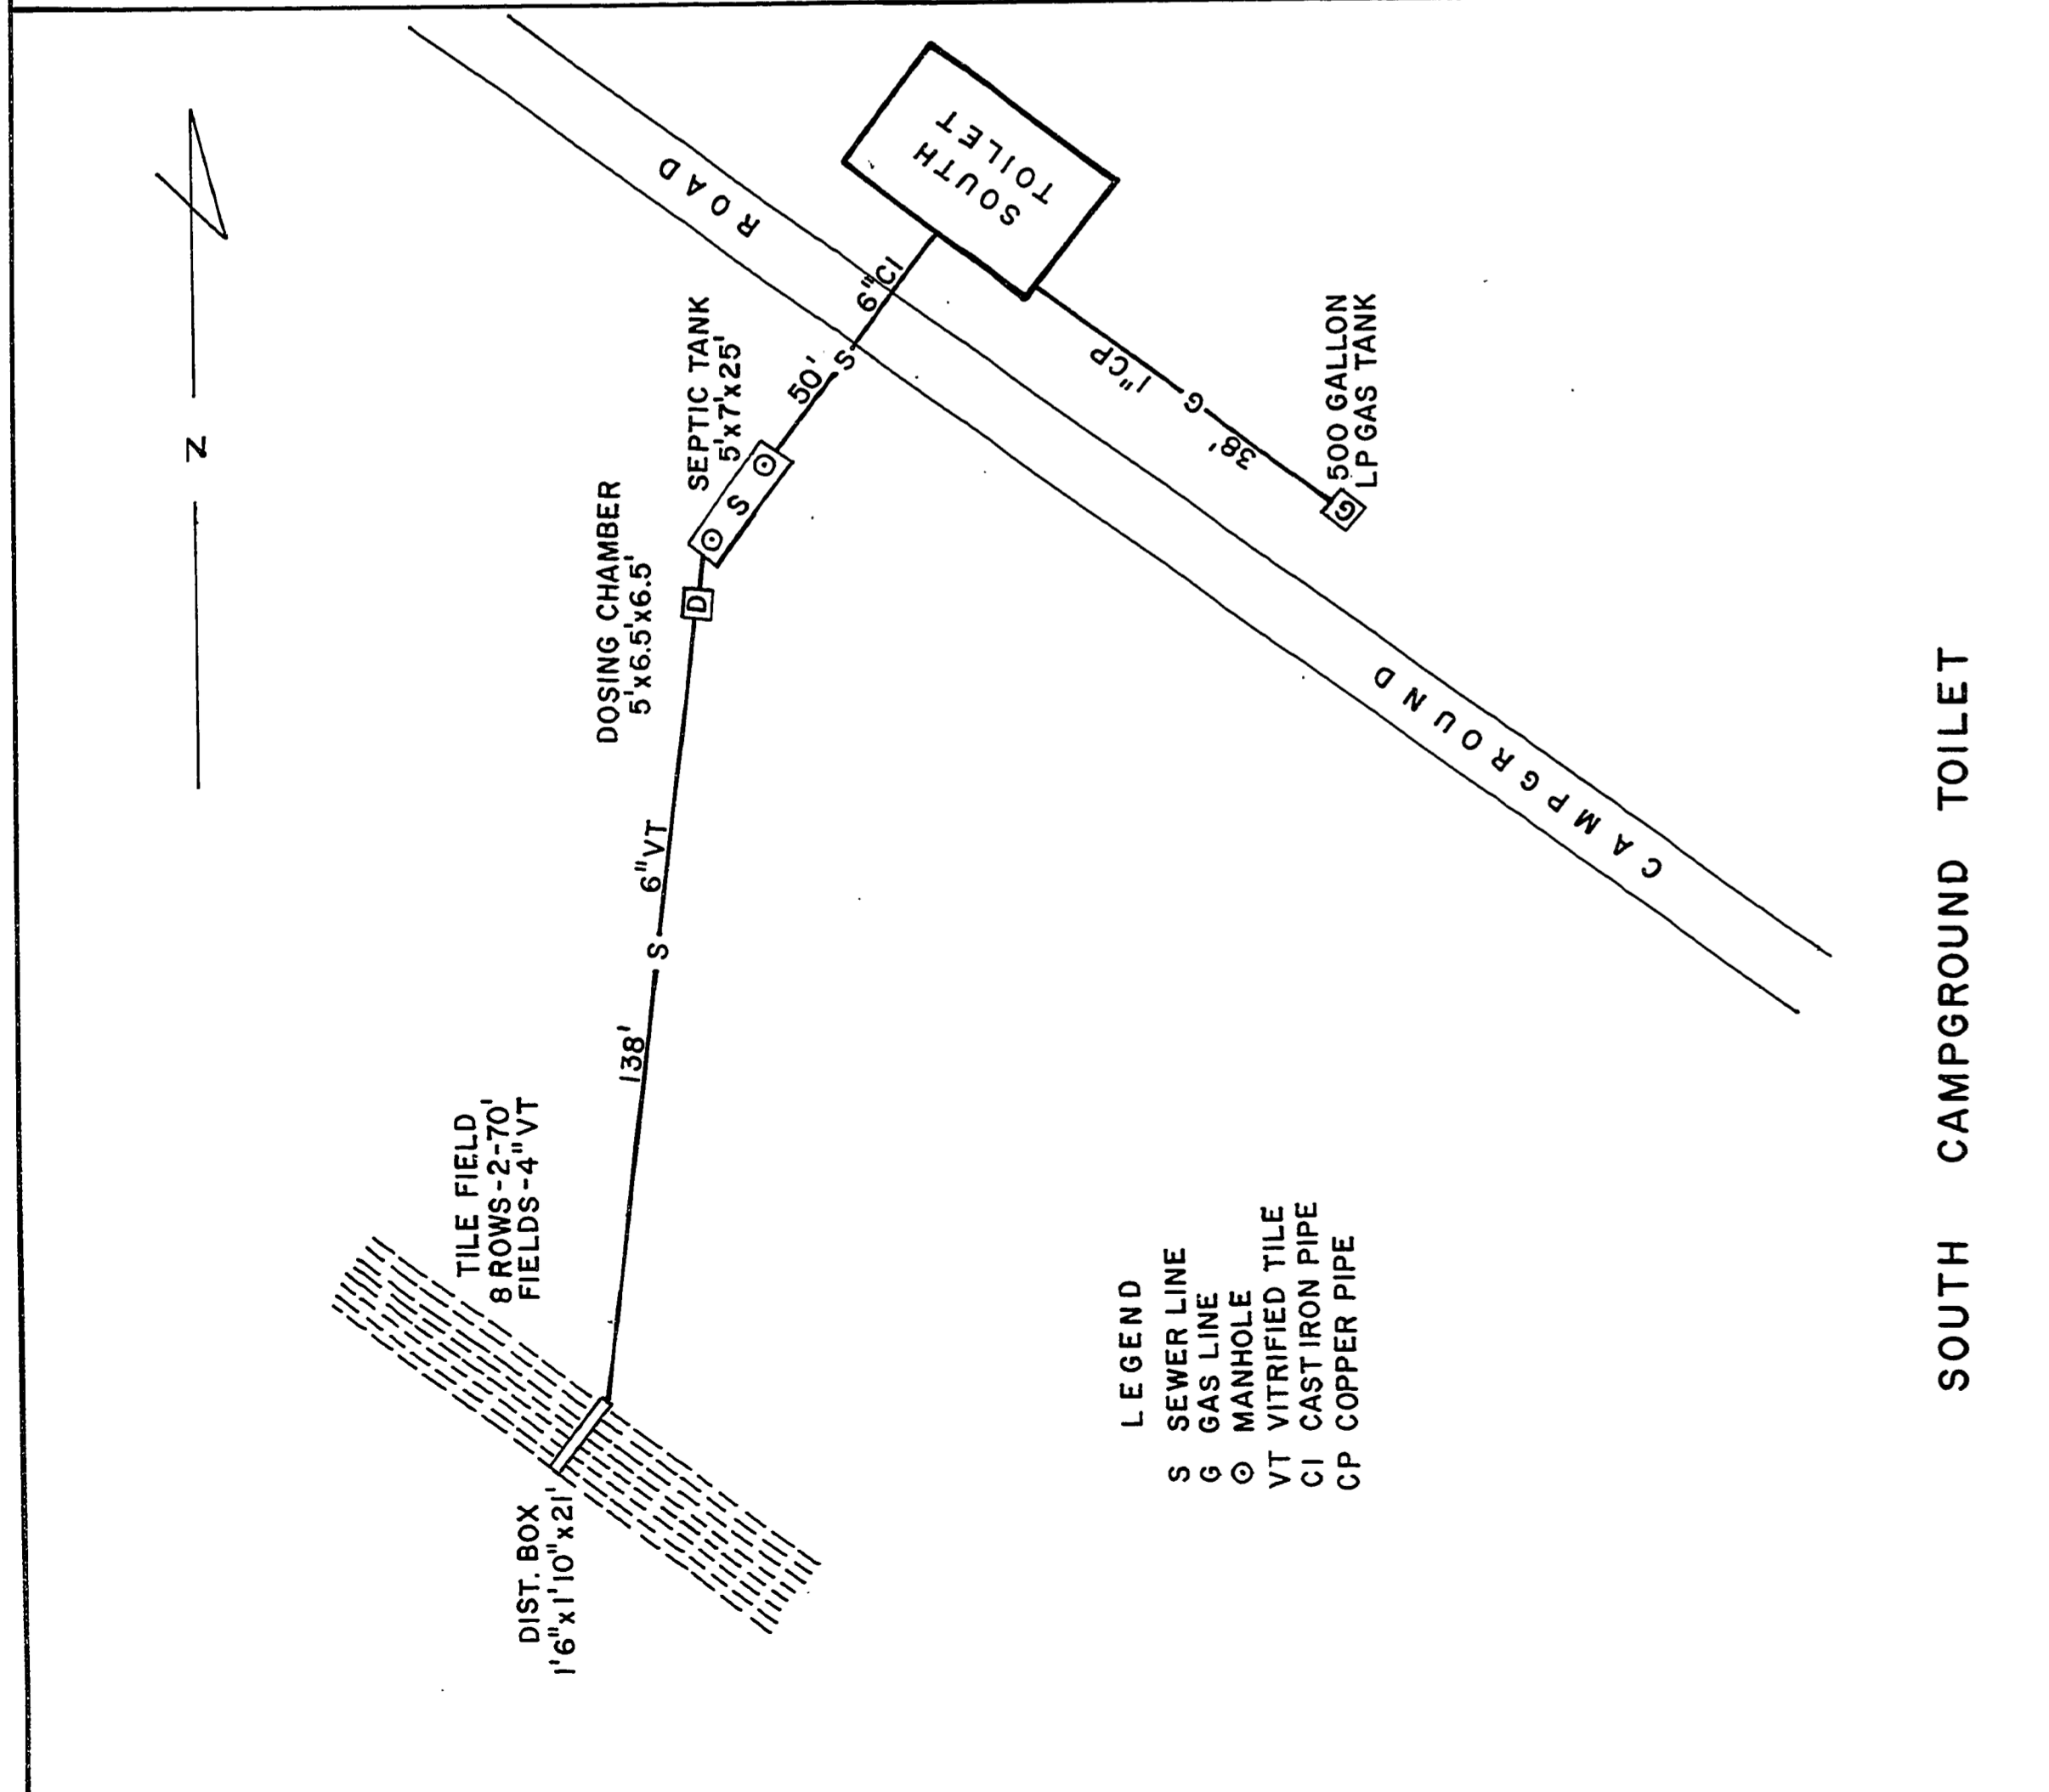


SOUTH CAMPGROUND TOILET

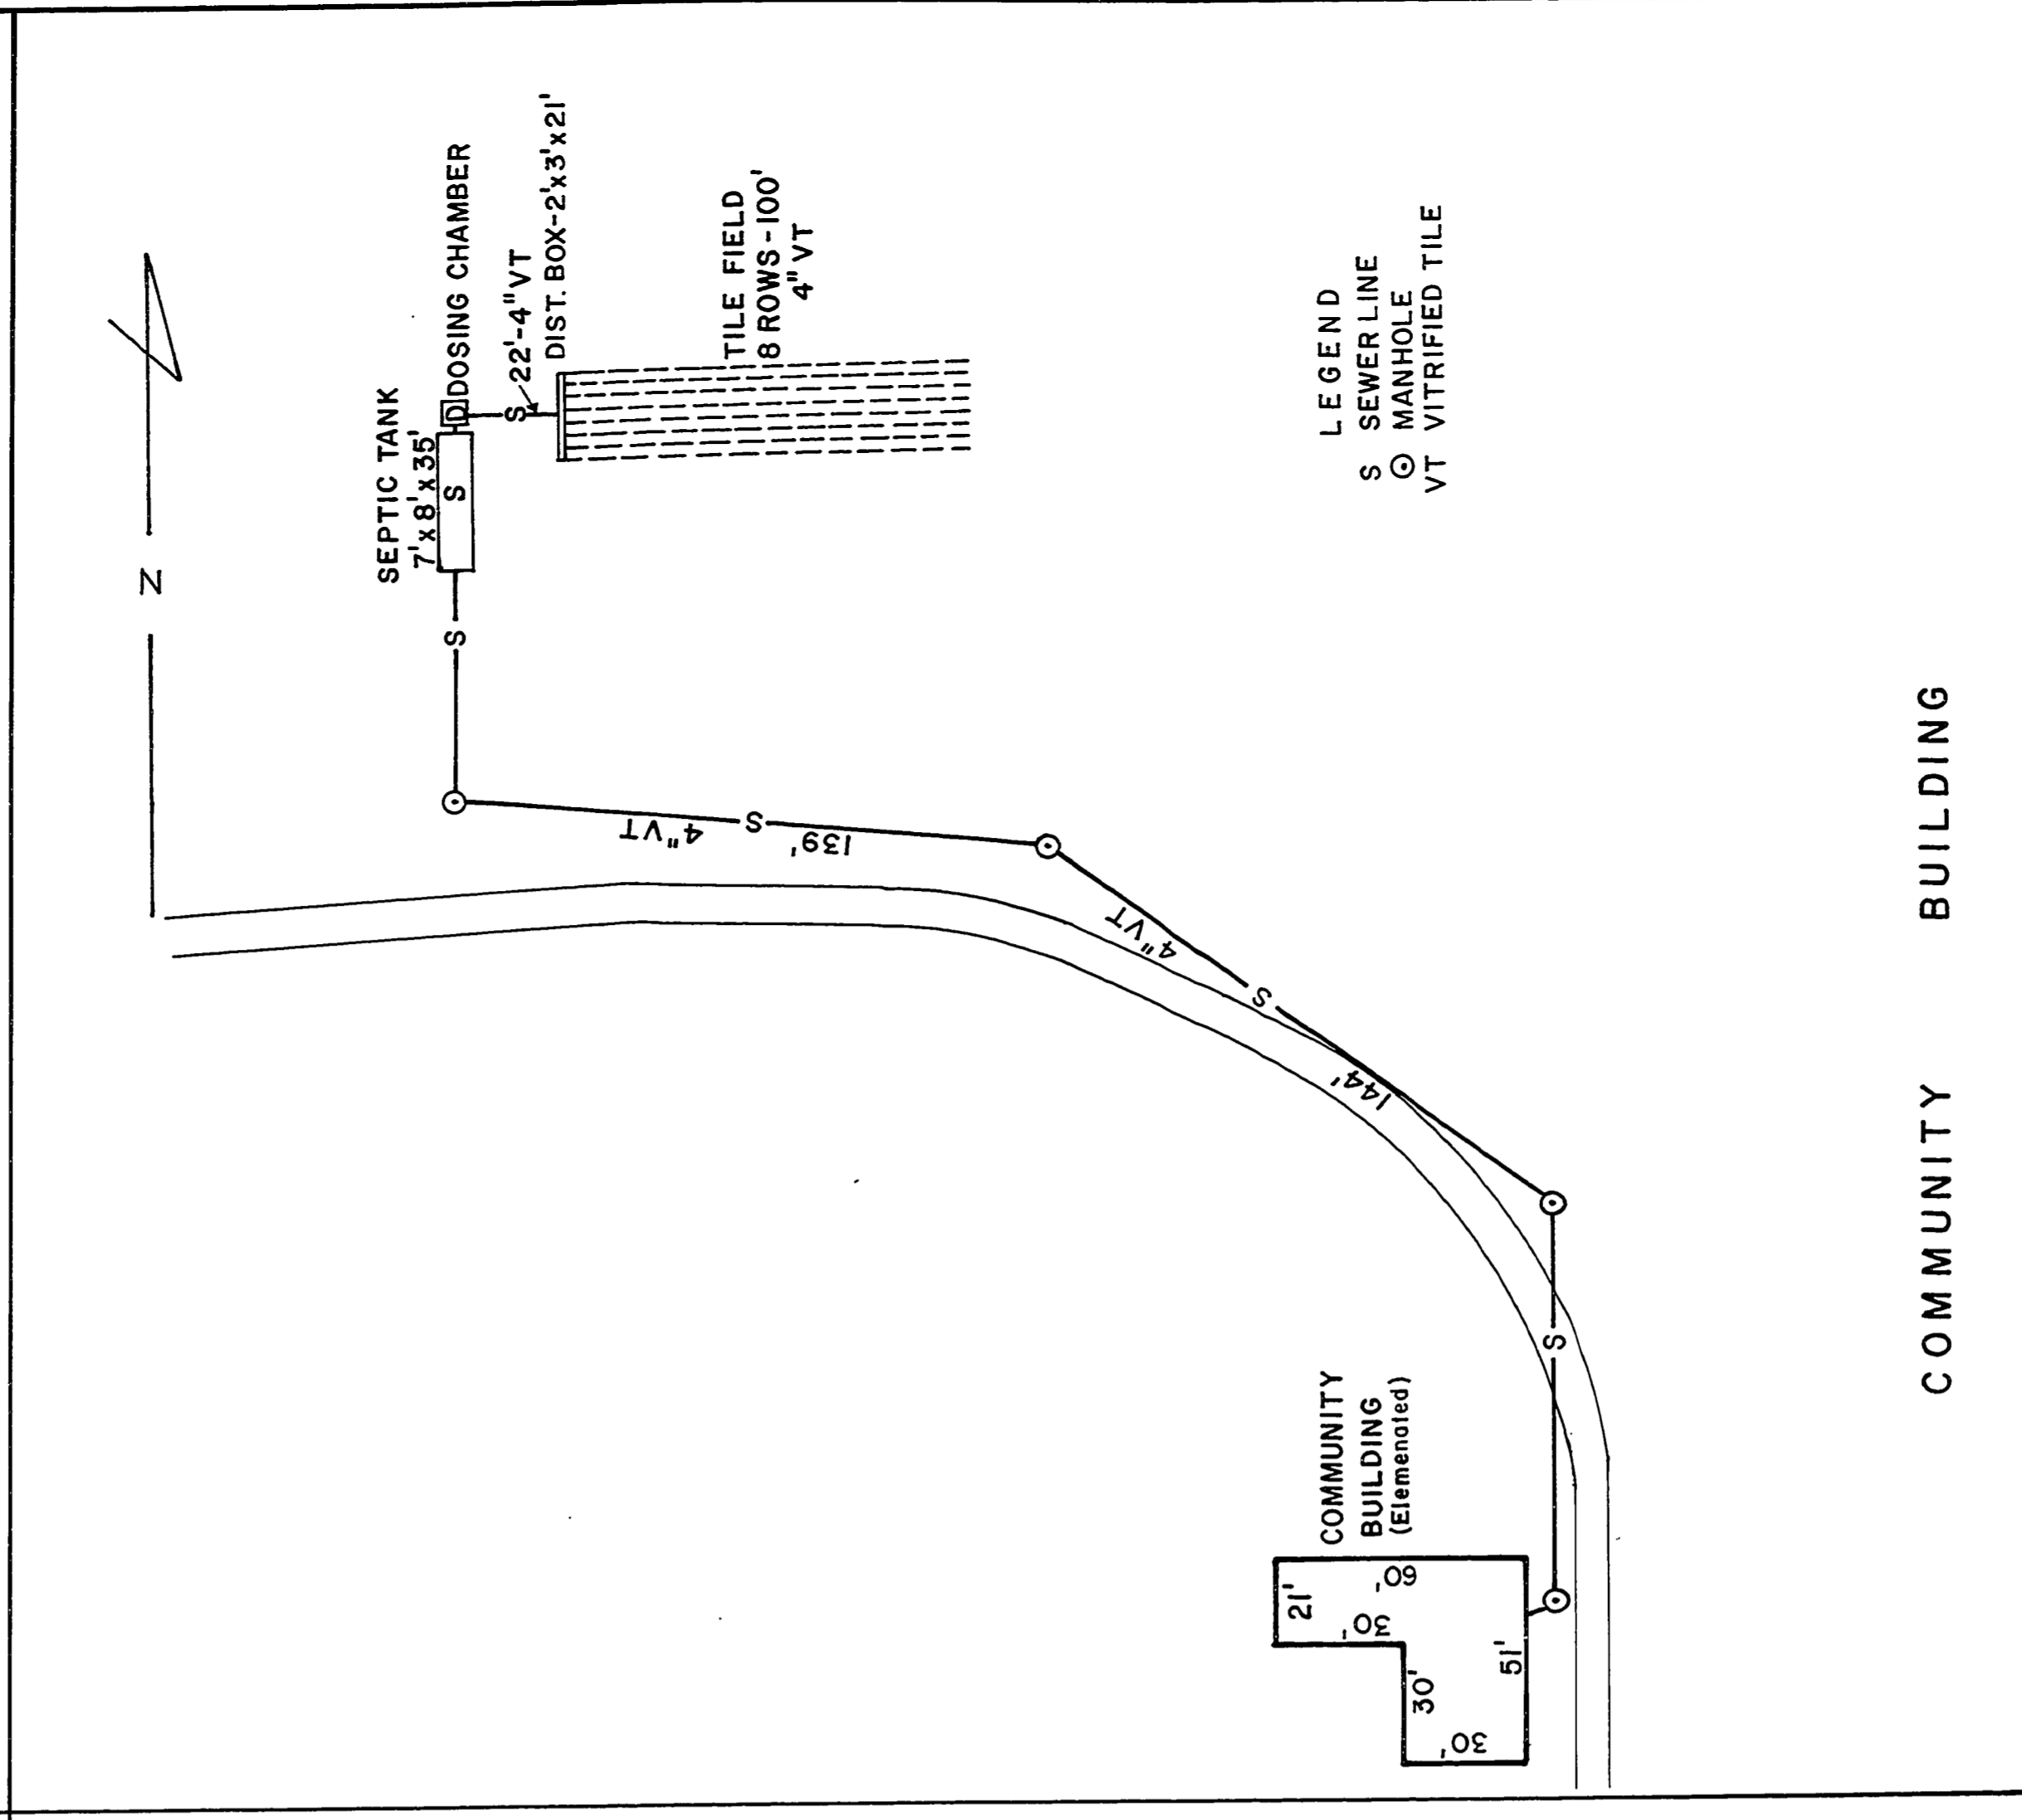

COMMUNITY BUILDING

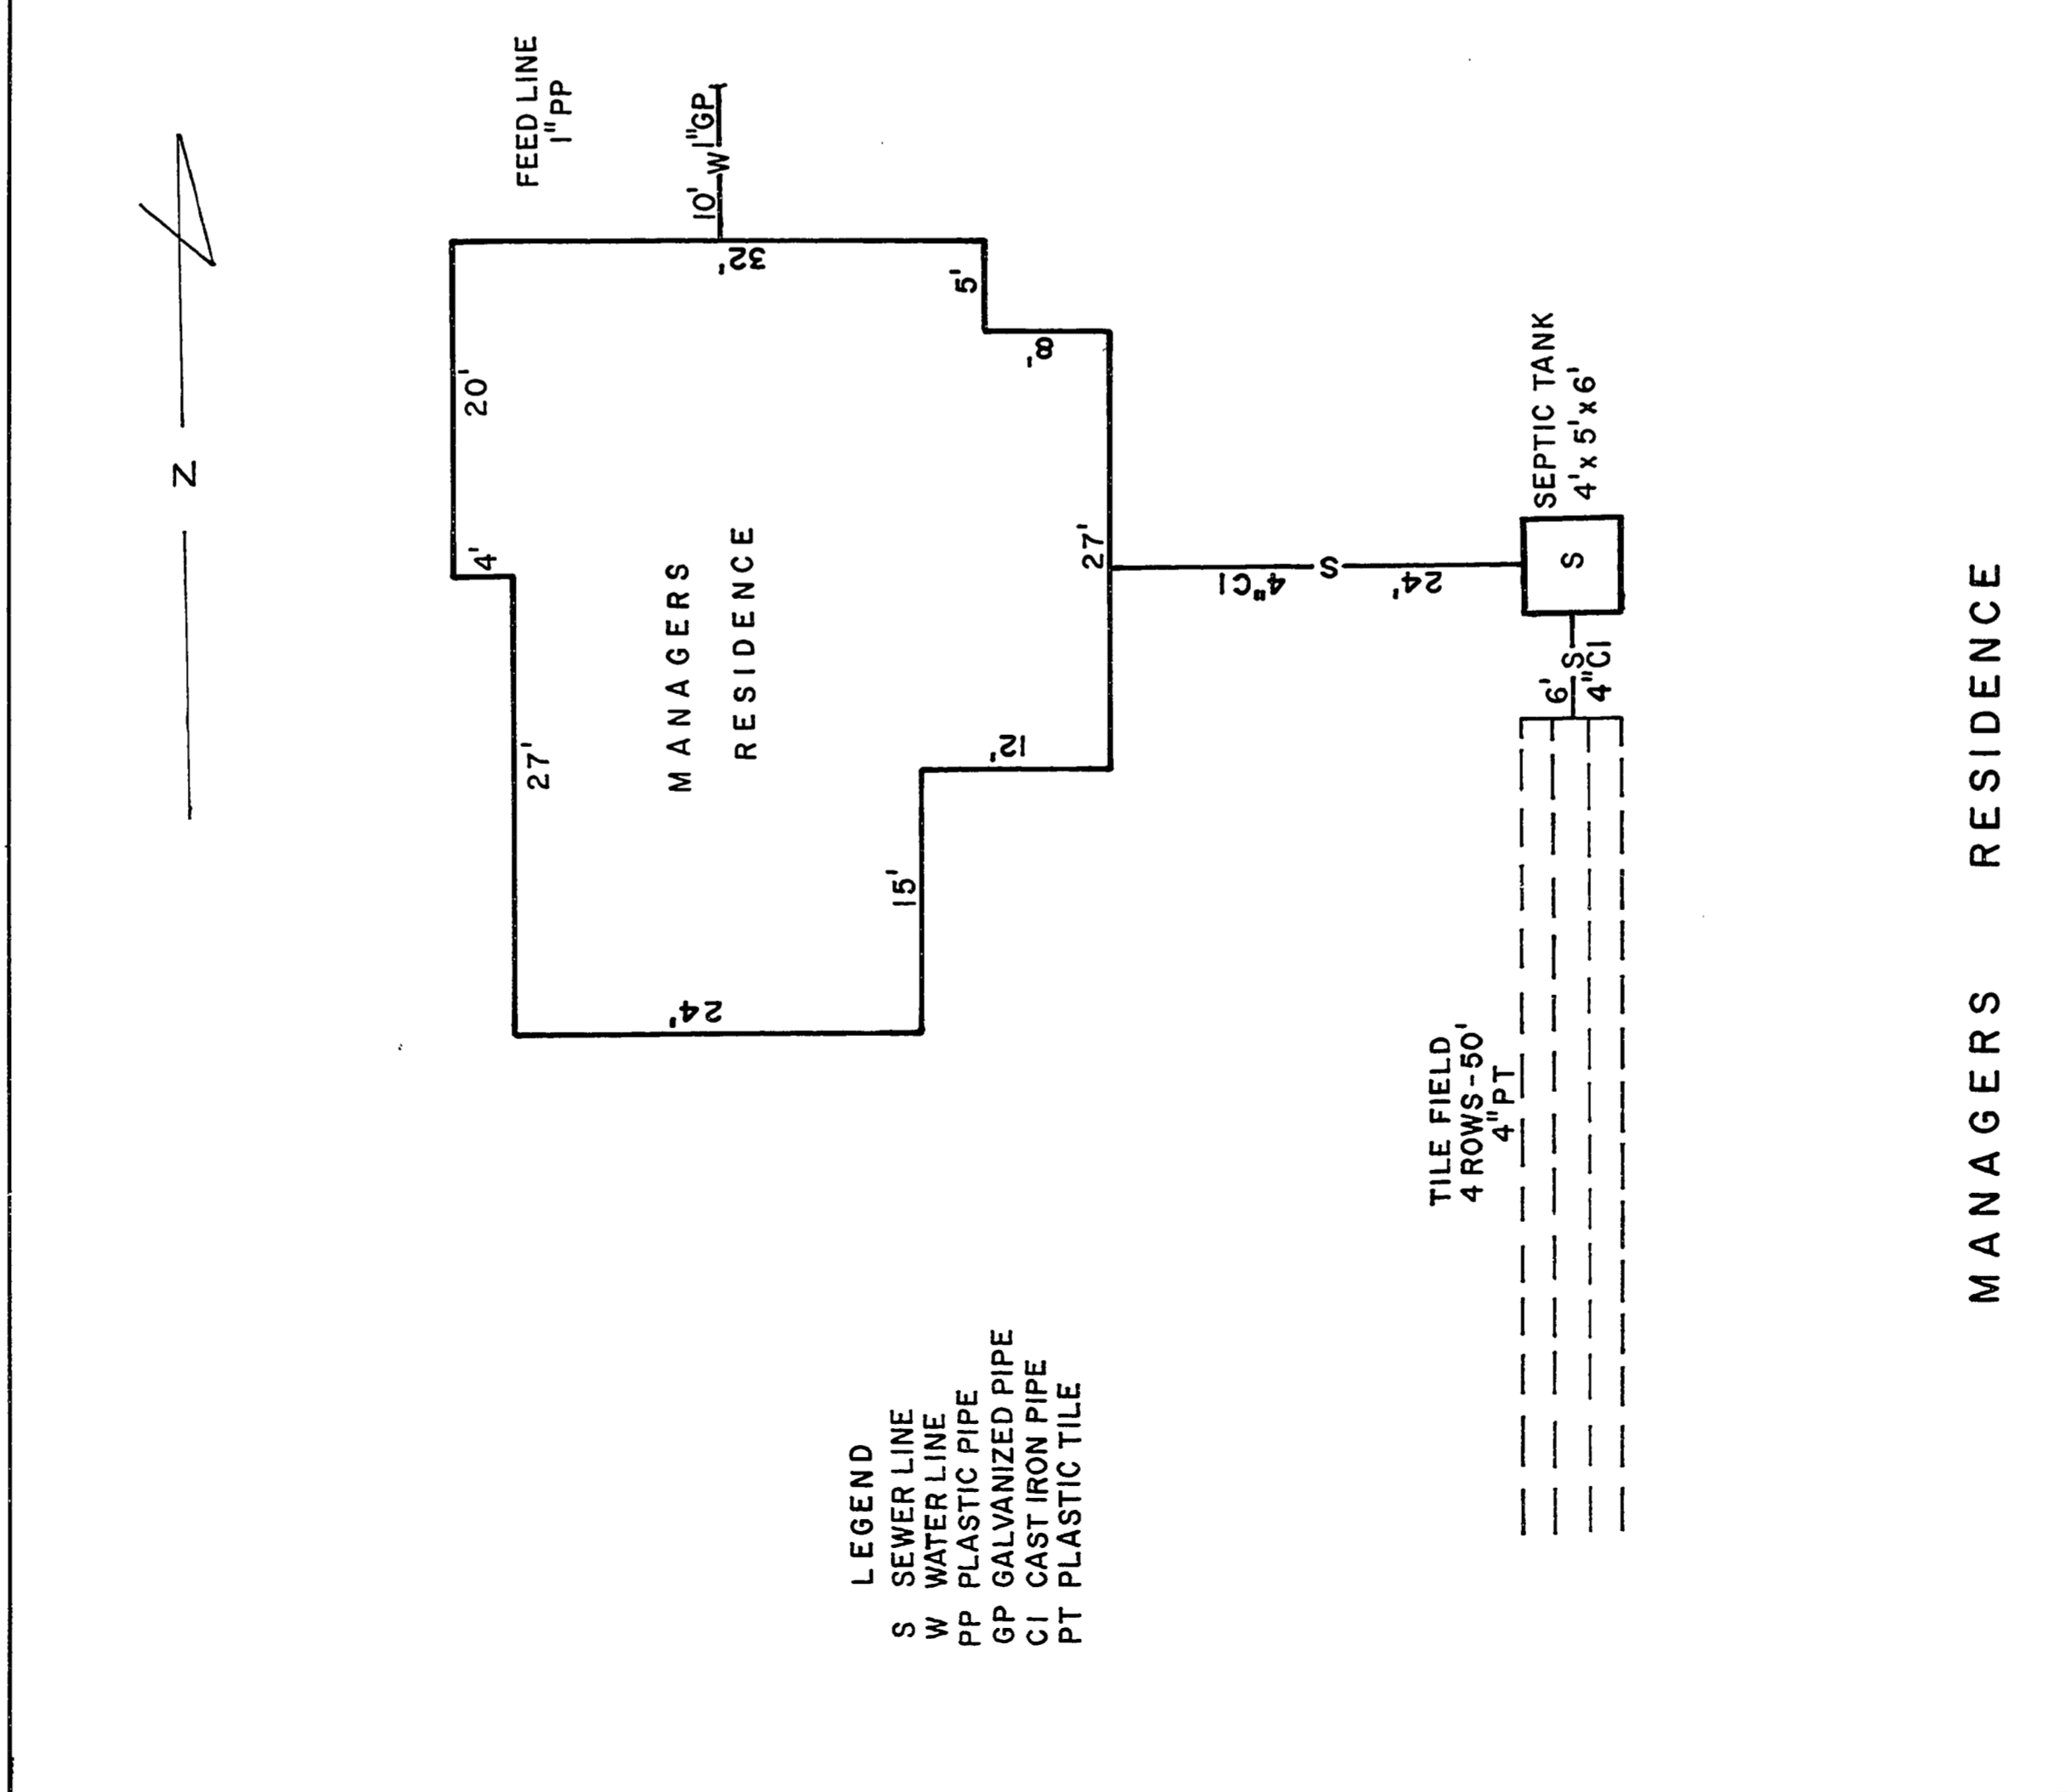

MANAGERS RESIDENCE

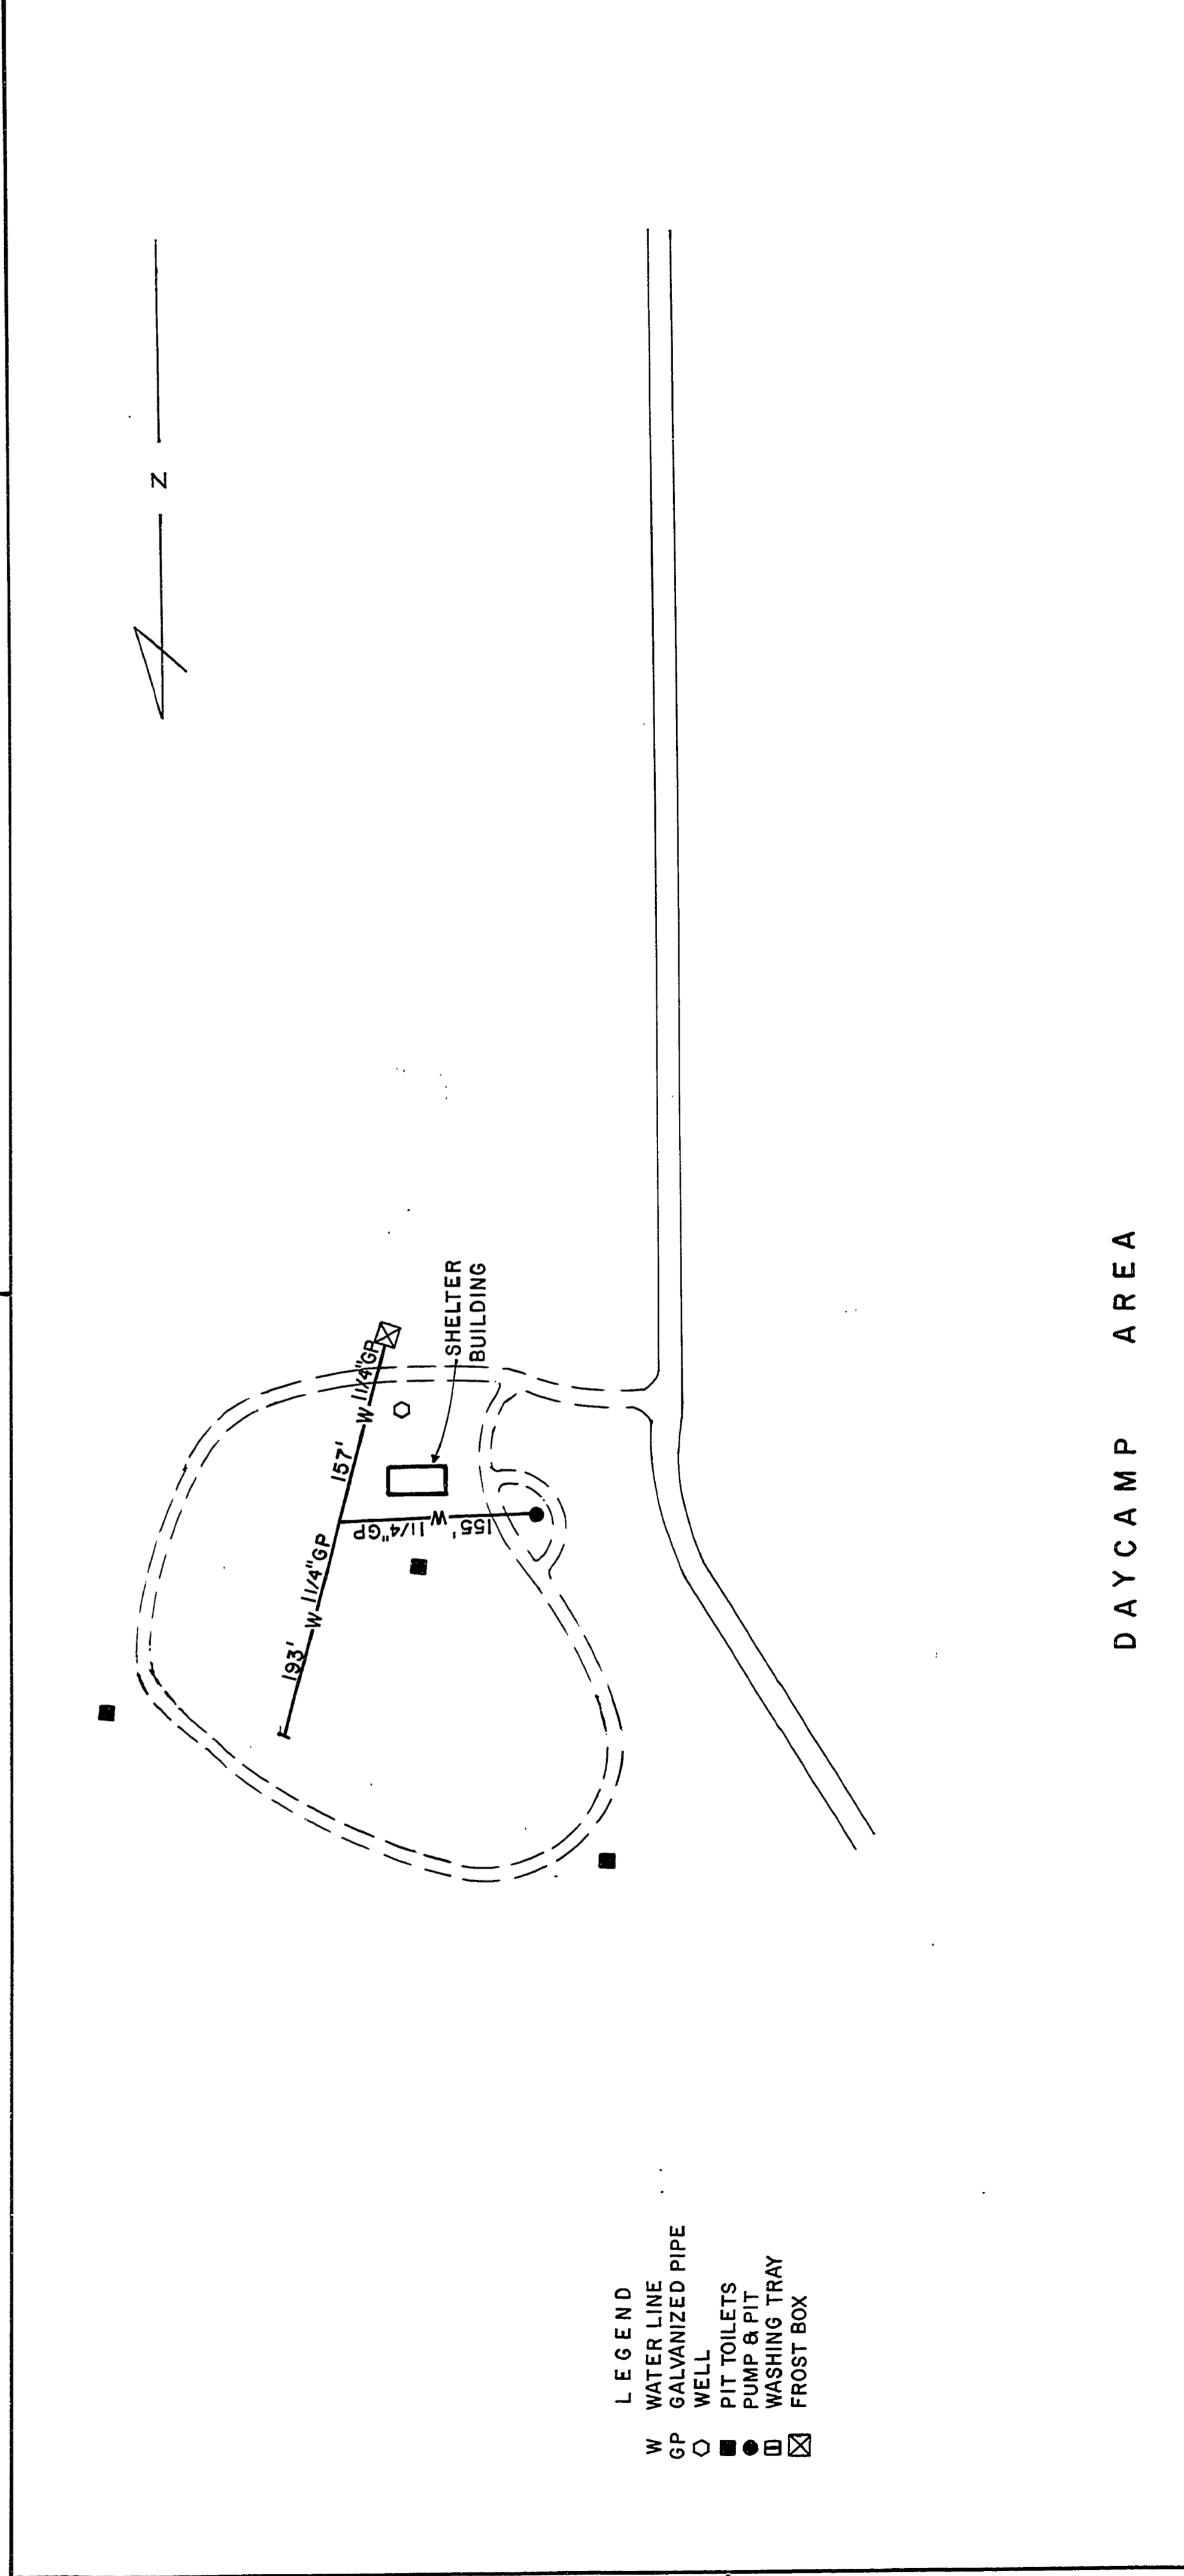

DAY CAMP AREA

SURVEYED BY	DRAWN BY	NO.	DATE	BY	REVISIONS	NO.	DATE	BY	REVISIONS	MICHIGAN DEPARTMENT OF NATURAL RESOURCES	UTILITIES SHEET TITLE	AREA OR PARK MUSKEGON STATE PARK	PROJECT NO.
DESIGNED BY	CHECKED BY	1.	2/81	D.B.	REDRAWN ON MYLAR	3.						MISC.	
DATE	DATE	2.	3/82	WH	UPDATED	4.							SHEET 9 OF 10 PLAN NO. U-1