
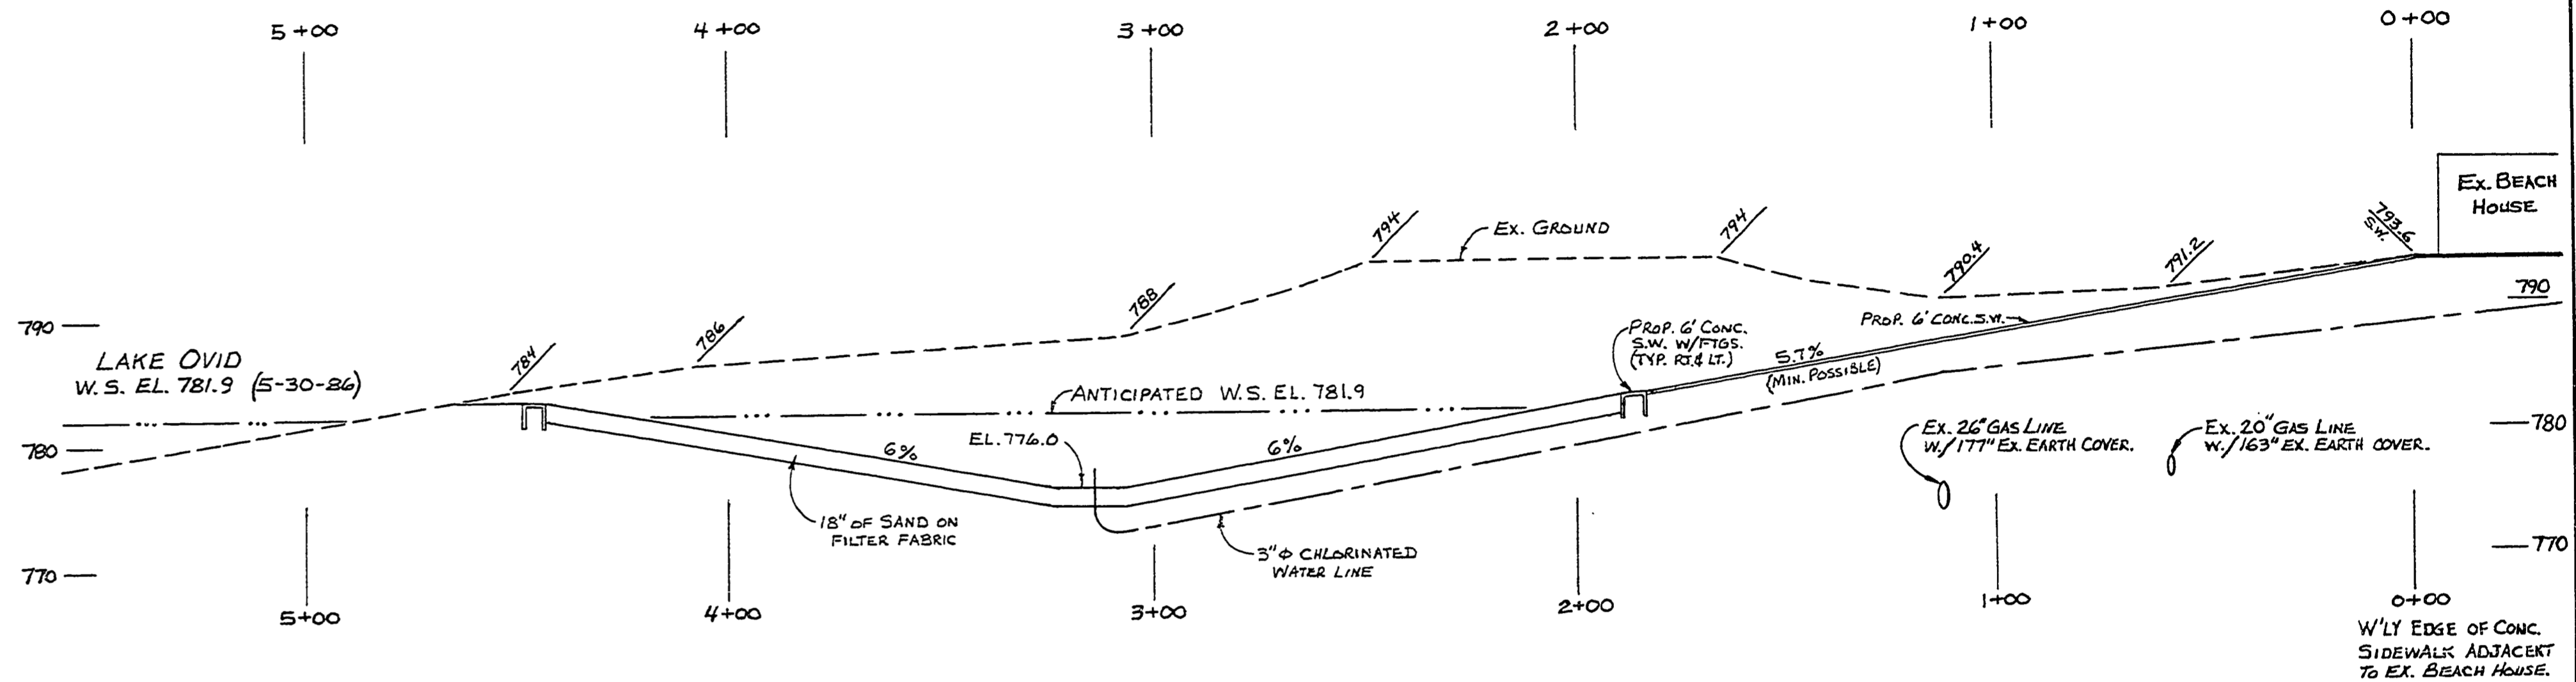



SCALE 1"=50'

LAKE OVID
W.S. EL. 781.9 (5-30-86)

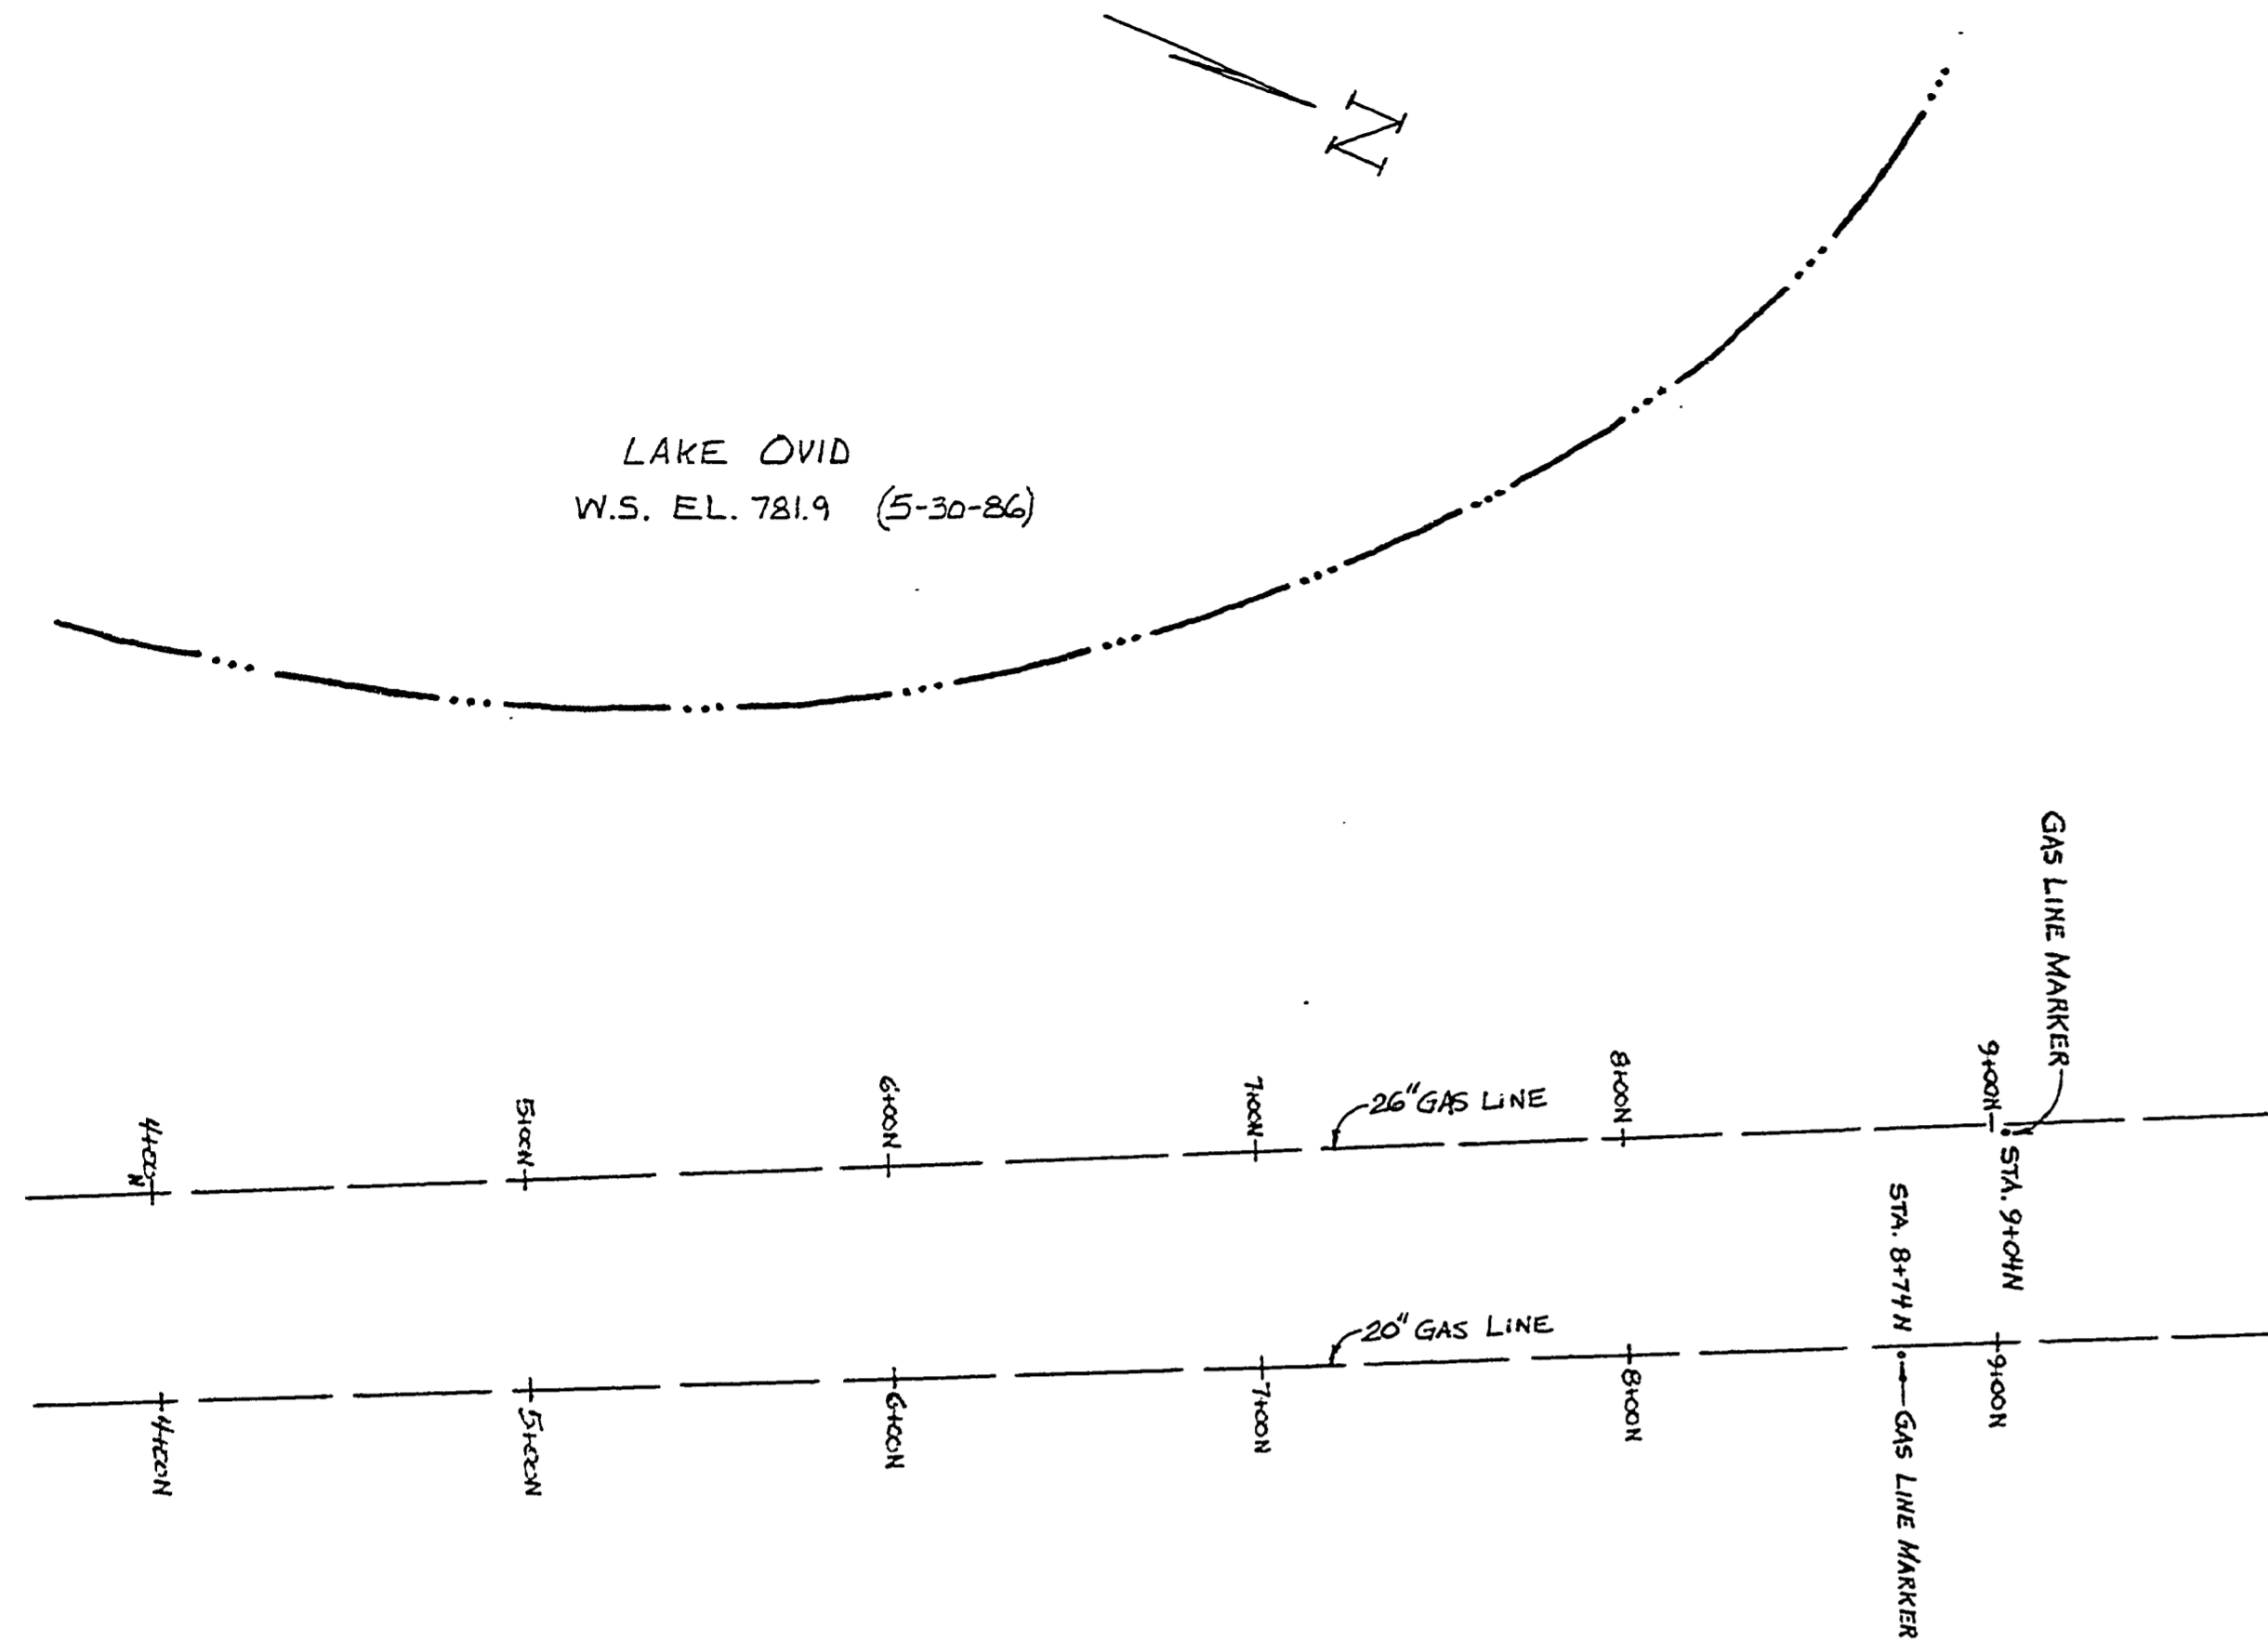

SECTION A-A

VERTICAL SCALE 1"=10'
HORIZONTAL SCALE 1"=30'

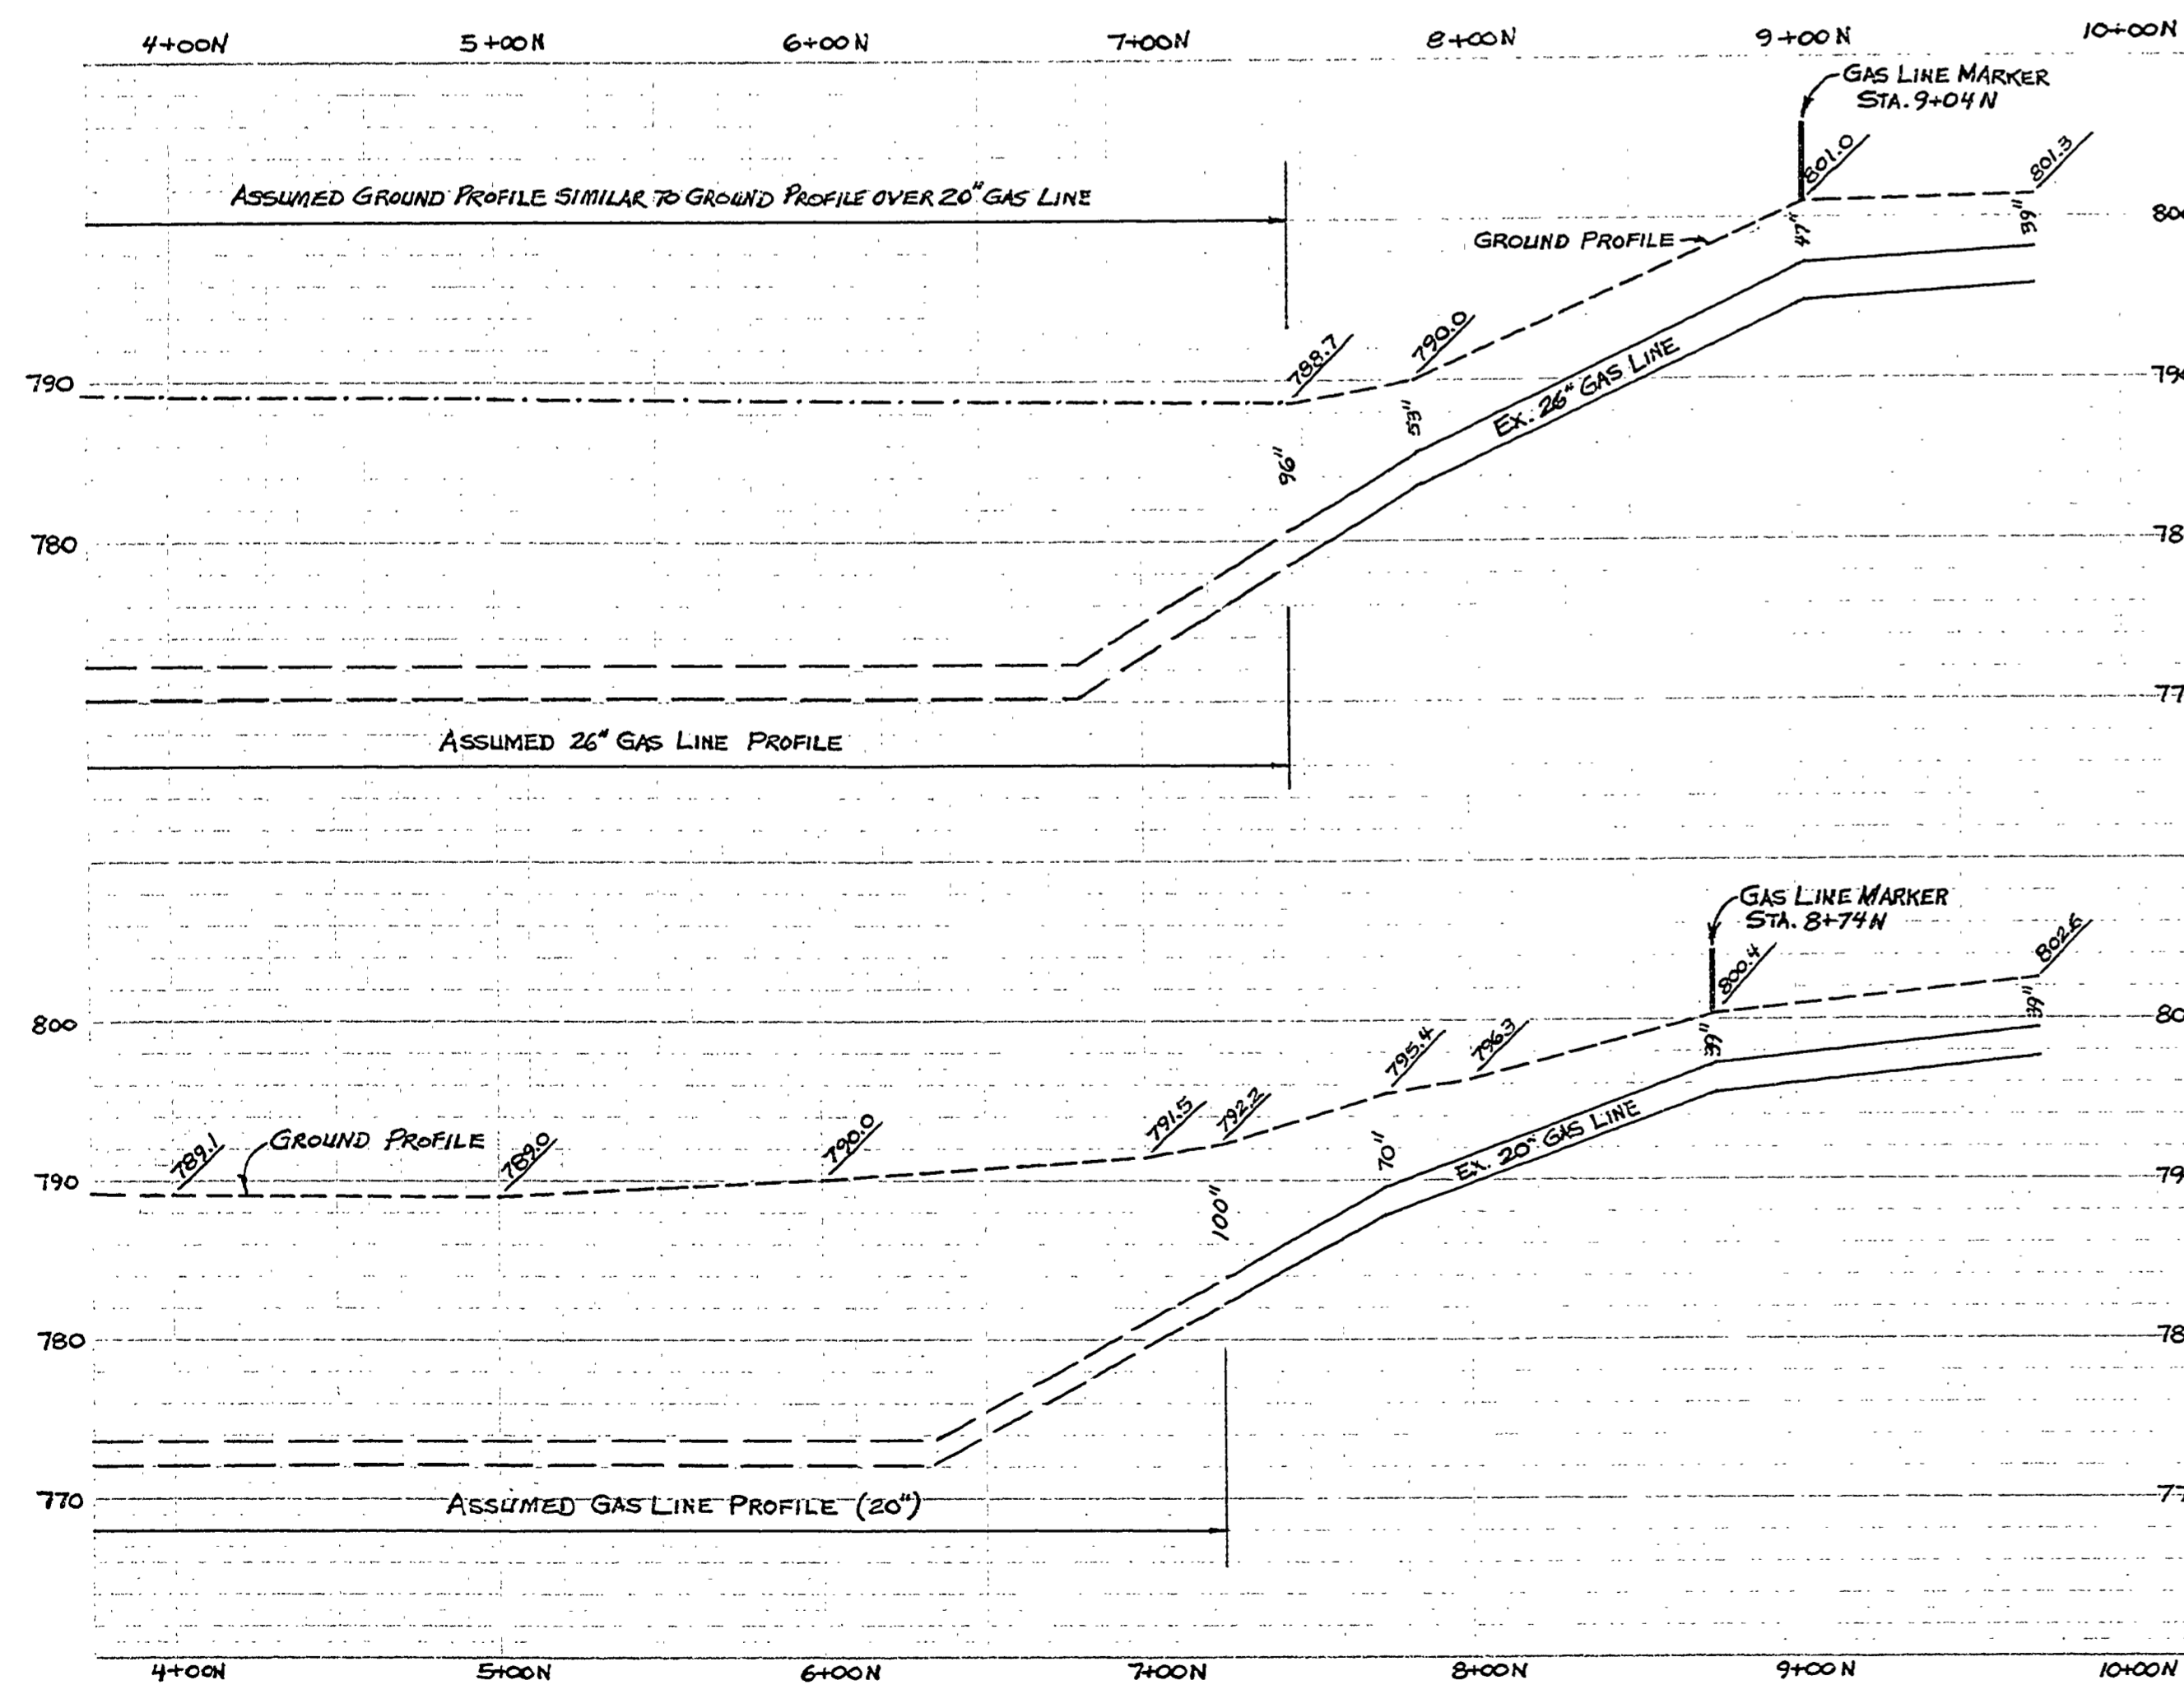

SURVEYED BY	A. EGRES	5/30/86	DRAWN BY	A. EGRES	6/9/86	NO.	DATE	BY	REVISIONS	NO.	DATE	BY	REVISIONS	MICHIGAN DEPARTMENT OF NATURAL RESOURCES	PRELIMINARY SHEET TITLE	AREA OR PARK	SLEEPY HOLLOW S.P.	PROJECT NO.	24-2603		
DESIGNED BY			CHECKED BY			1.				3.						PROJECT	POND DEVELOPMENT	SHEET	2 OF 2	PLAN NO.	E-114
						2.				4.											