


# HOFFMASTER STATE PARK

## MUSKEGON COUNTY, MICHIGAN

### SHEET INDEX

SHEET NO.	DESCRIPTION
1	COVER SHEET
2	PARK RESIDENCE UTILITY CONNECTION
3	WATERMAIN CONNECTION TO MUNICIPAL SYSTEM
4	SANITARY CONNECTION TO MUNICIPAL SYSTEM
5	PROFILE SANITARY SEWER
6	PROFILE SANITARY SEWER
7	LIFT STATION
8	WATERMAIN DETAILS
9	SANITARY SEWER DETAILS

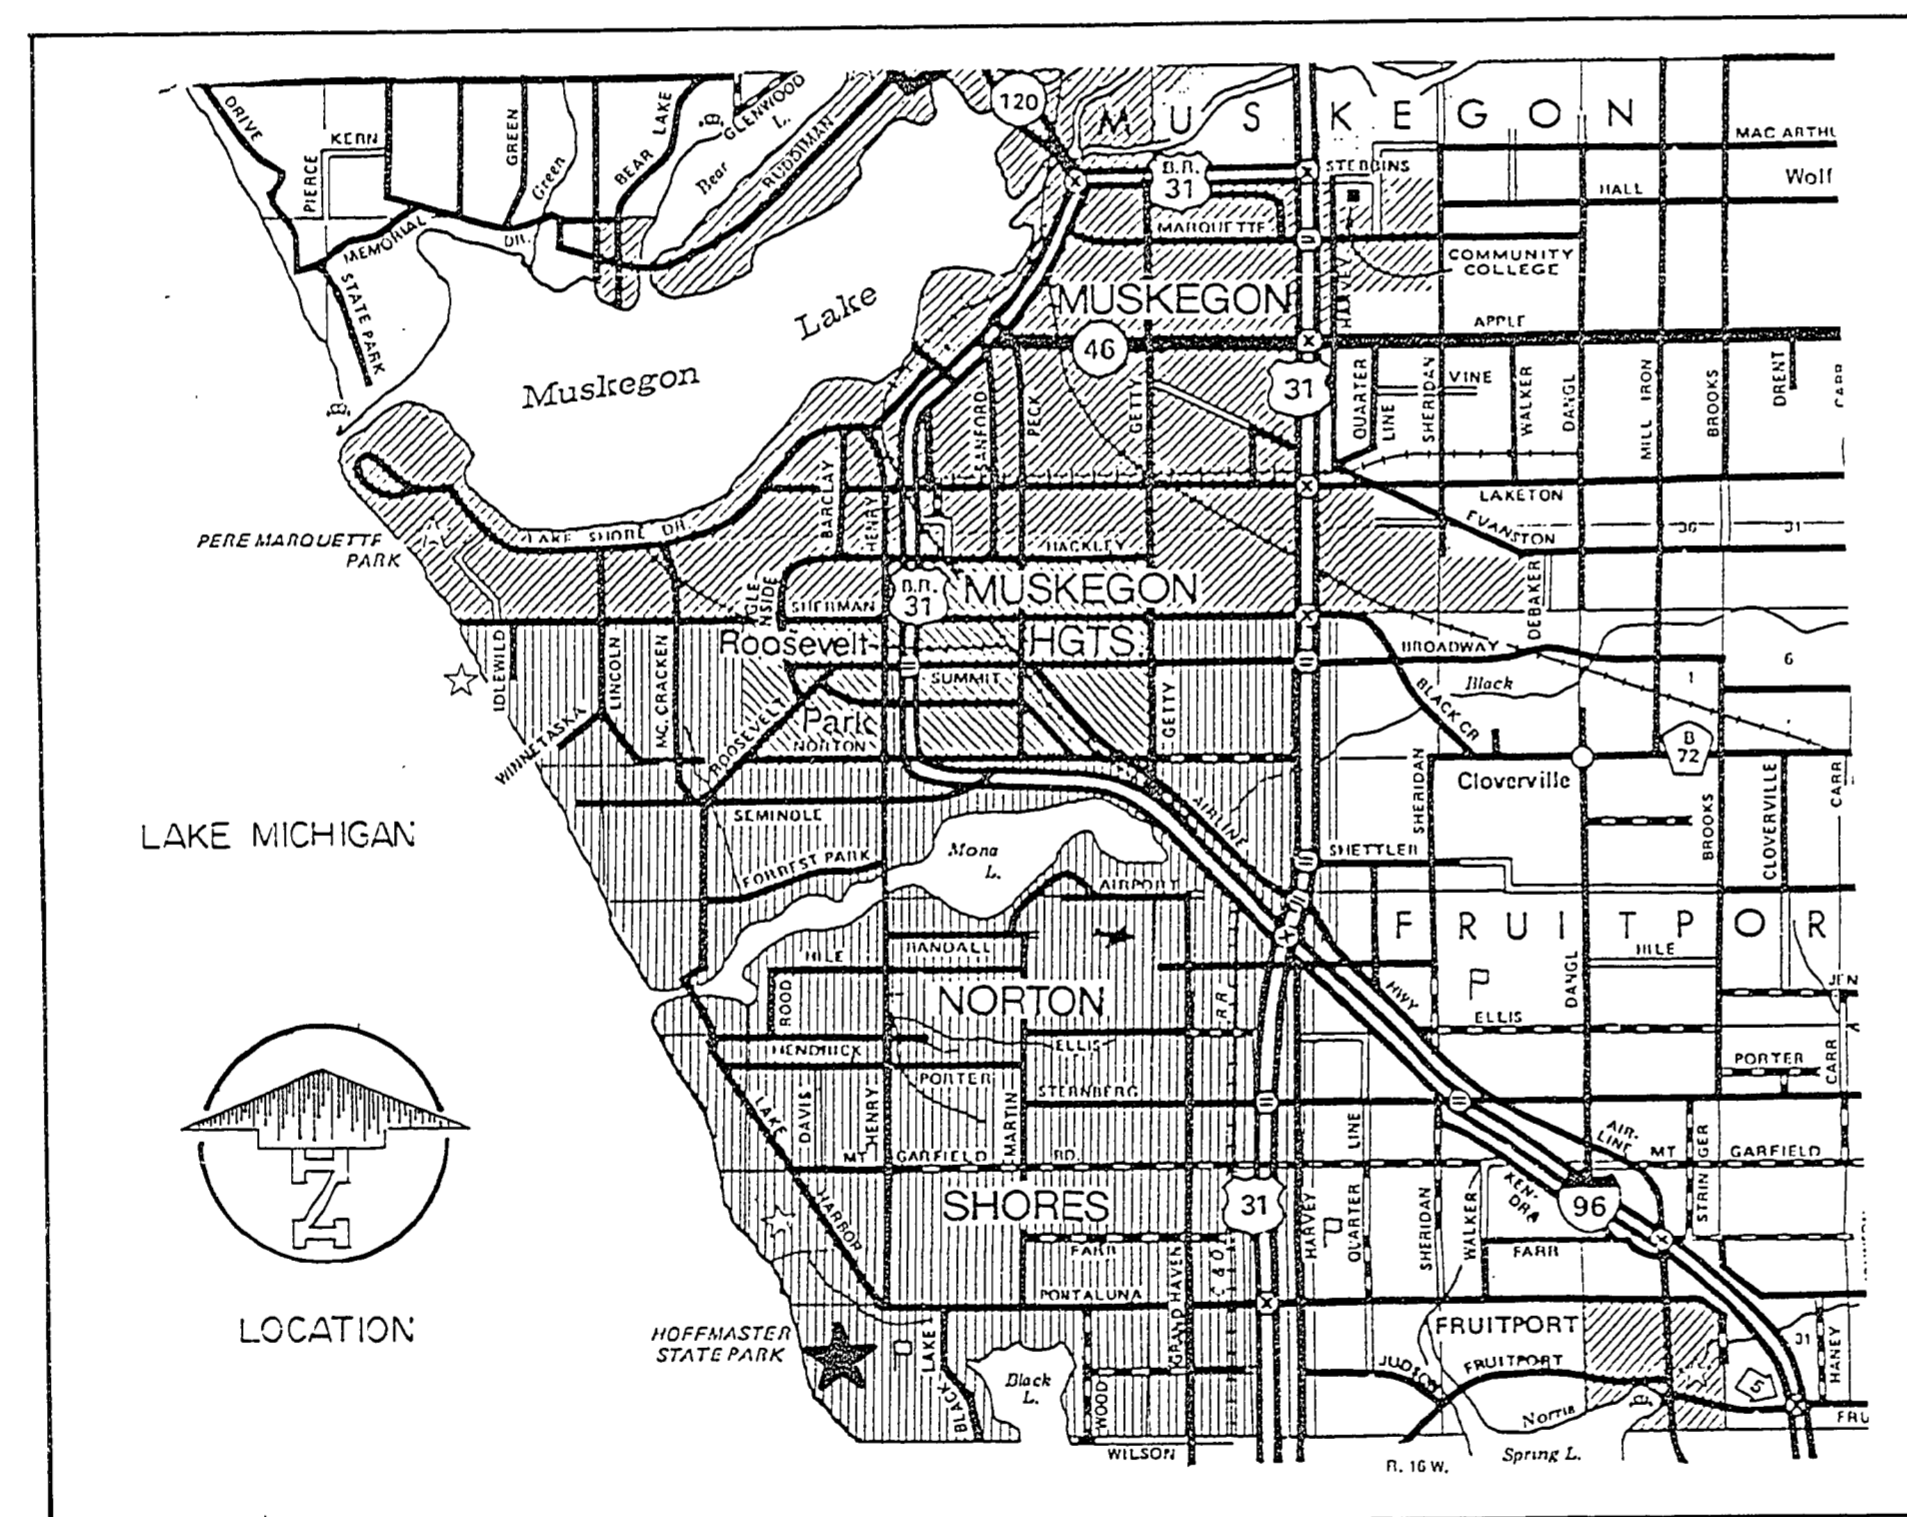

#### MICHIGAN UNIFIED KEYING SYSTEM SOIL EROSION AND SEDIMENTATION CONTROL MEASURES

- 5 SEEDING
- 10 MULCHING
- 12 COMPACTION
- 14 AGGREGATE BASE
- 15 PAVING
- 21 FILTER BERM
- 22 BRUSH FILTER
- 33 SEDIMENT TRAP
- 43 CULVERT SEDIMENT TRAP

**PROTECTING MICHIGAN'S FUTURE  
AREA 1-B  
LAKE MICHIGAN SHORELINE**


RECORD DRAWING 9/92

DEPARTMENT OF NATURAL RESOURCES

**APPROVED**

*Henry van Buren* 9-4-90  
CHIEF, PARKS DIVISION DATE

L-118 1089

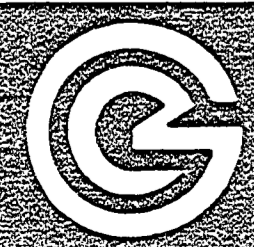

**CHRISTMAN**  
CONSTRUCTION SERVICES  
CONSTRUCTION MANAGERS • GENERAL CONTRACTORS • CONSTRUCTION ENGINEERS • CONSTRUCTORS  
Main Office: 408 N. W. 10th St., Lansing, Michigan 48933 P.O. Box 14120 48901 Phone: 517-482-1488  
First Office: 63512 W. Grand Road, Farmington, Michigan 48307 P.O. Box 248 48301 Phone: 313-234-6633

ARCHITECTS  
ENGINEERS  
PLANNERS  
SURVEYORS

**GOVE ASSOCIATES, INC.**  
1601 Portage Street  
Kalamazoo, Michigan  
(616) 385-0011



STATE OF MICHIGAN  
DEPARTMENT OF MANAGEMENT AND BUDGET  
Office of Facilities

SHEET	IDENTIFICATION NO.	ISSUED FOR	DATE	DESIGNED
PROJECT		PRELIMINARY		DRAWN
STATE ACCOUNT		CONSTRUCTION		CHECKED
#607-75-2450-400		FINAL RECORD		APPROVED

