


DESIGNED BY	DRAWN BY	CHECKED BY	REVIEWED		APPROVED		DATE			NO.			DATE			REVISIONS		
			DATE	BY	DATE	BY	1	2	3	1	2	3	4	5	6			

LAKE MICHIGAN

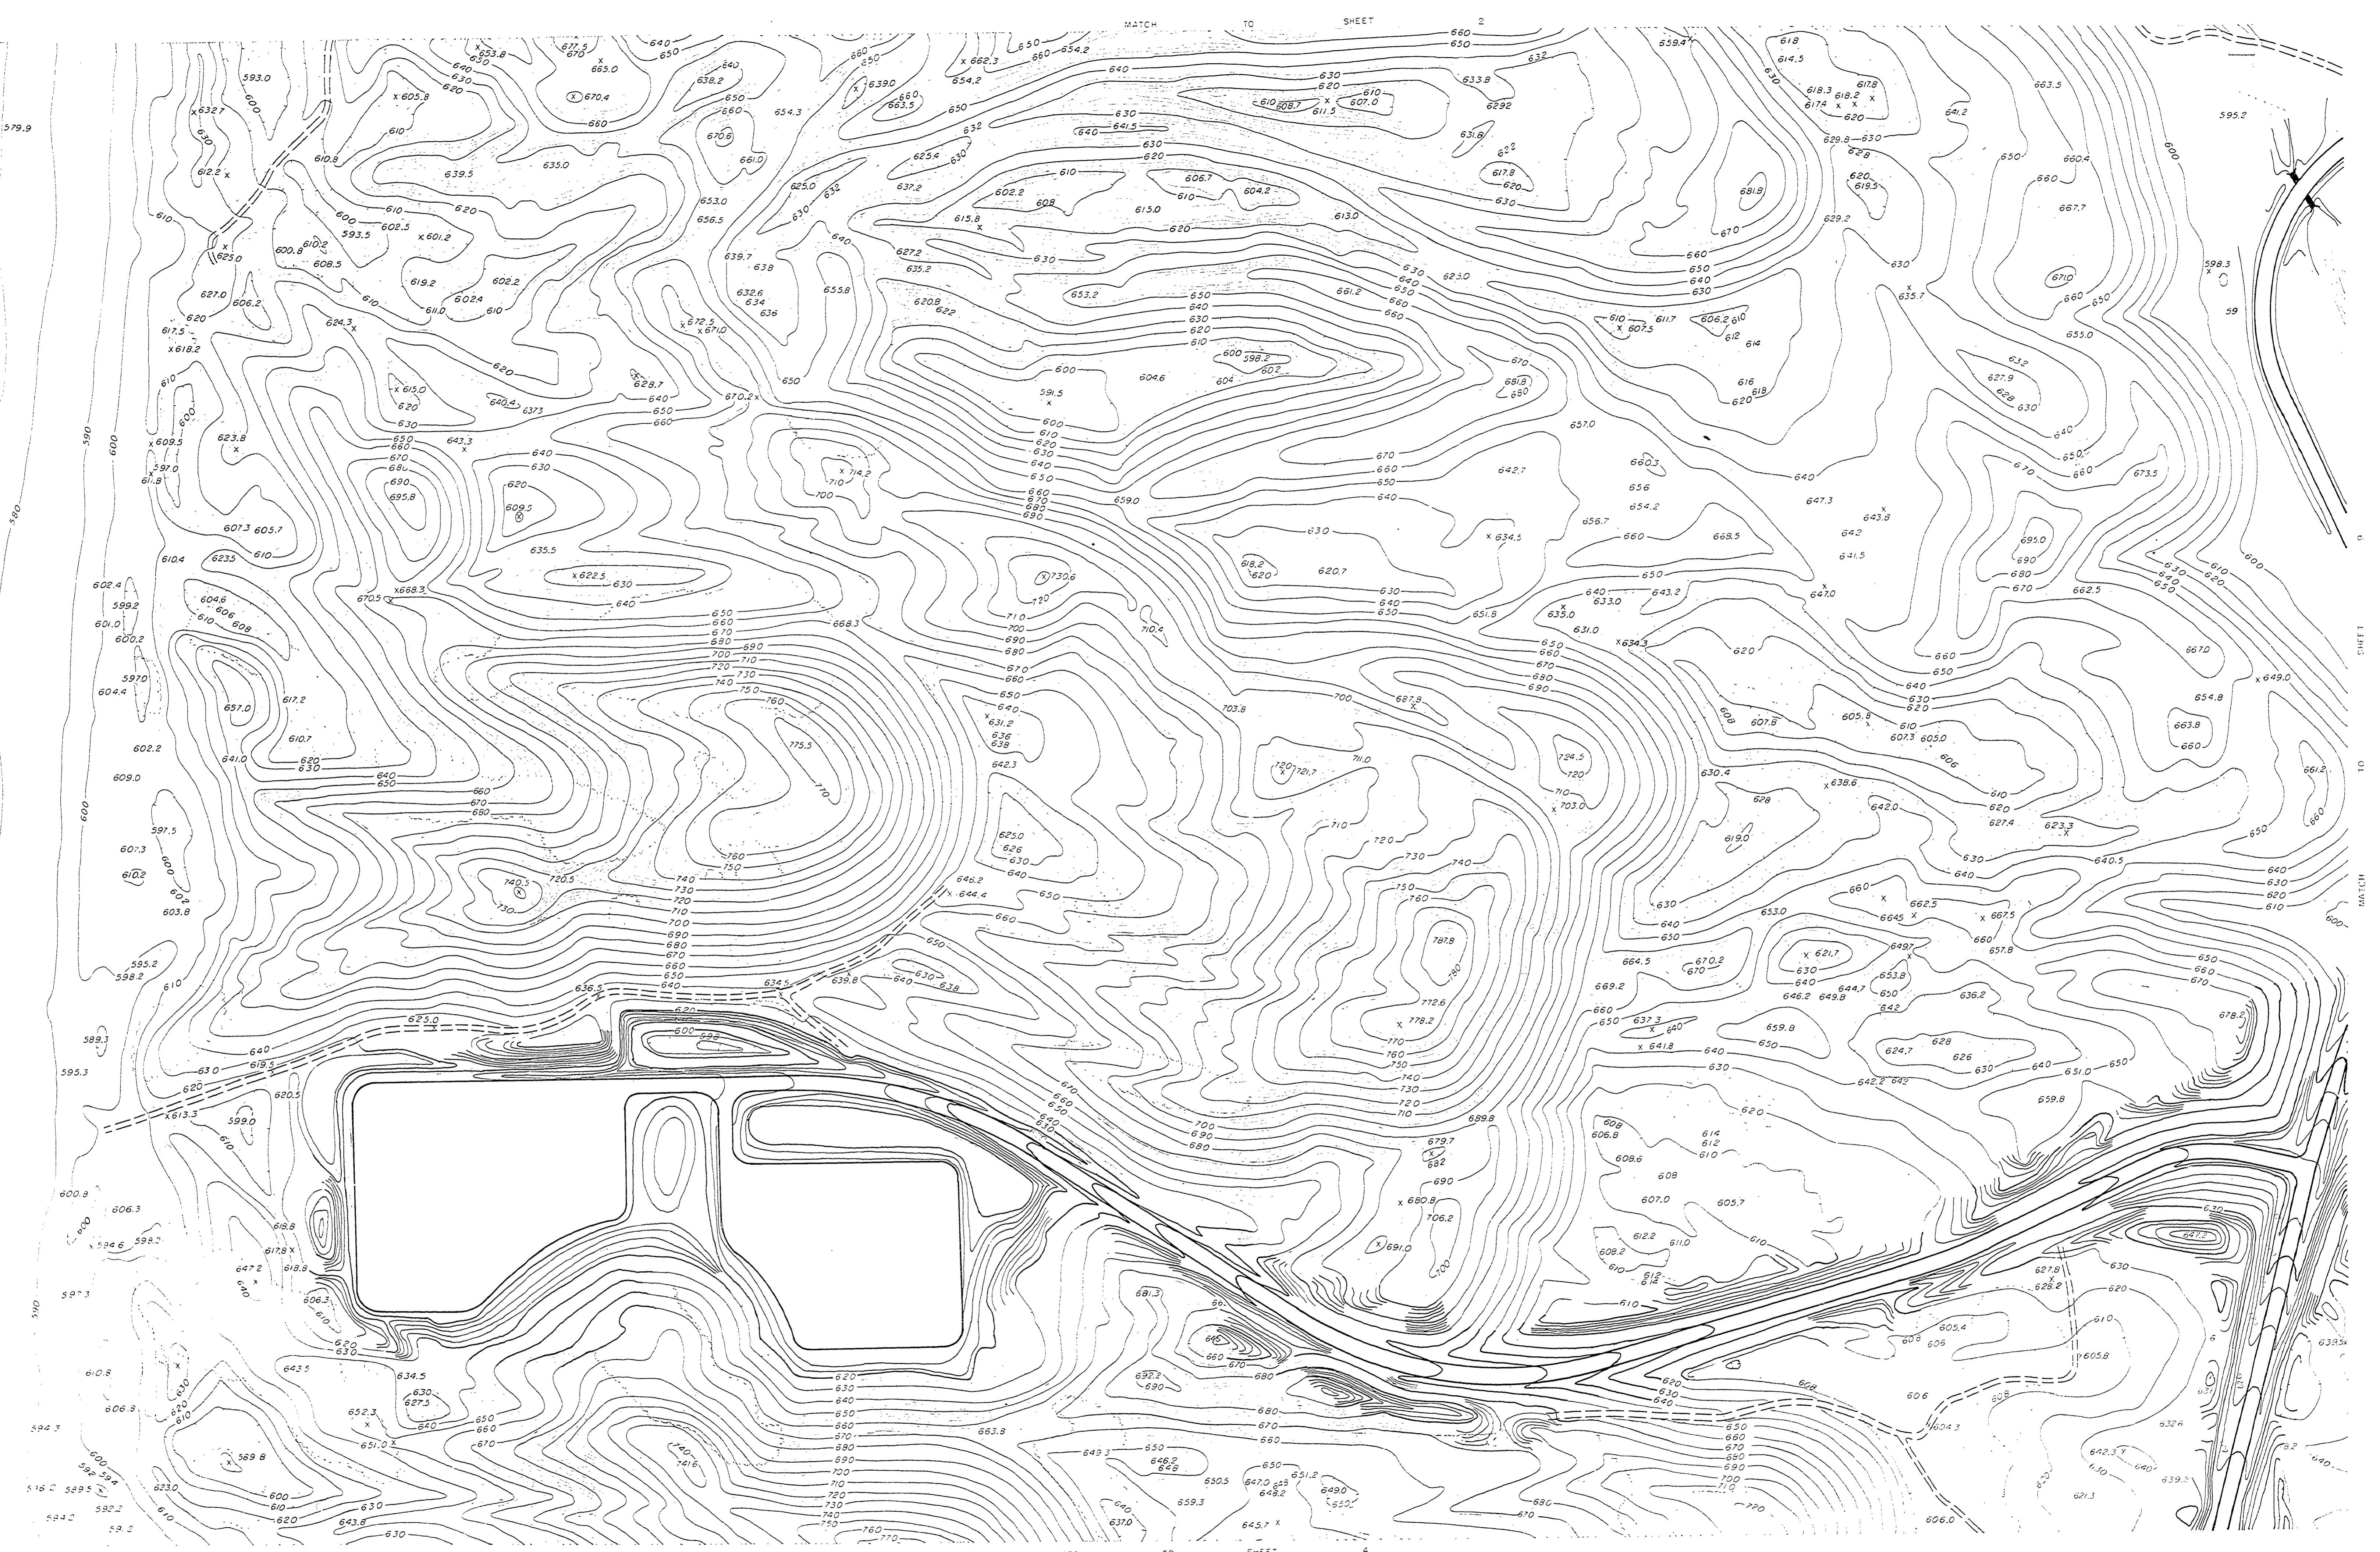

PRIMARY ROADS	BUILDINGS	BRIDGES	VERTICAL CONTROL - M.S.L.
SECONDARY ROADS	PERENNIAL STREAMS	CULVERT	TREES
RAILROADS	INTERMITTENT STREAMS	TRAVERSE STATION	TREES (DECIDUOUS)

ABRAMS AERIAL SURVEY CORPORATION
LANSING, MICHIGAN

MICHIGAN
DEPARTMENT OF CONSERVATION
PARKS AND RECREATION DIVISION

HOFFMASTER STATE PARK		SHEET	PLAN NO.
SCALE 1" = 100'	AS-BUILT DWG.	NO. 3	L-95
DATE OF PHOTOGRAPHY APRIL 1962	CONTOUR INTERVAL 2'	OF 12	
	DATE OF MAPPING JANUARY 1963		