


DESIGNED BY	DATE	REVIEWED	DATE	APPROVED	DATE	NO.	DATE	BY	REVISIONS	DATE	BY
ARCHITECTURAL						1			4		
ENGINEERING						2			5		
LANDSCAPE						3			6		

N L A K E M I C H I G A N

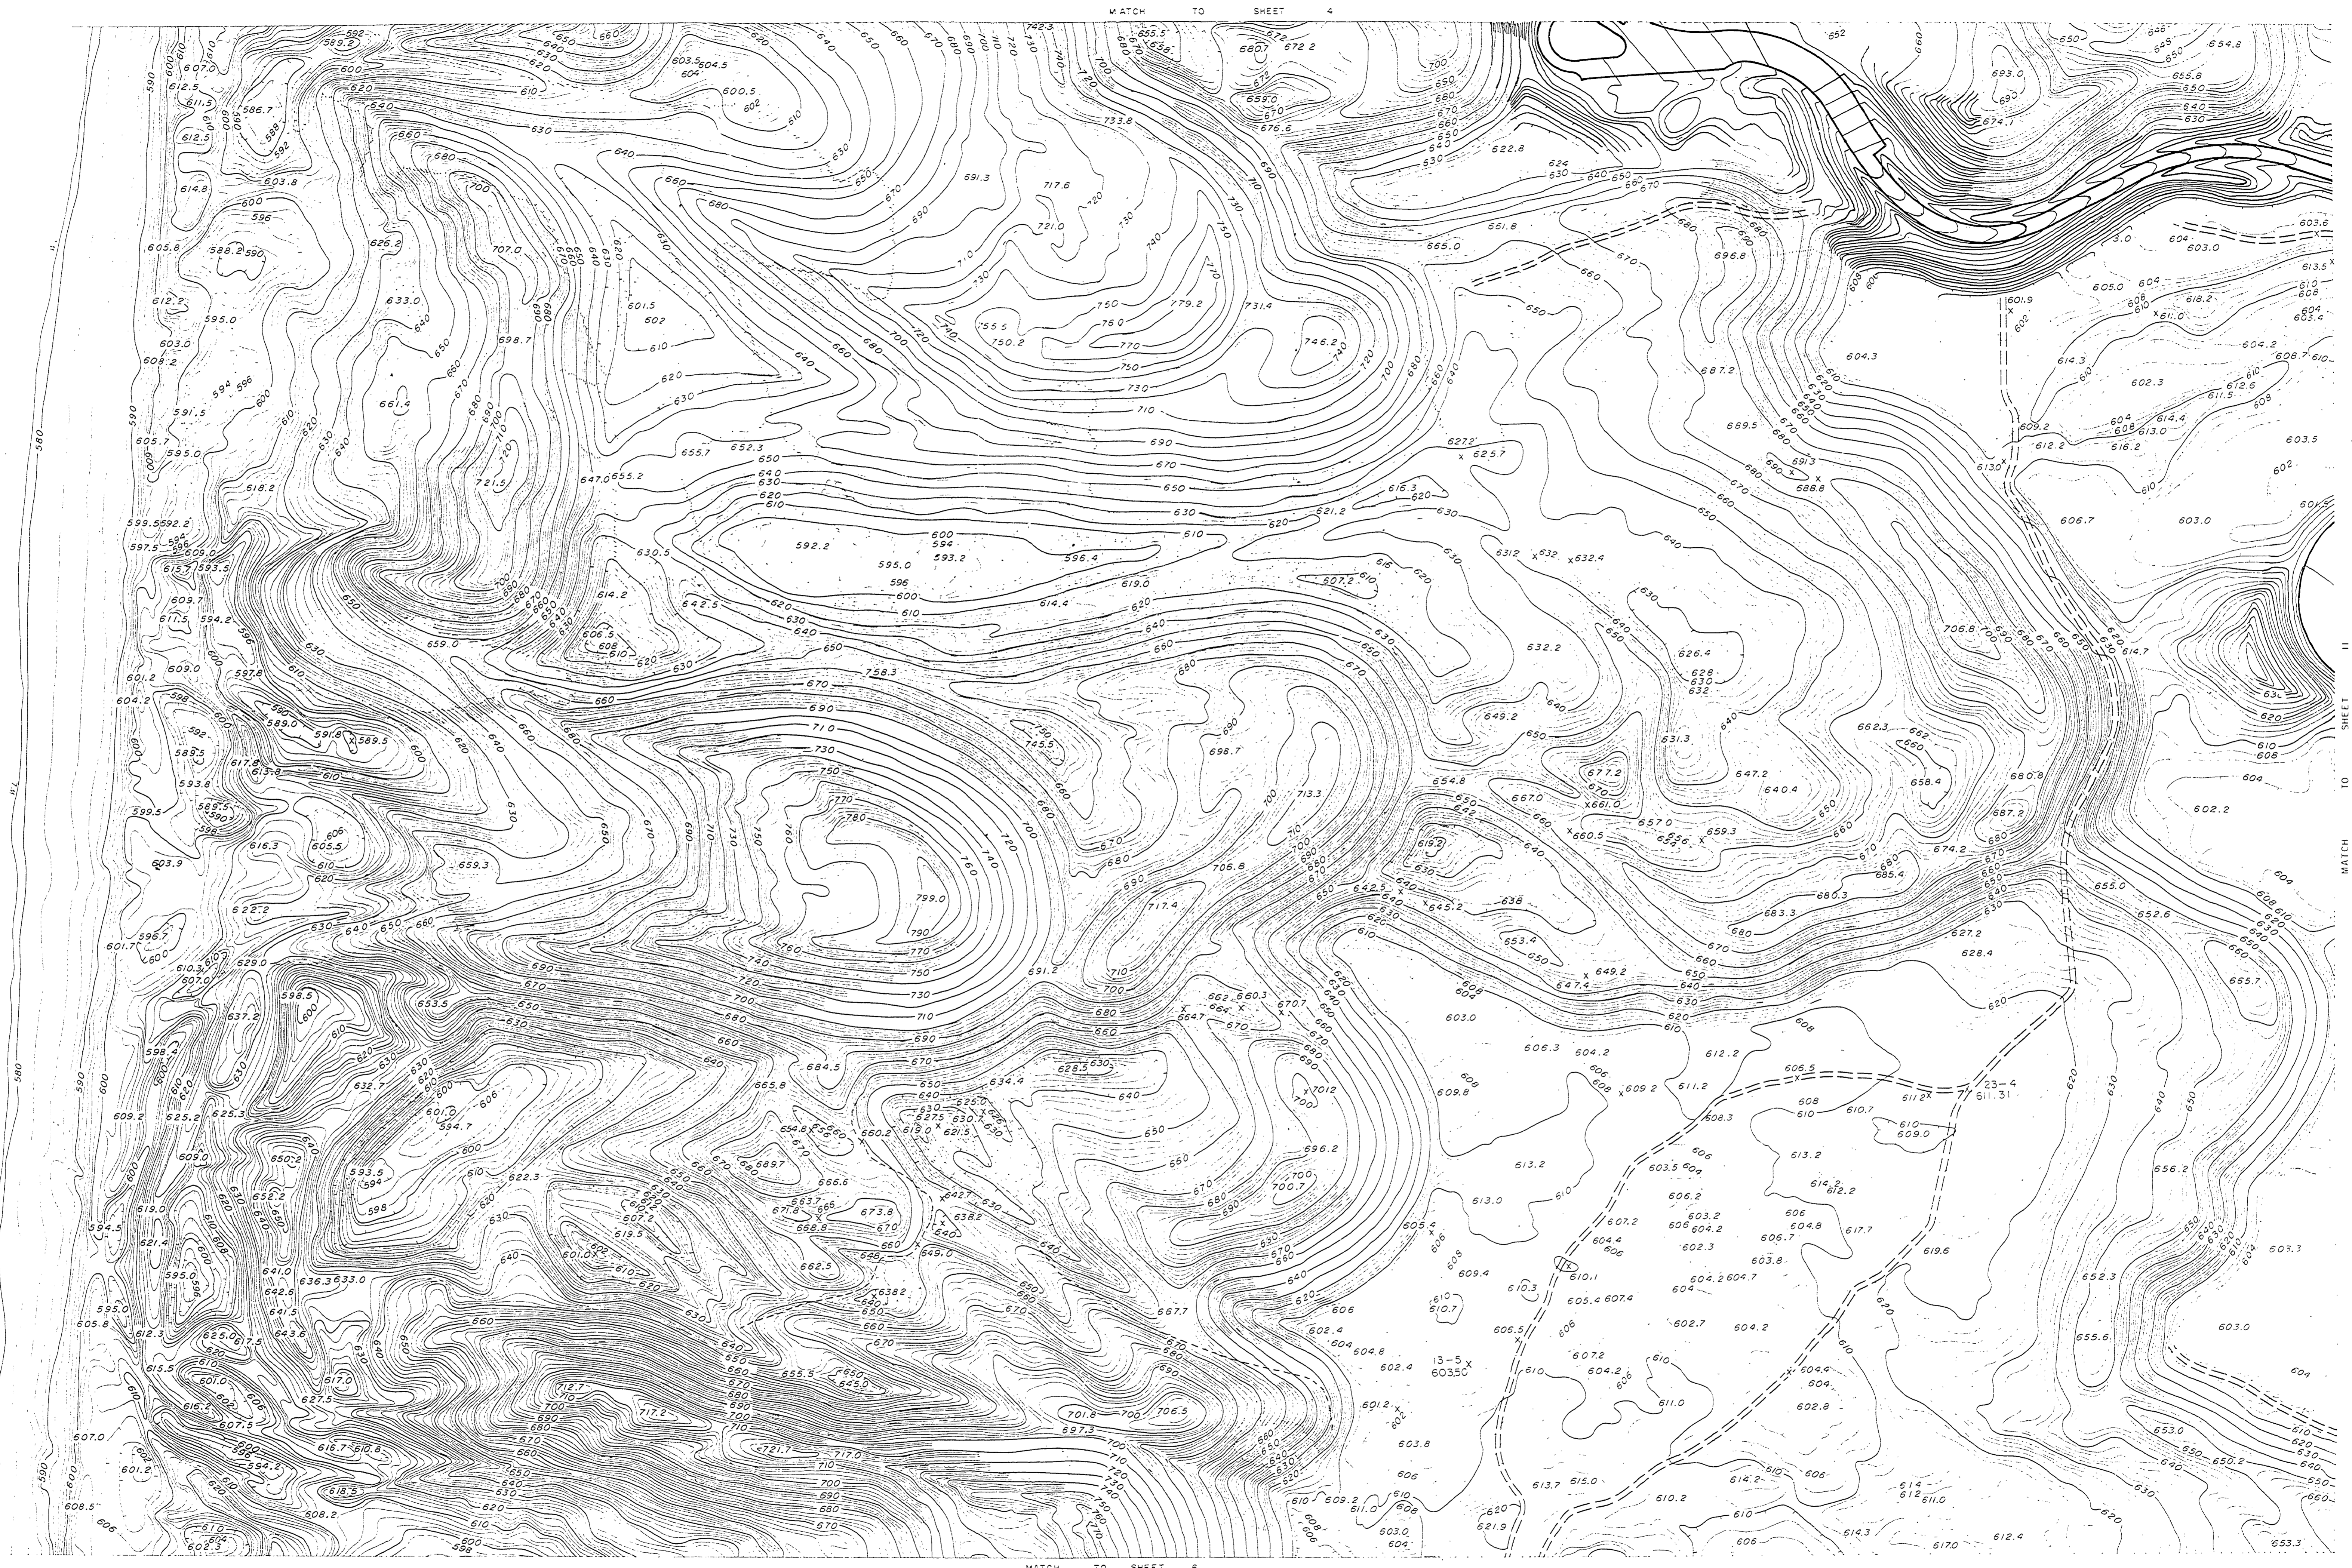

PRIMARY ROADS	—————
SECONDARY ROADS	—————
RAILROADS	—————

BUILDINGS	□
PERENNIAL STREAMS	~~~~~
INTERMITTENT STREAMS	- - - - -

BRIDGES	— — —
CULVERT	— —
TRAVERSE STATION	46.2 ○

VERTICAL CONTROL - MSL	⊕
TREES	⊗
TREES	⊙

ABRAMS AERIAL SURVEY CORPORATION
LANSING, MICHIGAN

MICHIGAN
DEPARTMENT OF CONSERVATION
PARKS AND RECREATION DIVISION

HOFFMASTER STATE PARK
SCALE 1"=100'
AS-BUILT DWG.
DATE OF PHOTOGRAPHY APRIL 1962
DATE OF MAPPING JANUARY 1963

SHEET NO. 5 OF 12
PLAN NO. L-95