


WATER SUPPLY PLAN
1" = 5'

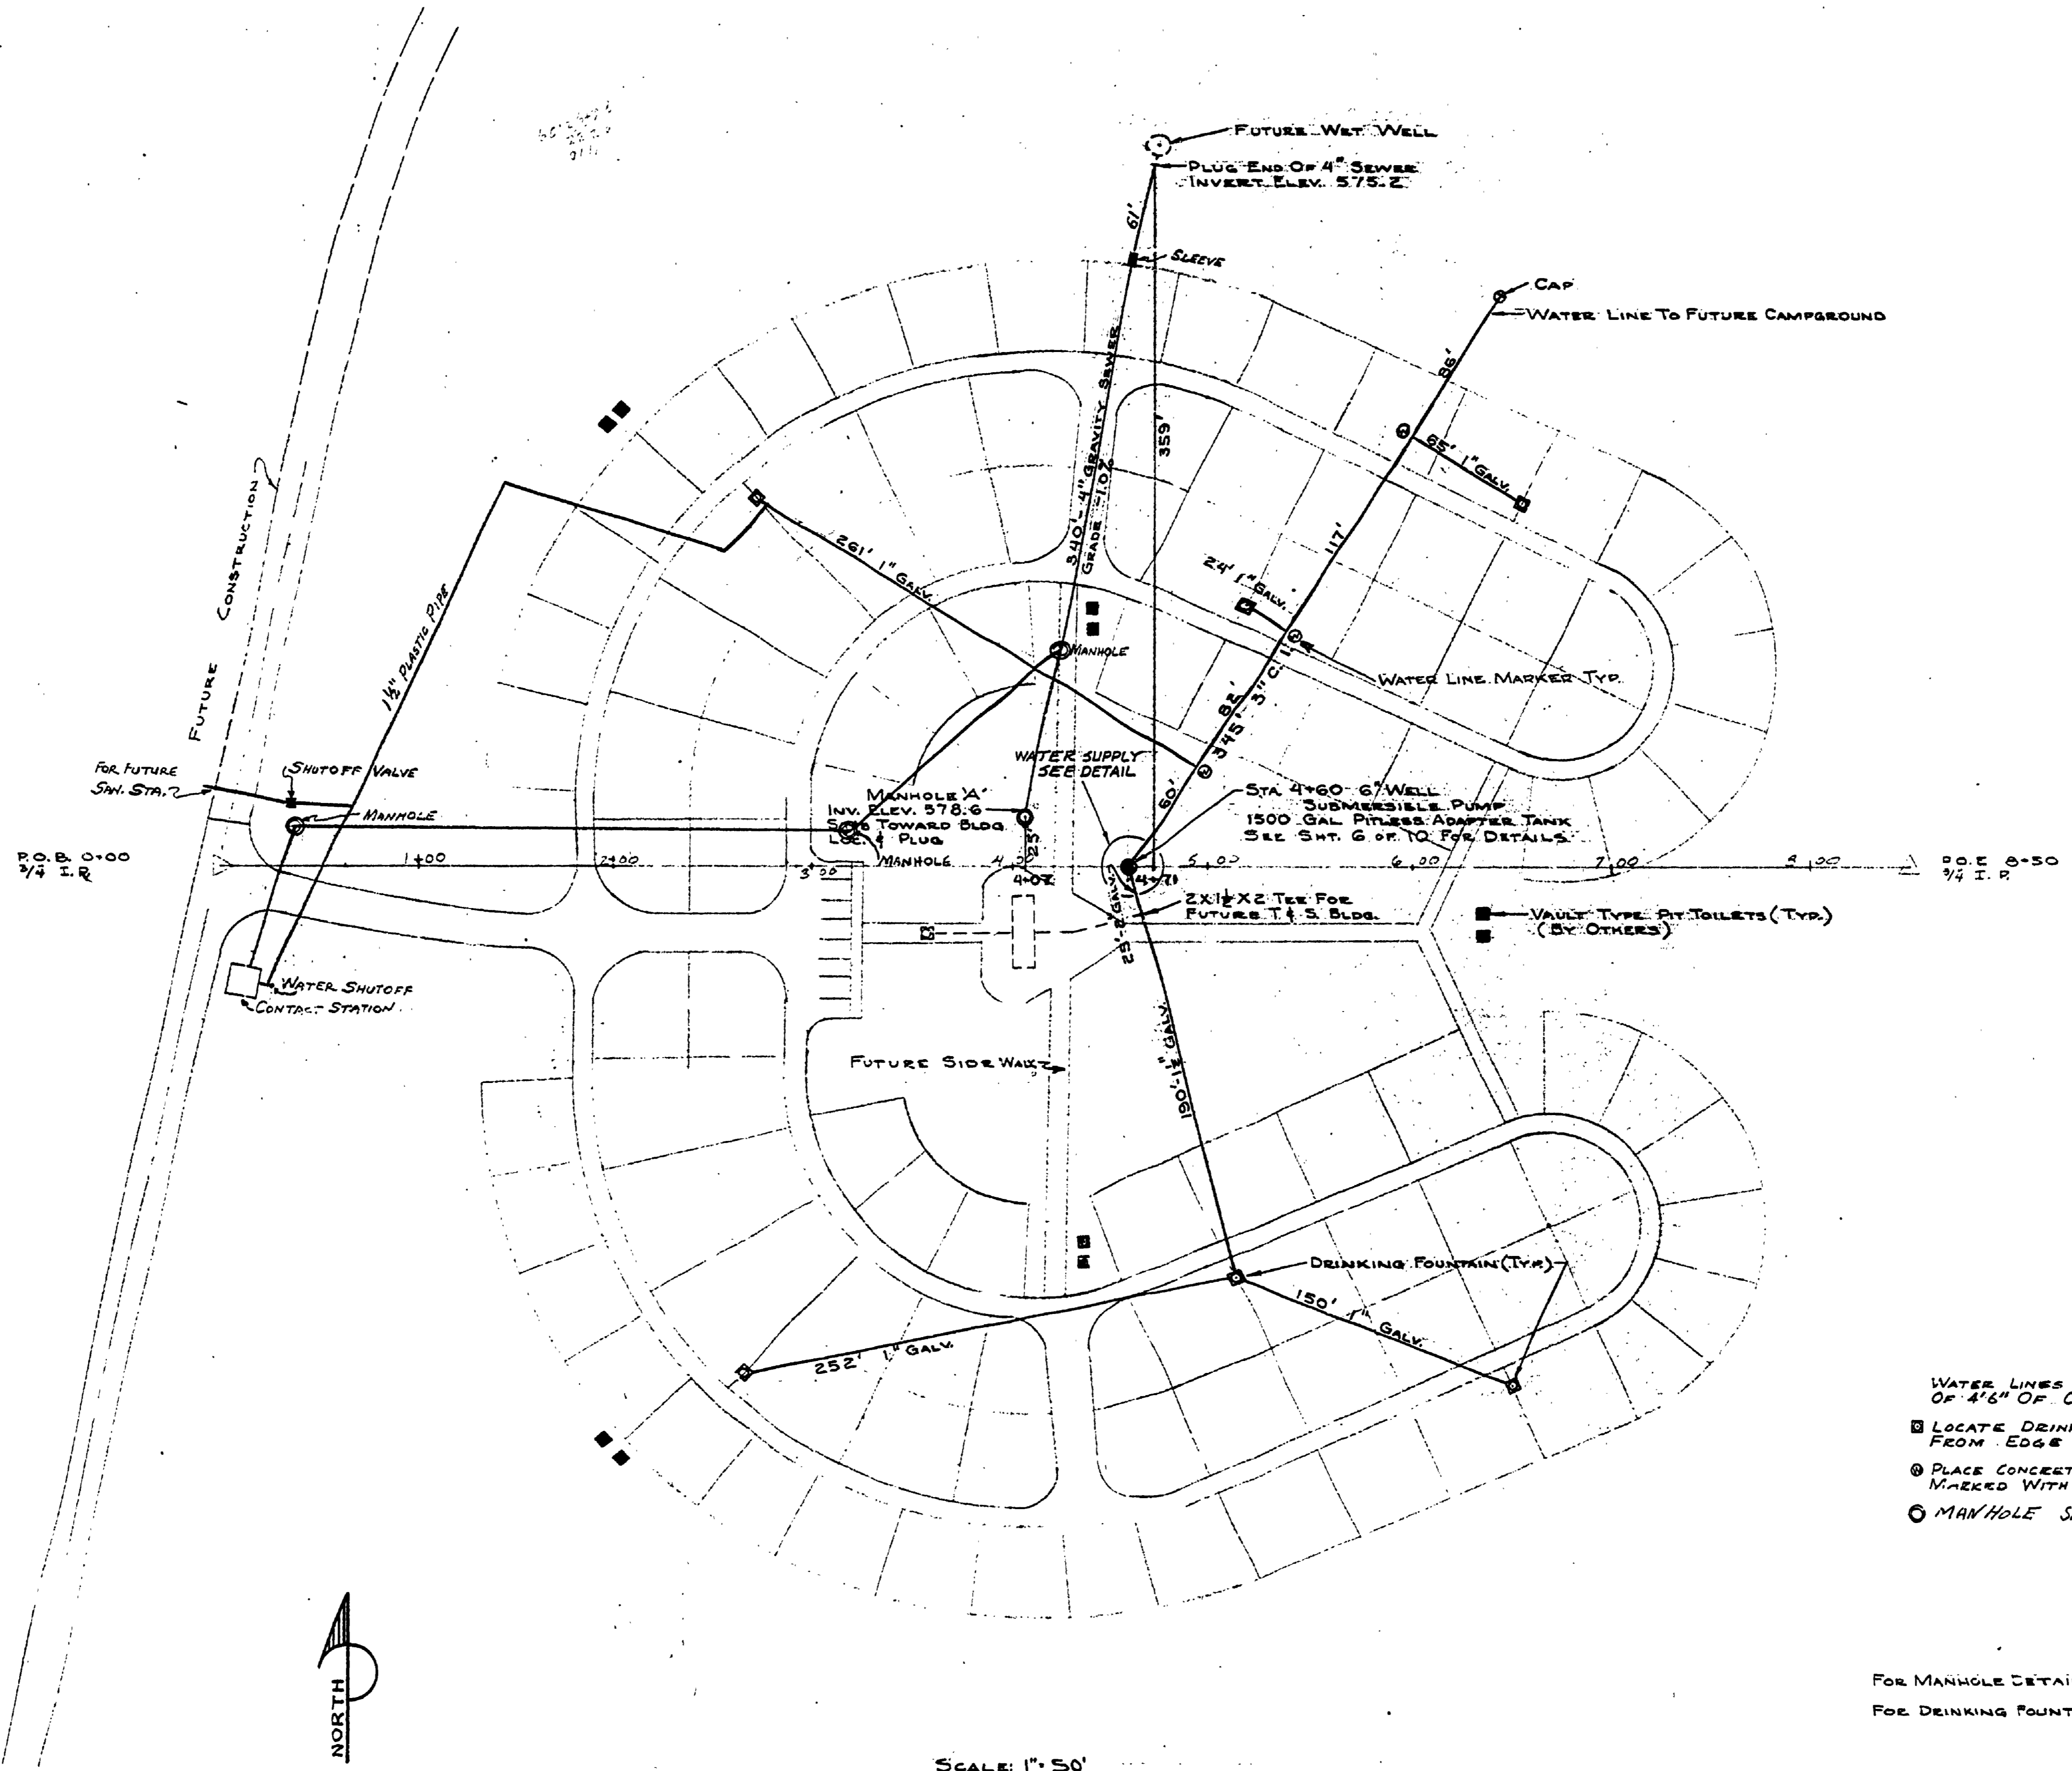

- NOTES**
- WATER LINES TO BE INSTALLED WITH A MINIMUM OF 4\"/>

FOR MANHOLE DETAILS SEE STD. PLAN SE-158 SHEET 7 OF 10
FOR DRINKING FOUNTAIN DETAILS SEE STD. PLAN SE-149 SHEET 6 OF 10

RE-MICROFILM

SURVEYED BY	DRAWN BY J. YPMA	12-67	NO.	DATE	BY	REVISIONS	NO.	DATE	BY	REVISIONS	MICHIGAN DEPARTMENT OF CONSERVATION	WATER & SEWER SYSTEMS	SHEET NO. 5 OF 10	MUSKEGON STATE PARK CAMPGROUND DEVELOPMENT
DESIGNED BY H.R. MERRILL	CHECKED BY		1.	3-78	D.B.	As Built	3.						FOR PROJECT NO. PA108-5124-300-031	SHEET 5 OF 10 PLAN NO. E-113
DATE		DATE	2.				4.							