


LOCATION MAP

MUSKEGON STATE PARK DAY USE AREA CONSTRUCTION PLANS FOR BEACH HOUSE SEWAGE REVISIONS PROJECT NO. 24-1352

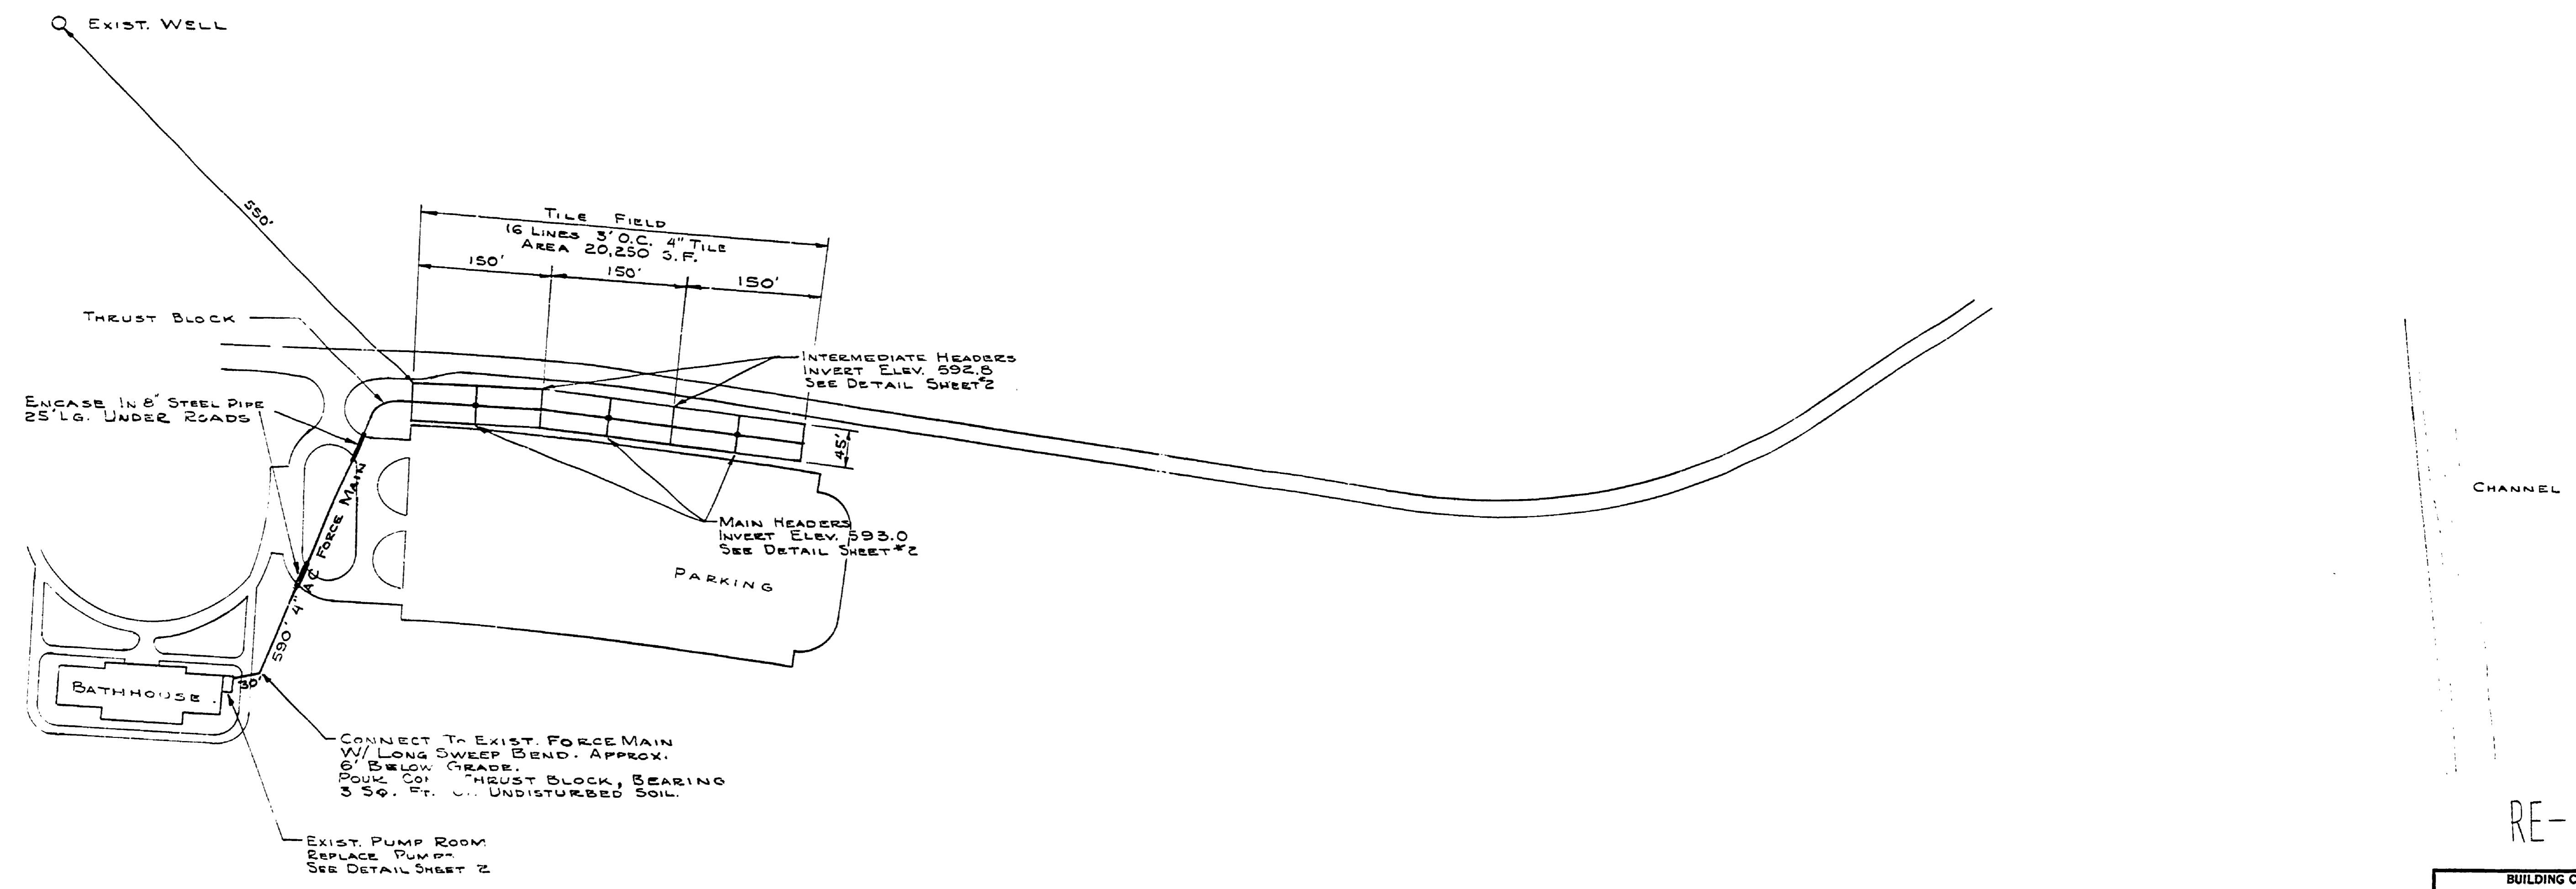

RE-MICROFILM

BUILDING COMMITTEE APPROVAL	
BY: _____	DATE: _____
RECOMMENDED FOR APPROVAL: <i>Paul P. Bobbitt</i> 7-27-72	
ENGINEERING OR ARCHITECTURAL SUPERVISOR DATE	
RECOMMENDED FOR APPROVAL: <i>Ed Paul</i> 7-27-72	
PROGRAM AND PLAN COORDINATOR DATE	
DIVISION/REGION APPROVAL	
BY: <i>[Signature]</i> 8-8-72	DATE: _____
DIVISION CHIEF/REGIONAL MANAGER ENGINEERING DIVISION	
APPROVED: <i>H.G. [Signature]</i> 8-9-72	DATE: _____
CHIEF ENGINEER	



SURVEYED BY	DRAWN BY J. YEMA	7-72	NO. DATE BY	REVISIONS	NO. DATE BY	REVISIONS	MICHIGAN DEPARTMENT OF NATURAL RESOURCES	PLAN SHEET SEWAGE REVISION	MUSKEGON STATE PARK AREA OR PARK	PROJECT NO. 24-1352
DESIGNED BY R.H. McREILL	7-72	CHECKED BY	1. 11-4-72 J.Y.	TILE FIELD RELOCATED & REVISED	3.			SHEET TITLE	BEACHHOUSE, SEWAGE REVISIONS (DAY USE AREA)	SHEET 1 OF 2
	DATE	DATE	2. 3-78 D.H.	AS NOTED	4.					PLAN NO. E-116