


SCALE 1"=100'

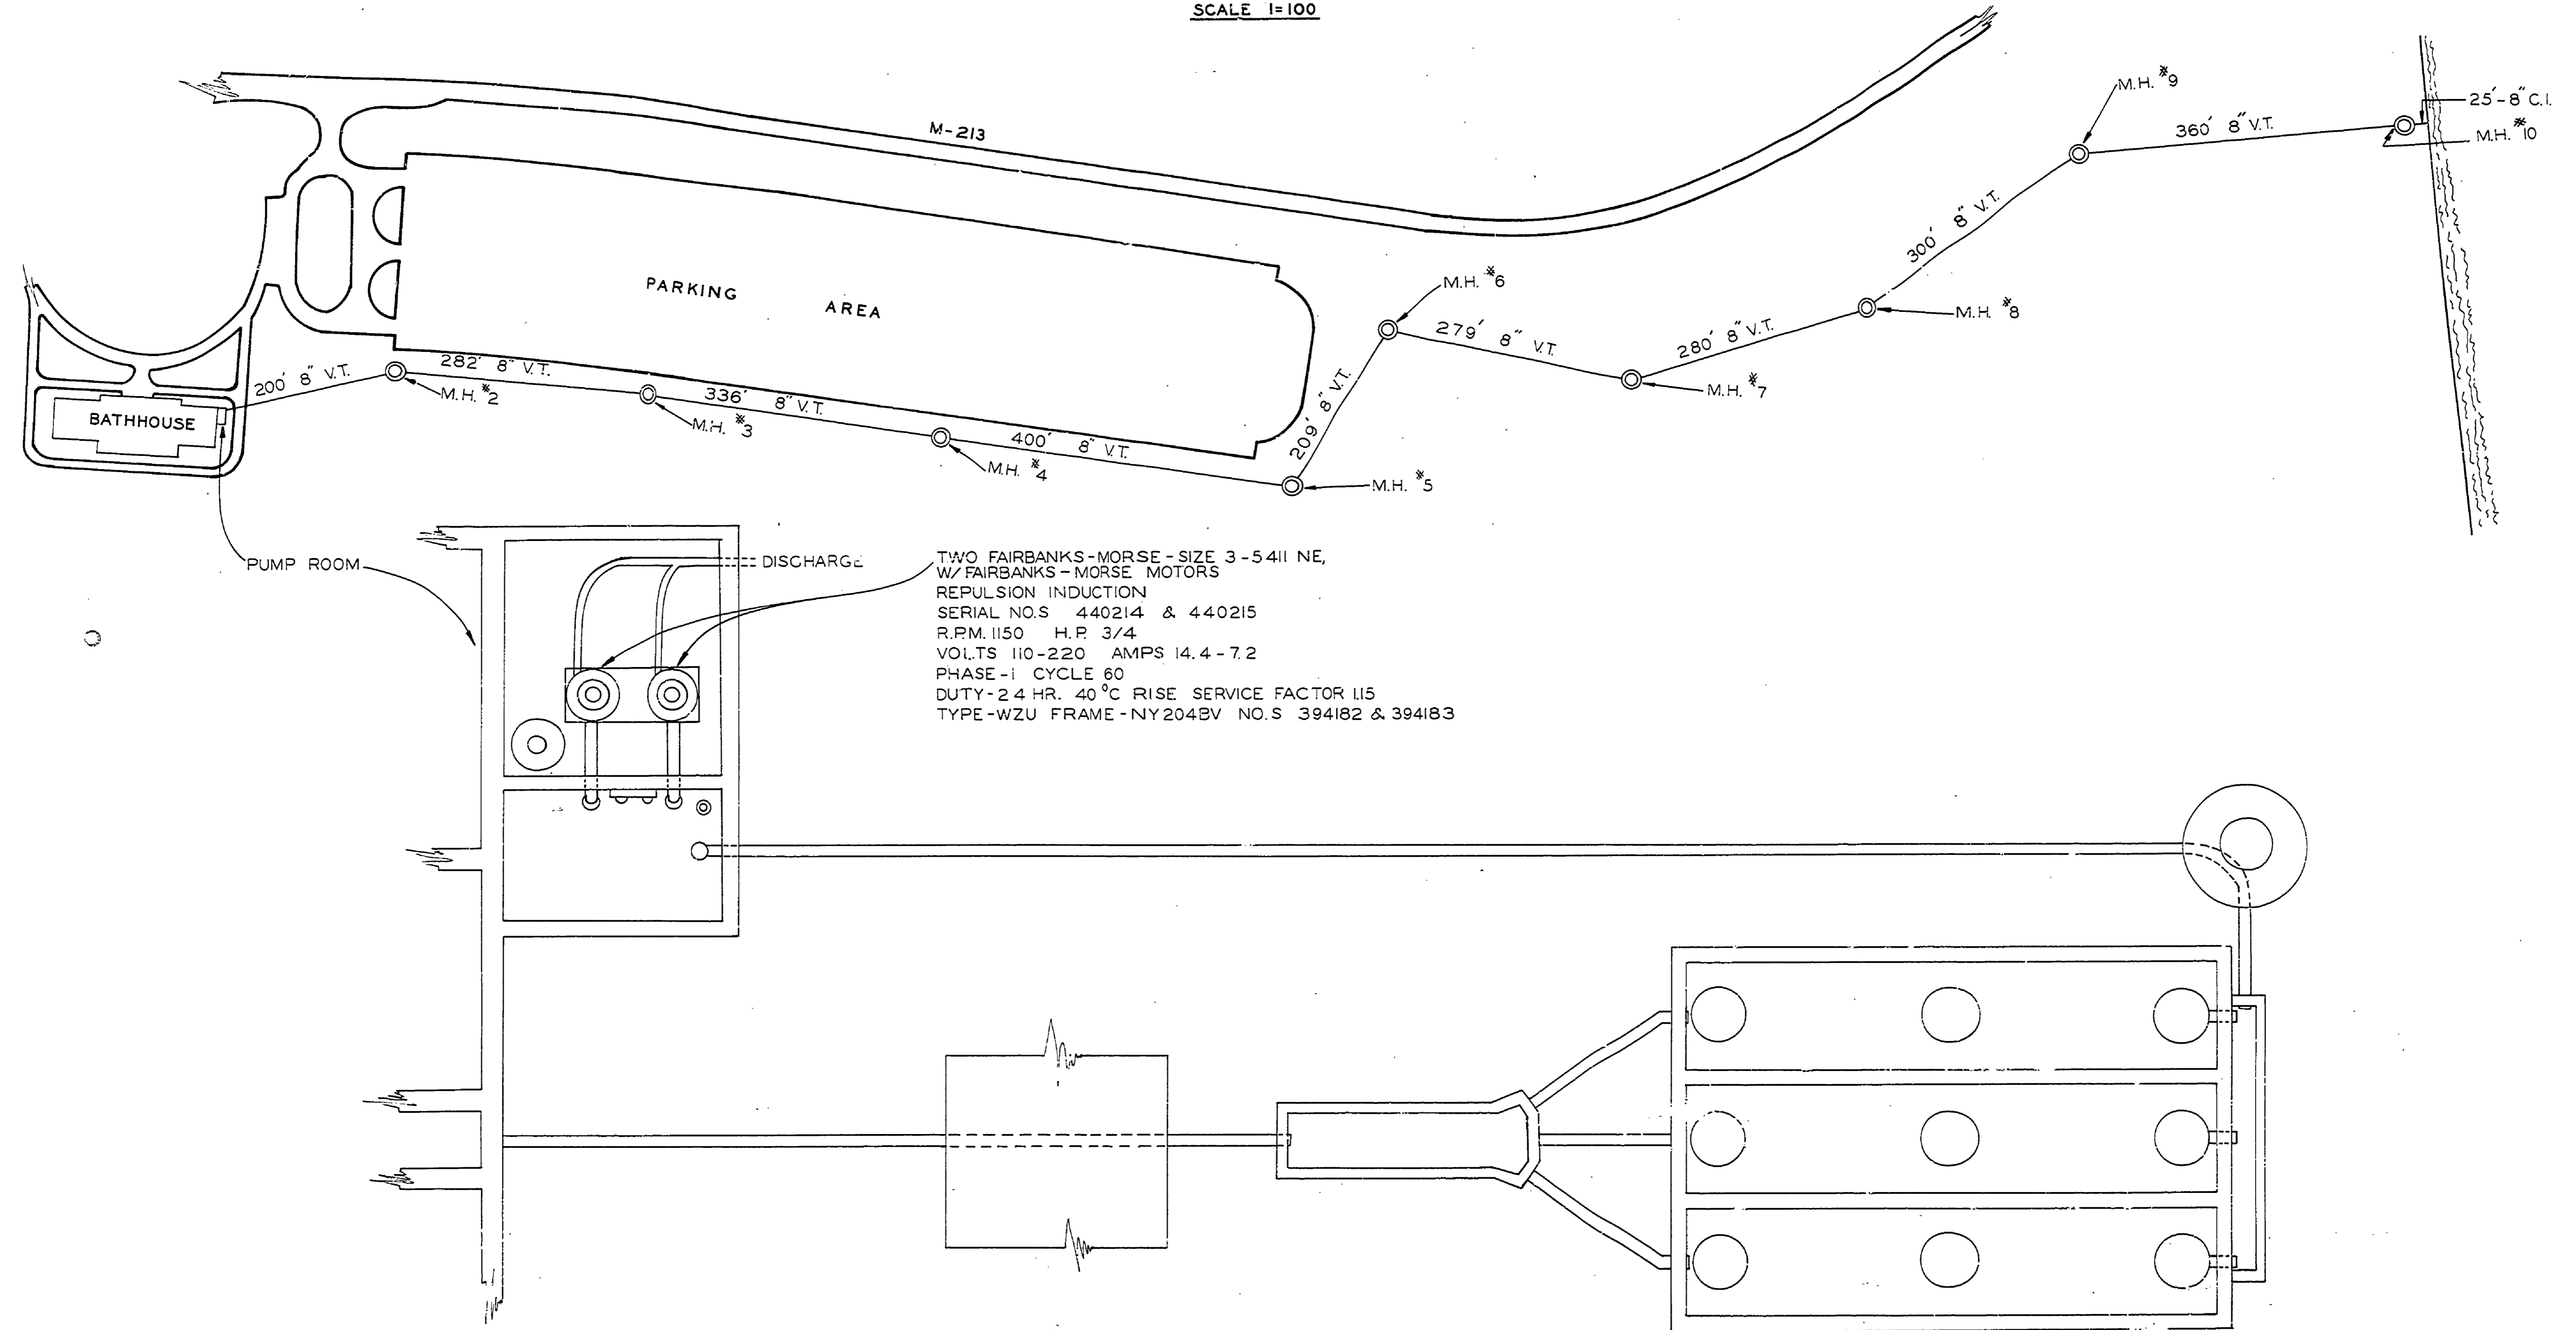

SURVEYED BY	DRAWN BY	NO.	DATE	BY	REVISIONS	NO.	DATE	BY	REVISIONS	MICHIGAN DEPARTMENT OF CONSERVATION	MUSKEGON STATE PARK SEWAGE SYSTEM	SHEET NO. ____ OF ____ FOR PROJECT NO. _____	SHEET 5 OF 20 PLAN NO. U-1
DESIGNED BY	CHECKED BY	1.	6-14	Russell		3.							
		2.				4.							

Rope M