


MUSKEGON STATE PARK
CAMPGROUND
WATER SYSTEM

SURVEYED BY	DRAWN BY D.E. BROWNE	7-66	NO.	DATE	BY	REVISIONS	NO.	DATE	BY	REVISIONS
DESIGNED BY	CHECKED BY		1.				3.			
DATE			2.				4.			

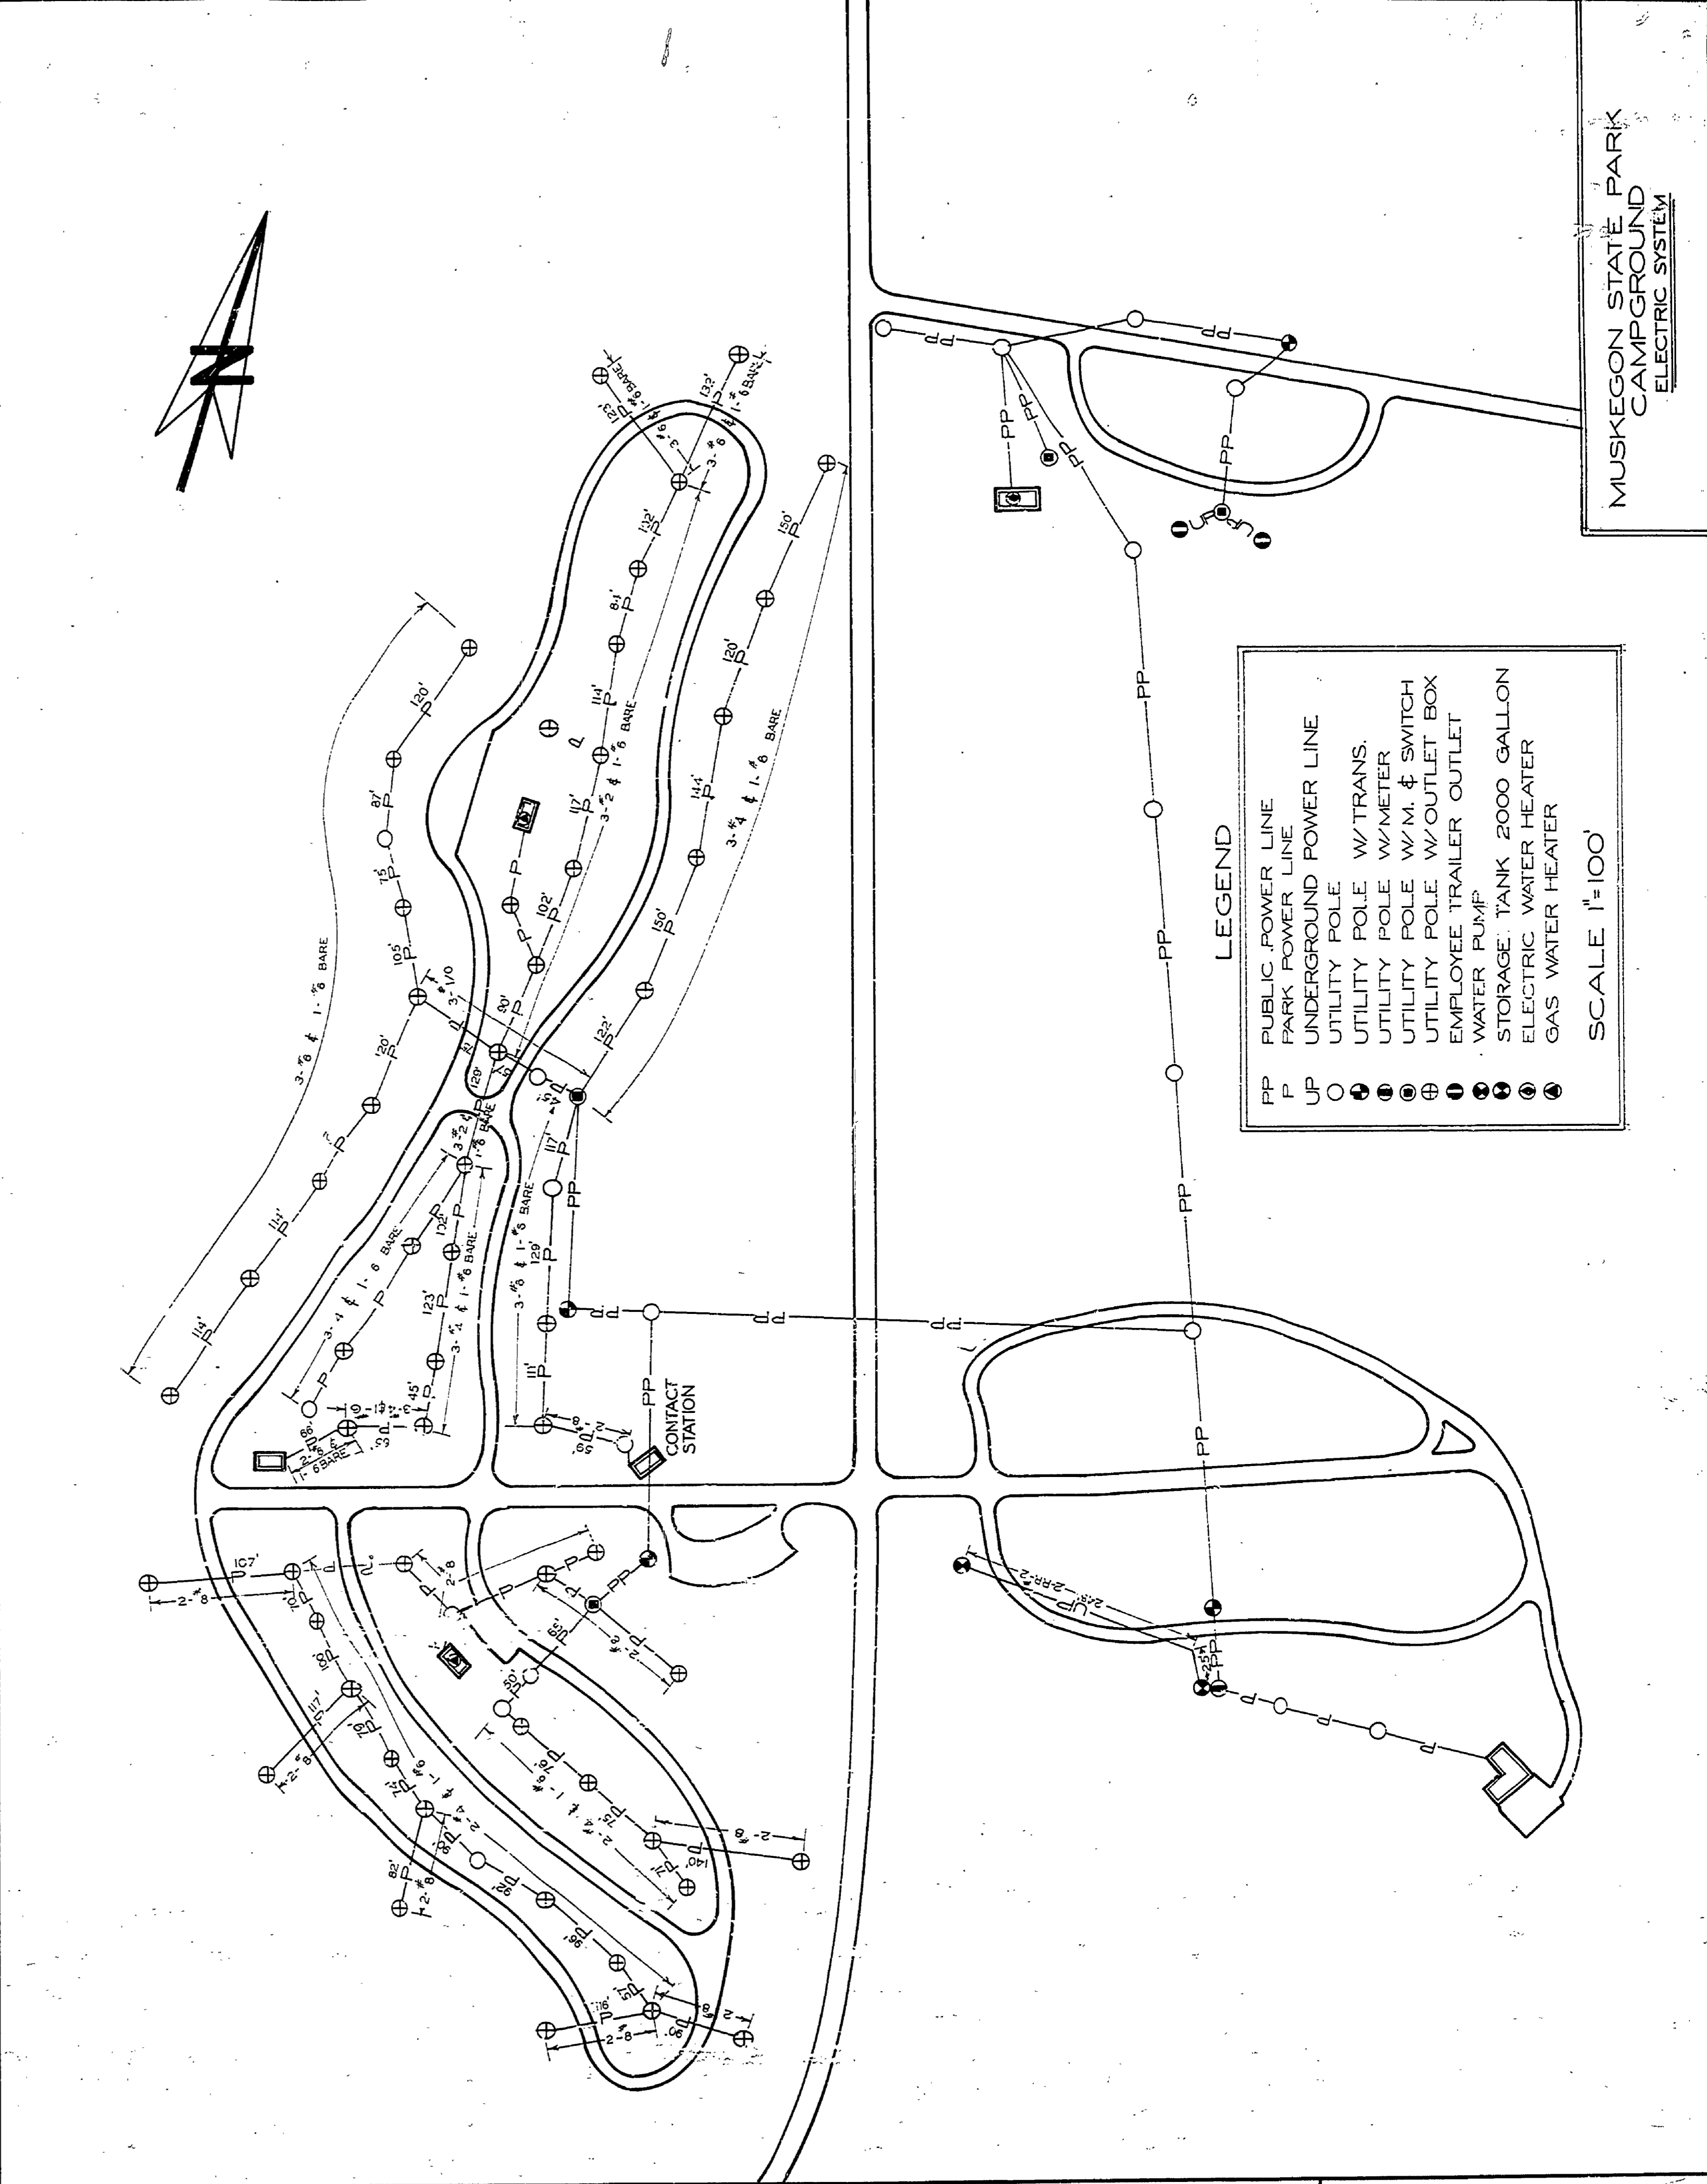

MUSKEGON STATE PARK
CAMPGROUND
ELECTRIC SYSTEM

MICHIGAN DEPARTMENT OF CONSERVATION	MUSKEGON STATE PARK UTILITIES	SHEET NO. _____ OF _____	FOR PROJECT NO. _____	SHEET 8 OF 10	PLAN NO. 0-1
--	----------------------------------	--------------------------	-----------------------	---------------	--------------