


MICH. DEPT. OF CONSERVATION MUSKEGON STATE PARK	MICH. DEPT. OF CONSERVATION MUSKEGON STATE PARK	MICH. DEPT. OF CONSERVATION MUSKEGON STATE PARK	MICH. DEPT. OF CONSERVATION MUSKEGON STATE PARK
SCALE: 1"=30'	SCALE: 1"=40'	SCALE: 1"=10'	SCALE: 1"=100'
DRAWN BY: D.E.BROWNE	DRAWN BY: D.E.BROWNE	DRAWN BY: D.E.BROWNE	DRAWN BY: D.E.BROWNE
SEWER SYSTEM	SEWER SYSTEM	SEWER SYSTEM	SEWER SYSTEM

SURVEYED BY	DRAWN BY: D.E.BROWNE	8-66	NO.	DATE	BY	REVISIONS	NO.	DATE	BY	REVISIONS
DESIGNED BY	CHECKED BY		1.				3.			
			2.				4.			

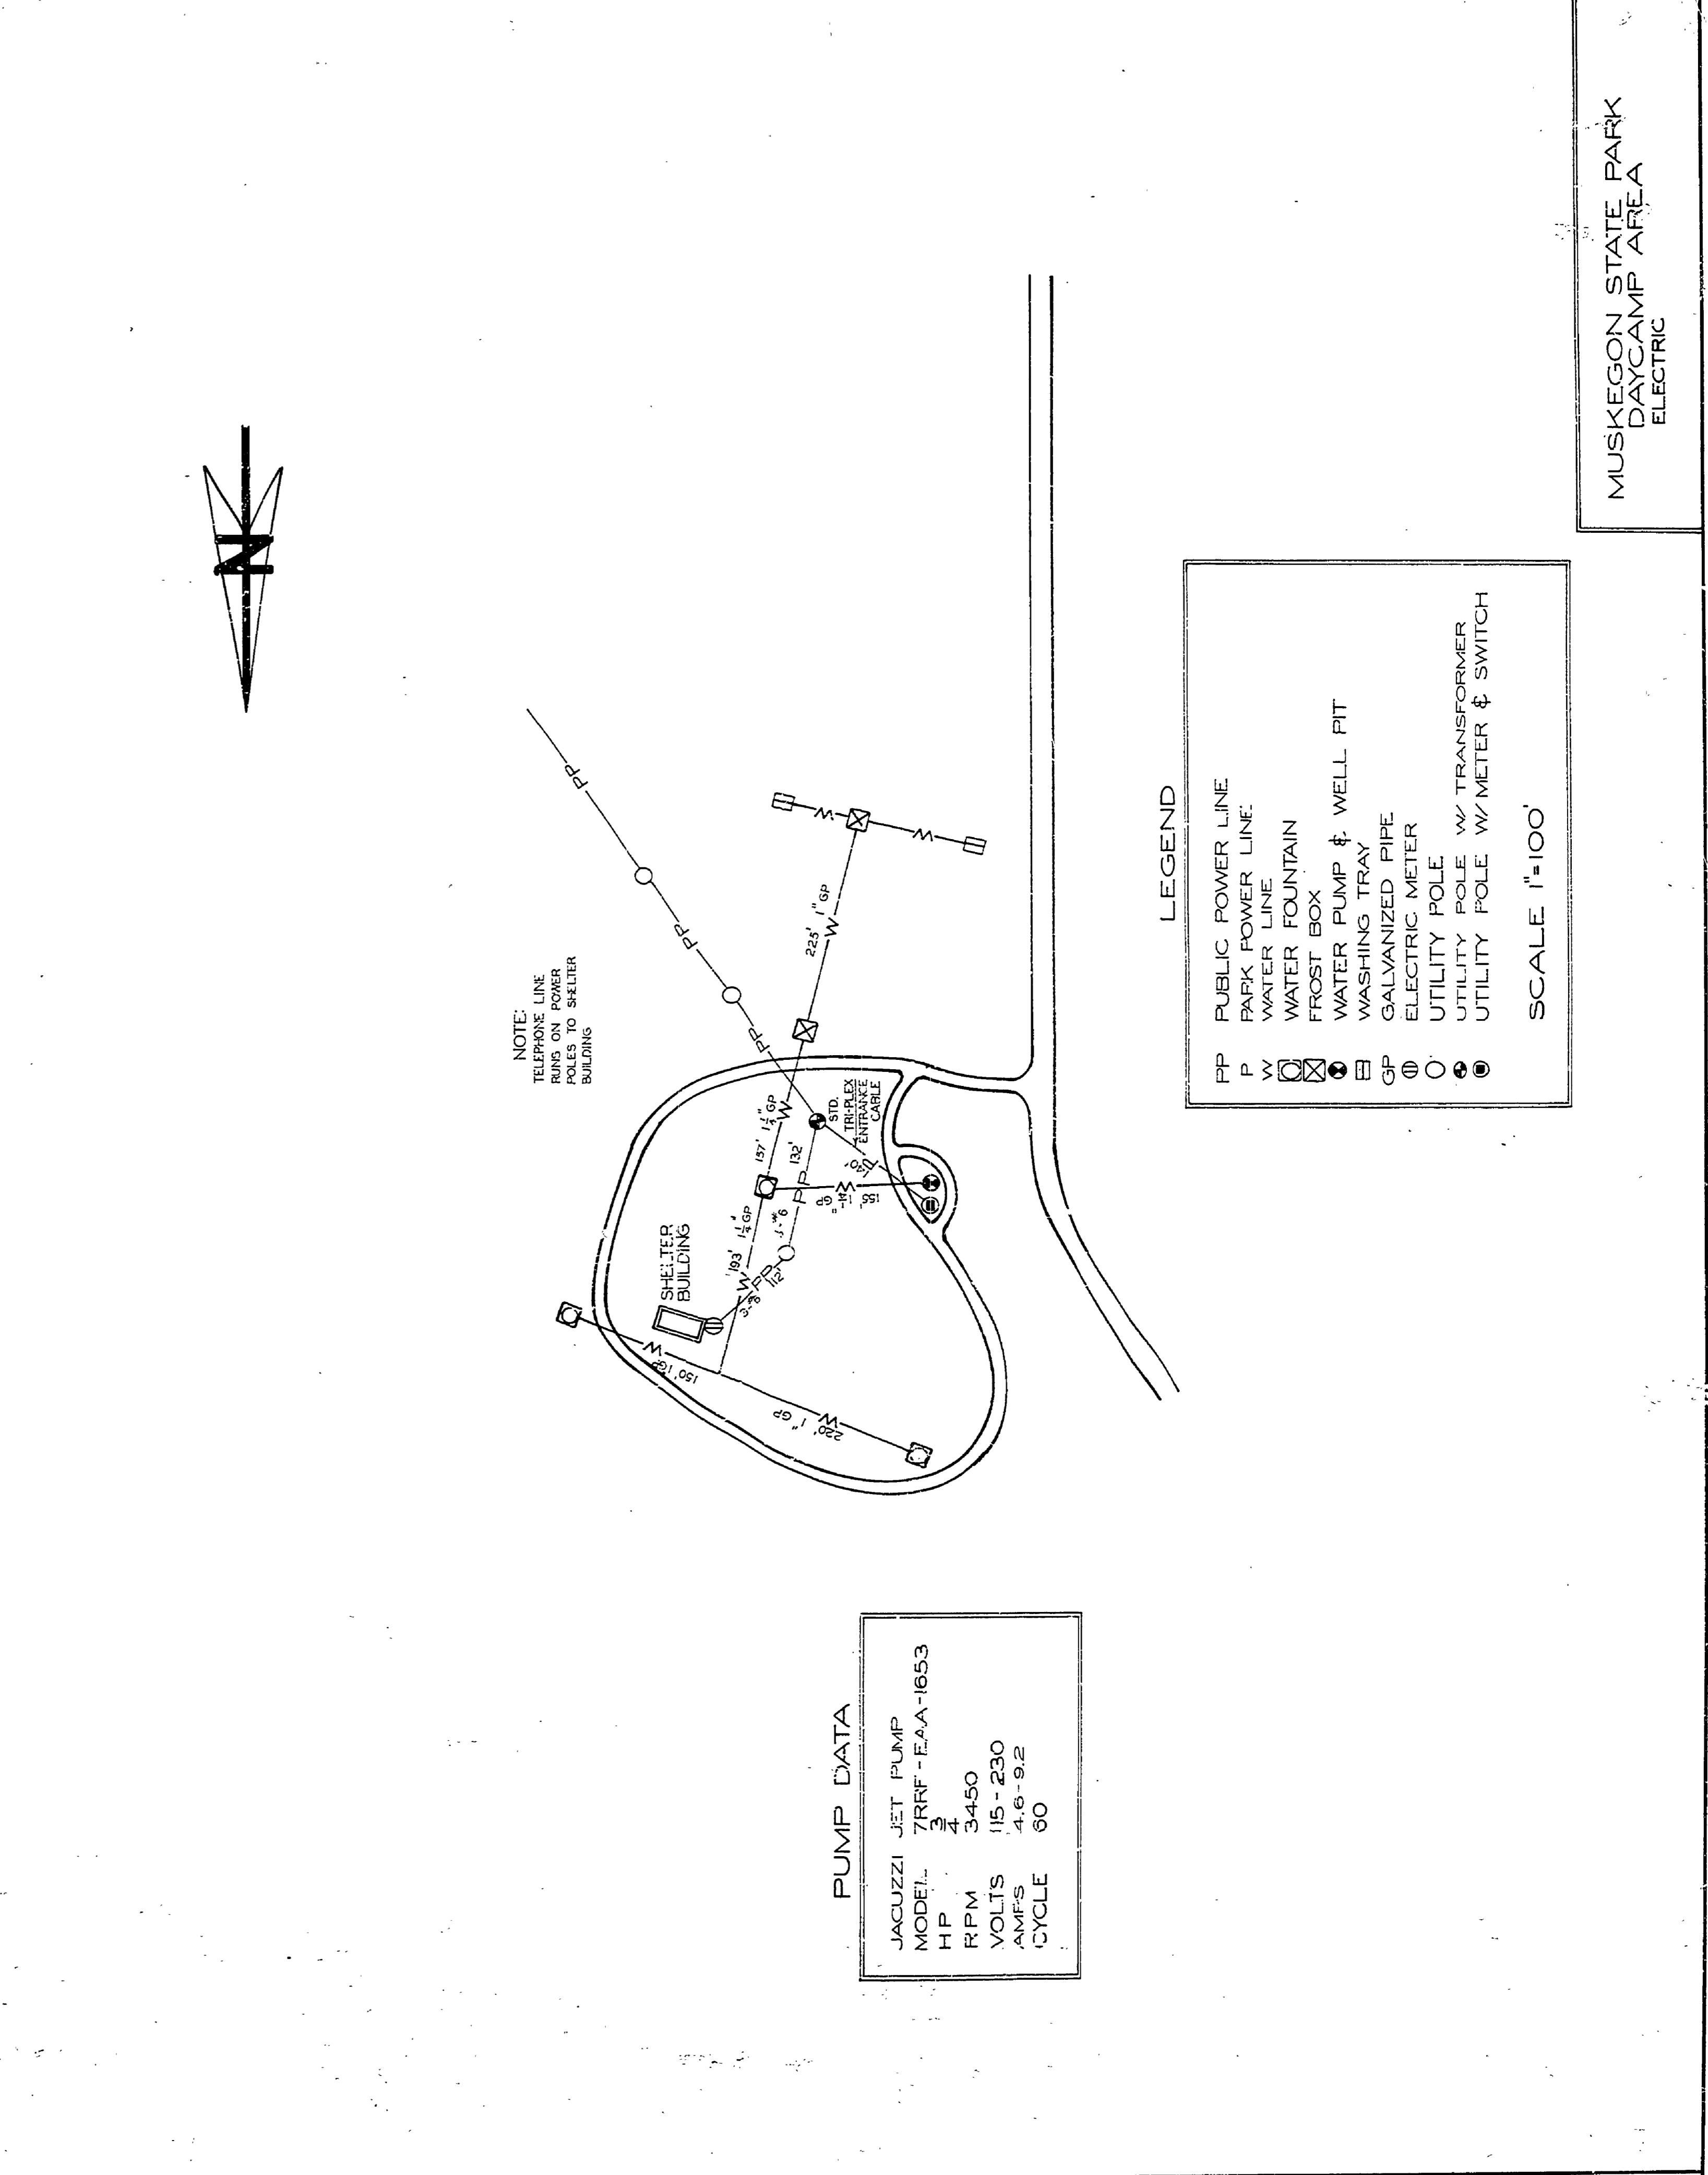

PUMP DATA

JACUZZI	JET PUMP
MODEL:	7RRF-EAA-1653
HP	3
RPM	3450
VOLTS	115-230
AMPS	4.6-9.2
CYCLE	60