


MUSKEGON STATE PARK
SNUG HARBOR PICNIC AREA
WATER & SEWAGE SYSTEM

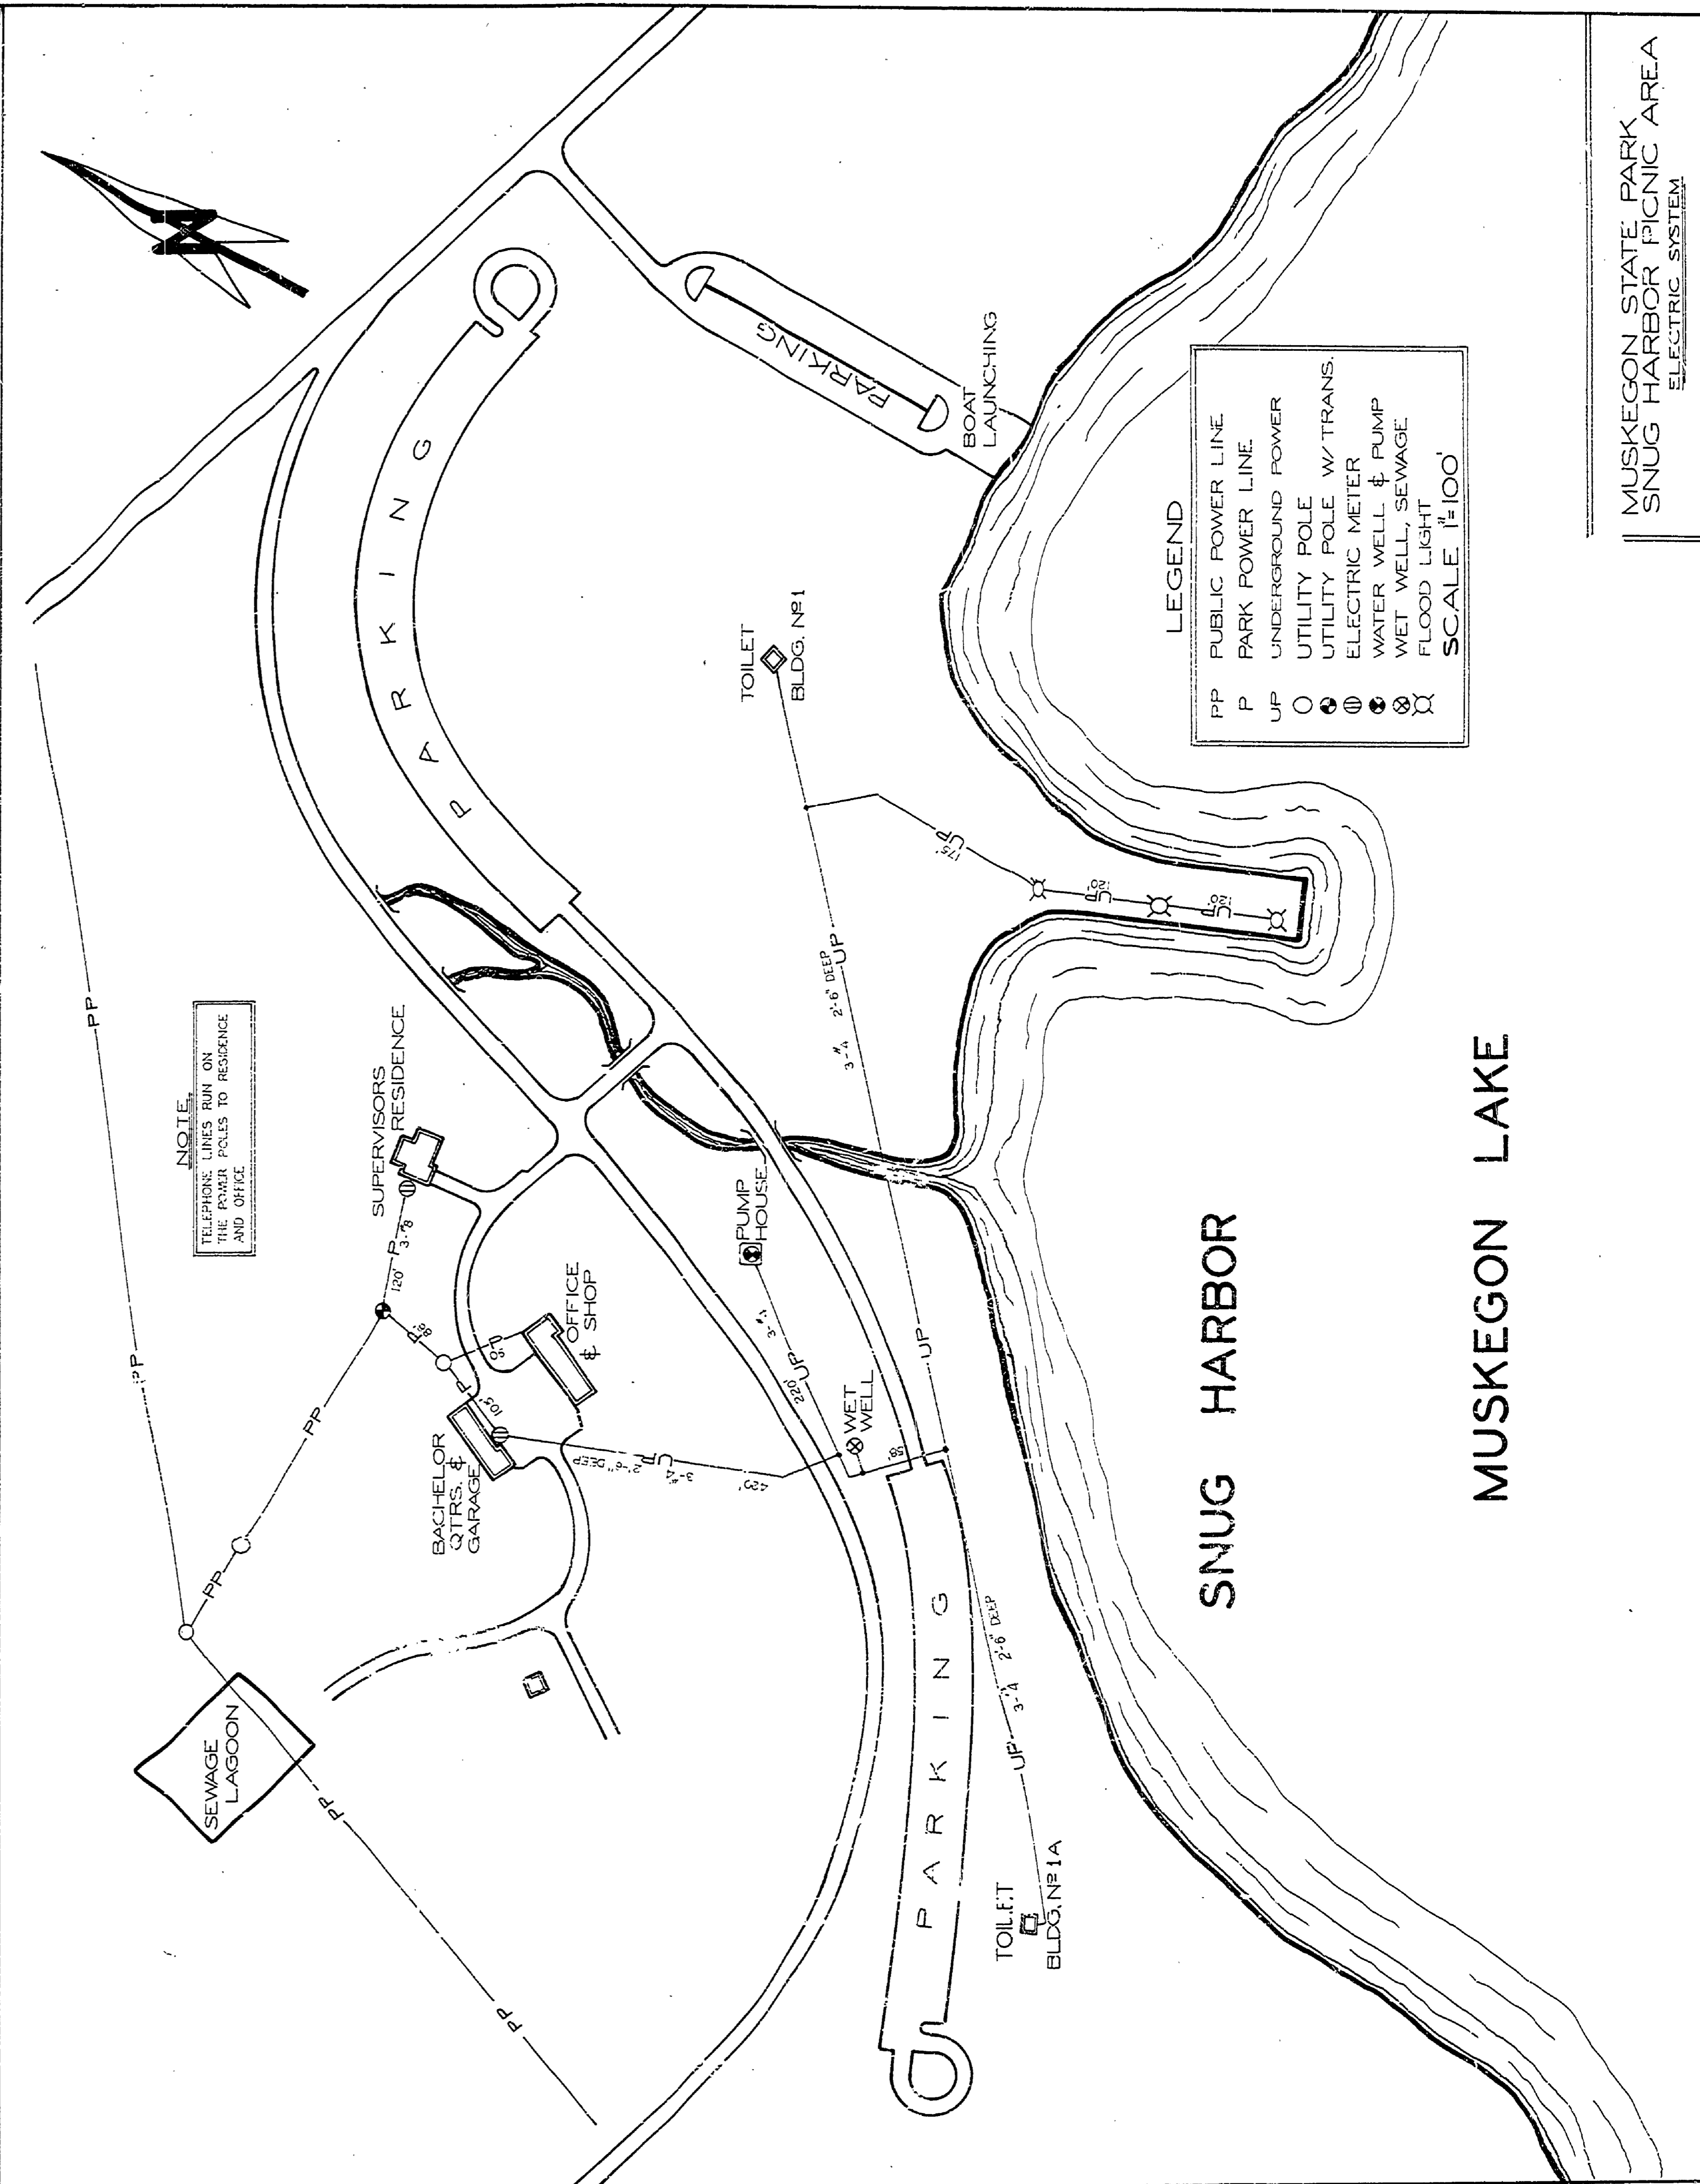

MUSKEGON STATE PARK
SNUG HARBOR PICNIC AREA
ELECTRIC SYSTEM

SURVEYED BY	DRAWN BY DE. BROWNE	7-66	NO.	DATE	BY	REVISIONS	NO.	DATE	BY	REVISIONS
DESIGNED BY	CHECKED BY		1.				3.			
DATE			2.				4.			