


MATCH TO SHEET 3 OF 4

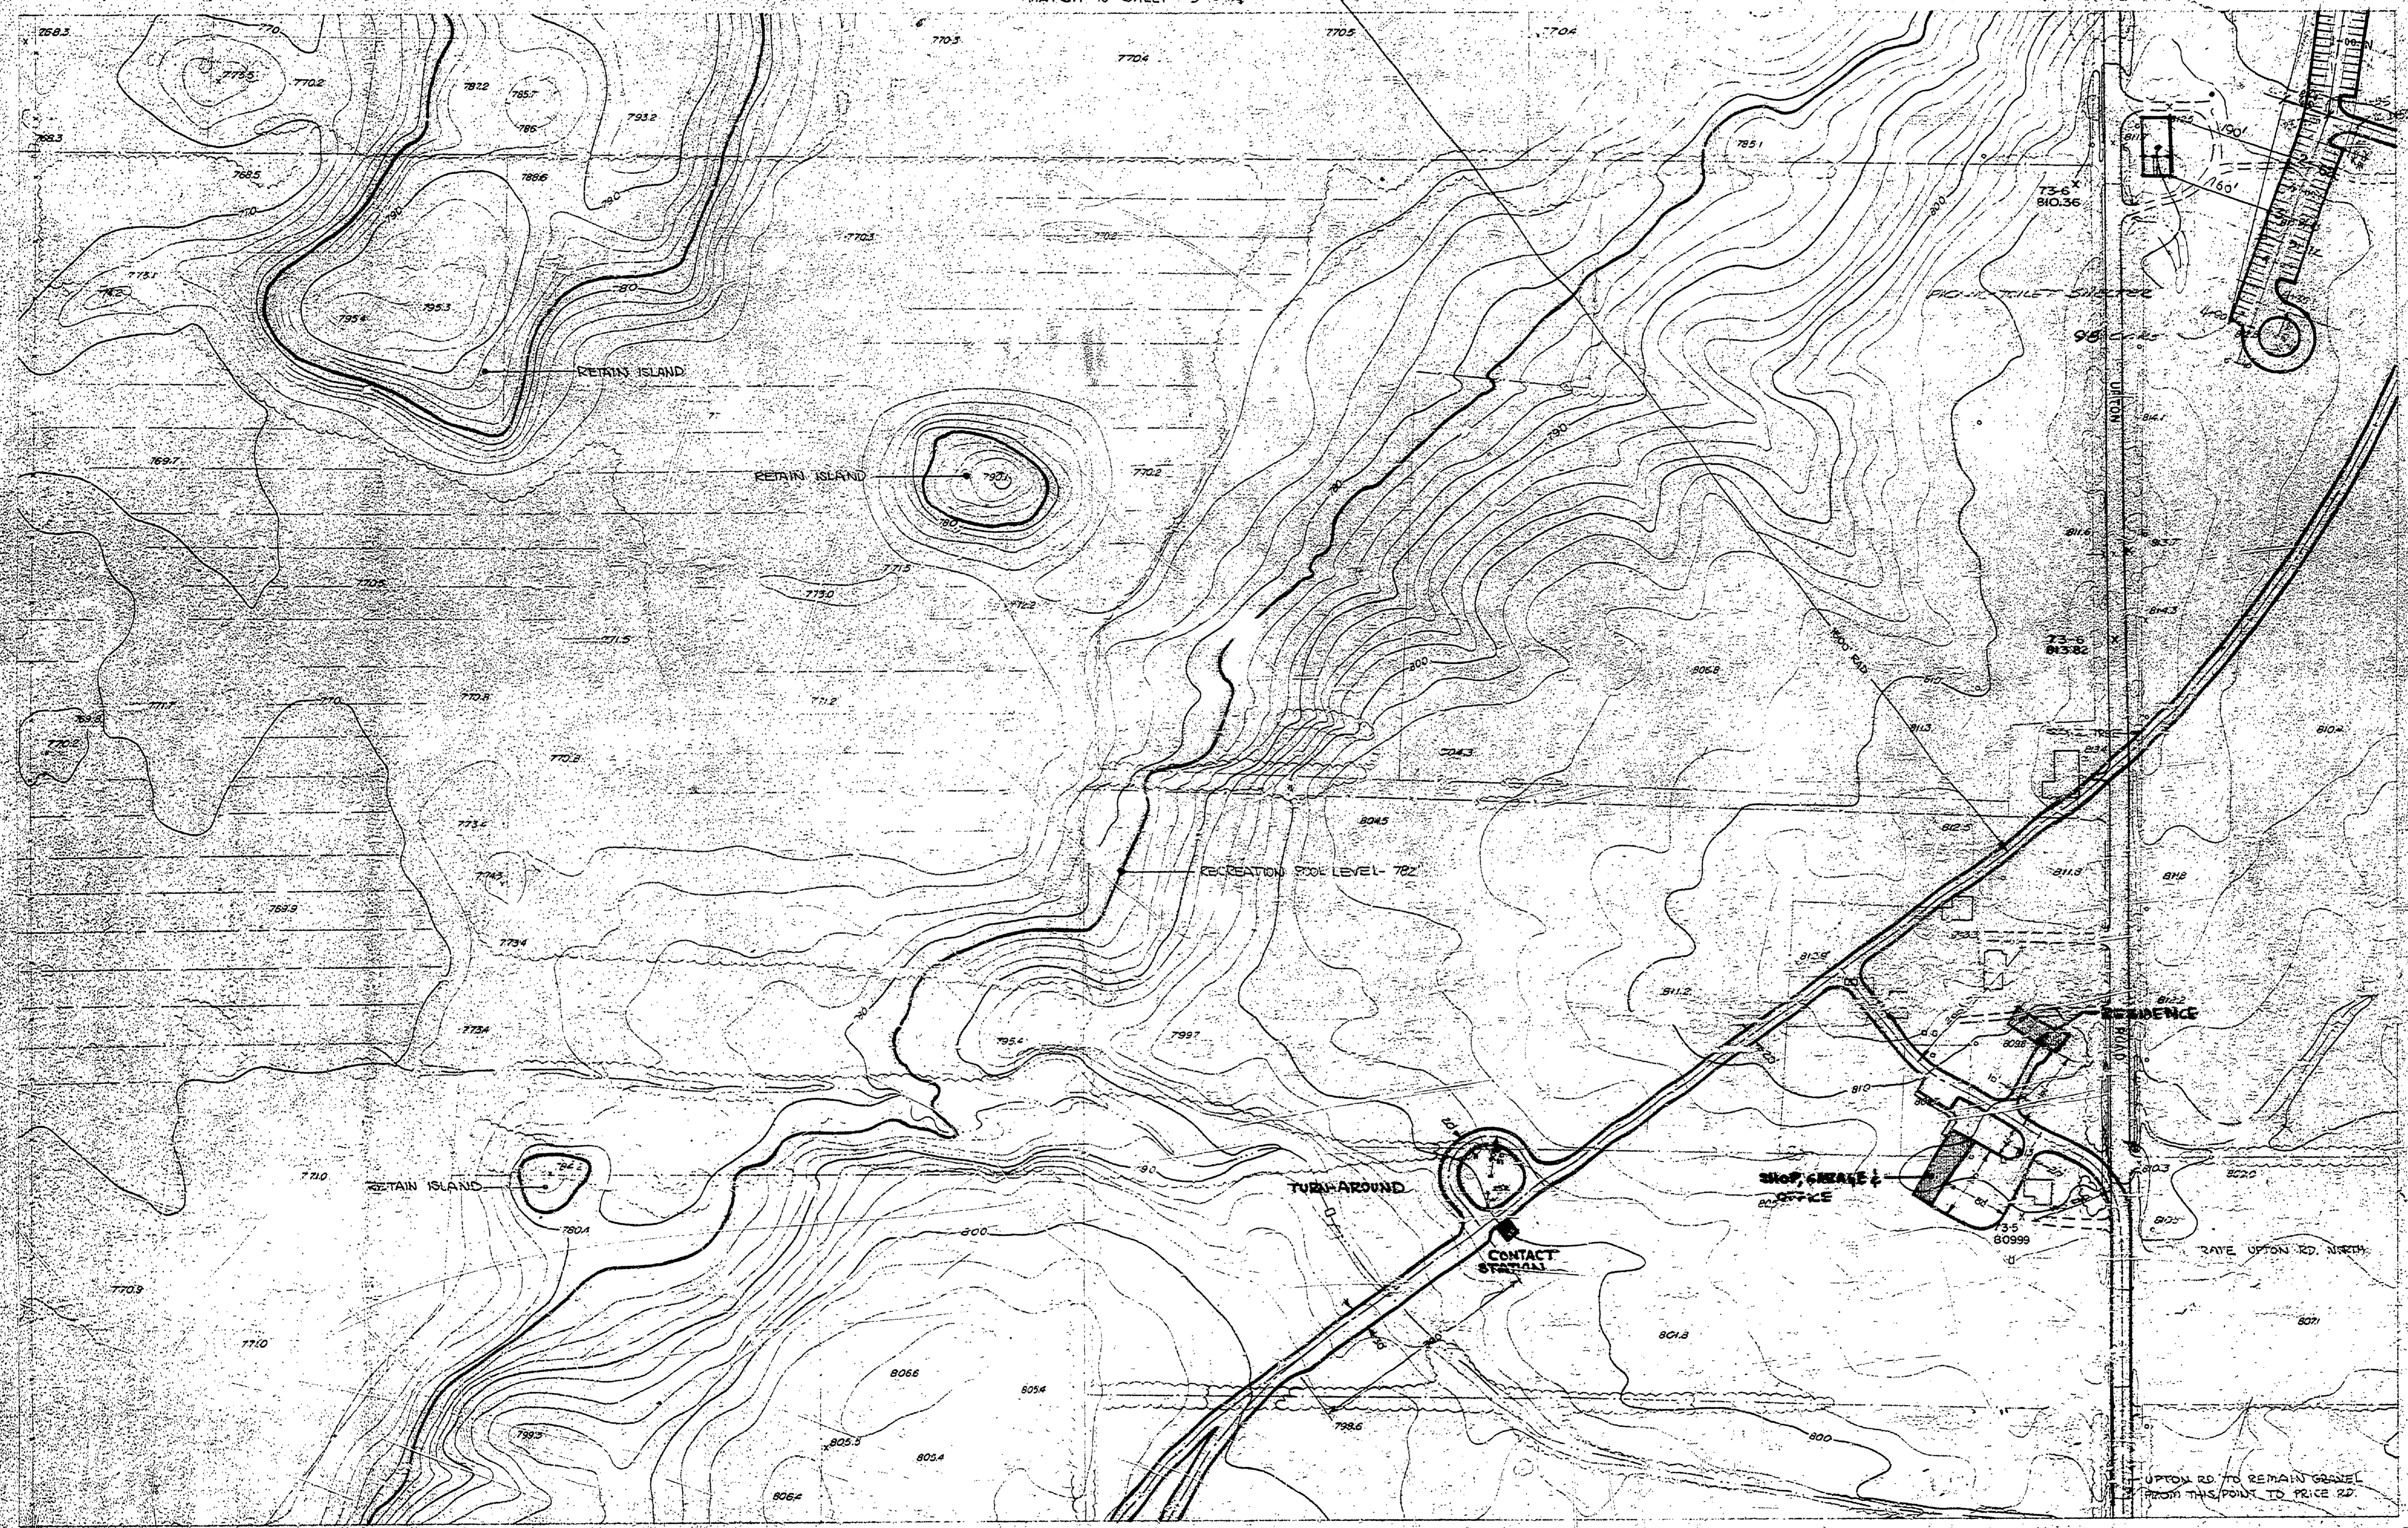

MATCH TO SHEET 2 OF 5

NORTH
SCALE 1" = 100'

DATE OF PHOTOGRAPHY APRIL 1966 DATE OF MAPPING JUNE 1966

SURVEYED BY	DRAWN BY 600	9-78	NO. DATE BY	REVISIONS	NO. DATE BY	REVISIONS	MICHIGAN DEPARTMENT OF CONSERVATION	SLEEPY HOLLOW STATE PARK	SHEET NO. OF	PARKING & PICNIC TOILET
DESIGNED BY 600	CHECKED BY 776	DATE	1. 12-21-78 BSW	CHANGED LOCATION OF PICS. OFFICE SHOP	3.		SCALE 1" = 100'	CONTOUR INTERVAL 2'	FOR PROJECT NO.	SHEET 2 OF 5 PLAN NO. 1-116
			2. 11-12-78 BSW	ADD NEW TURNAROUND SIGN	4.					