
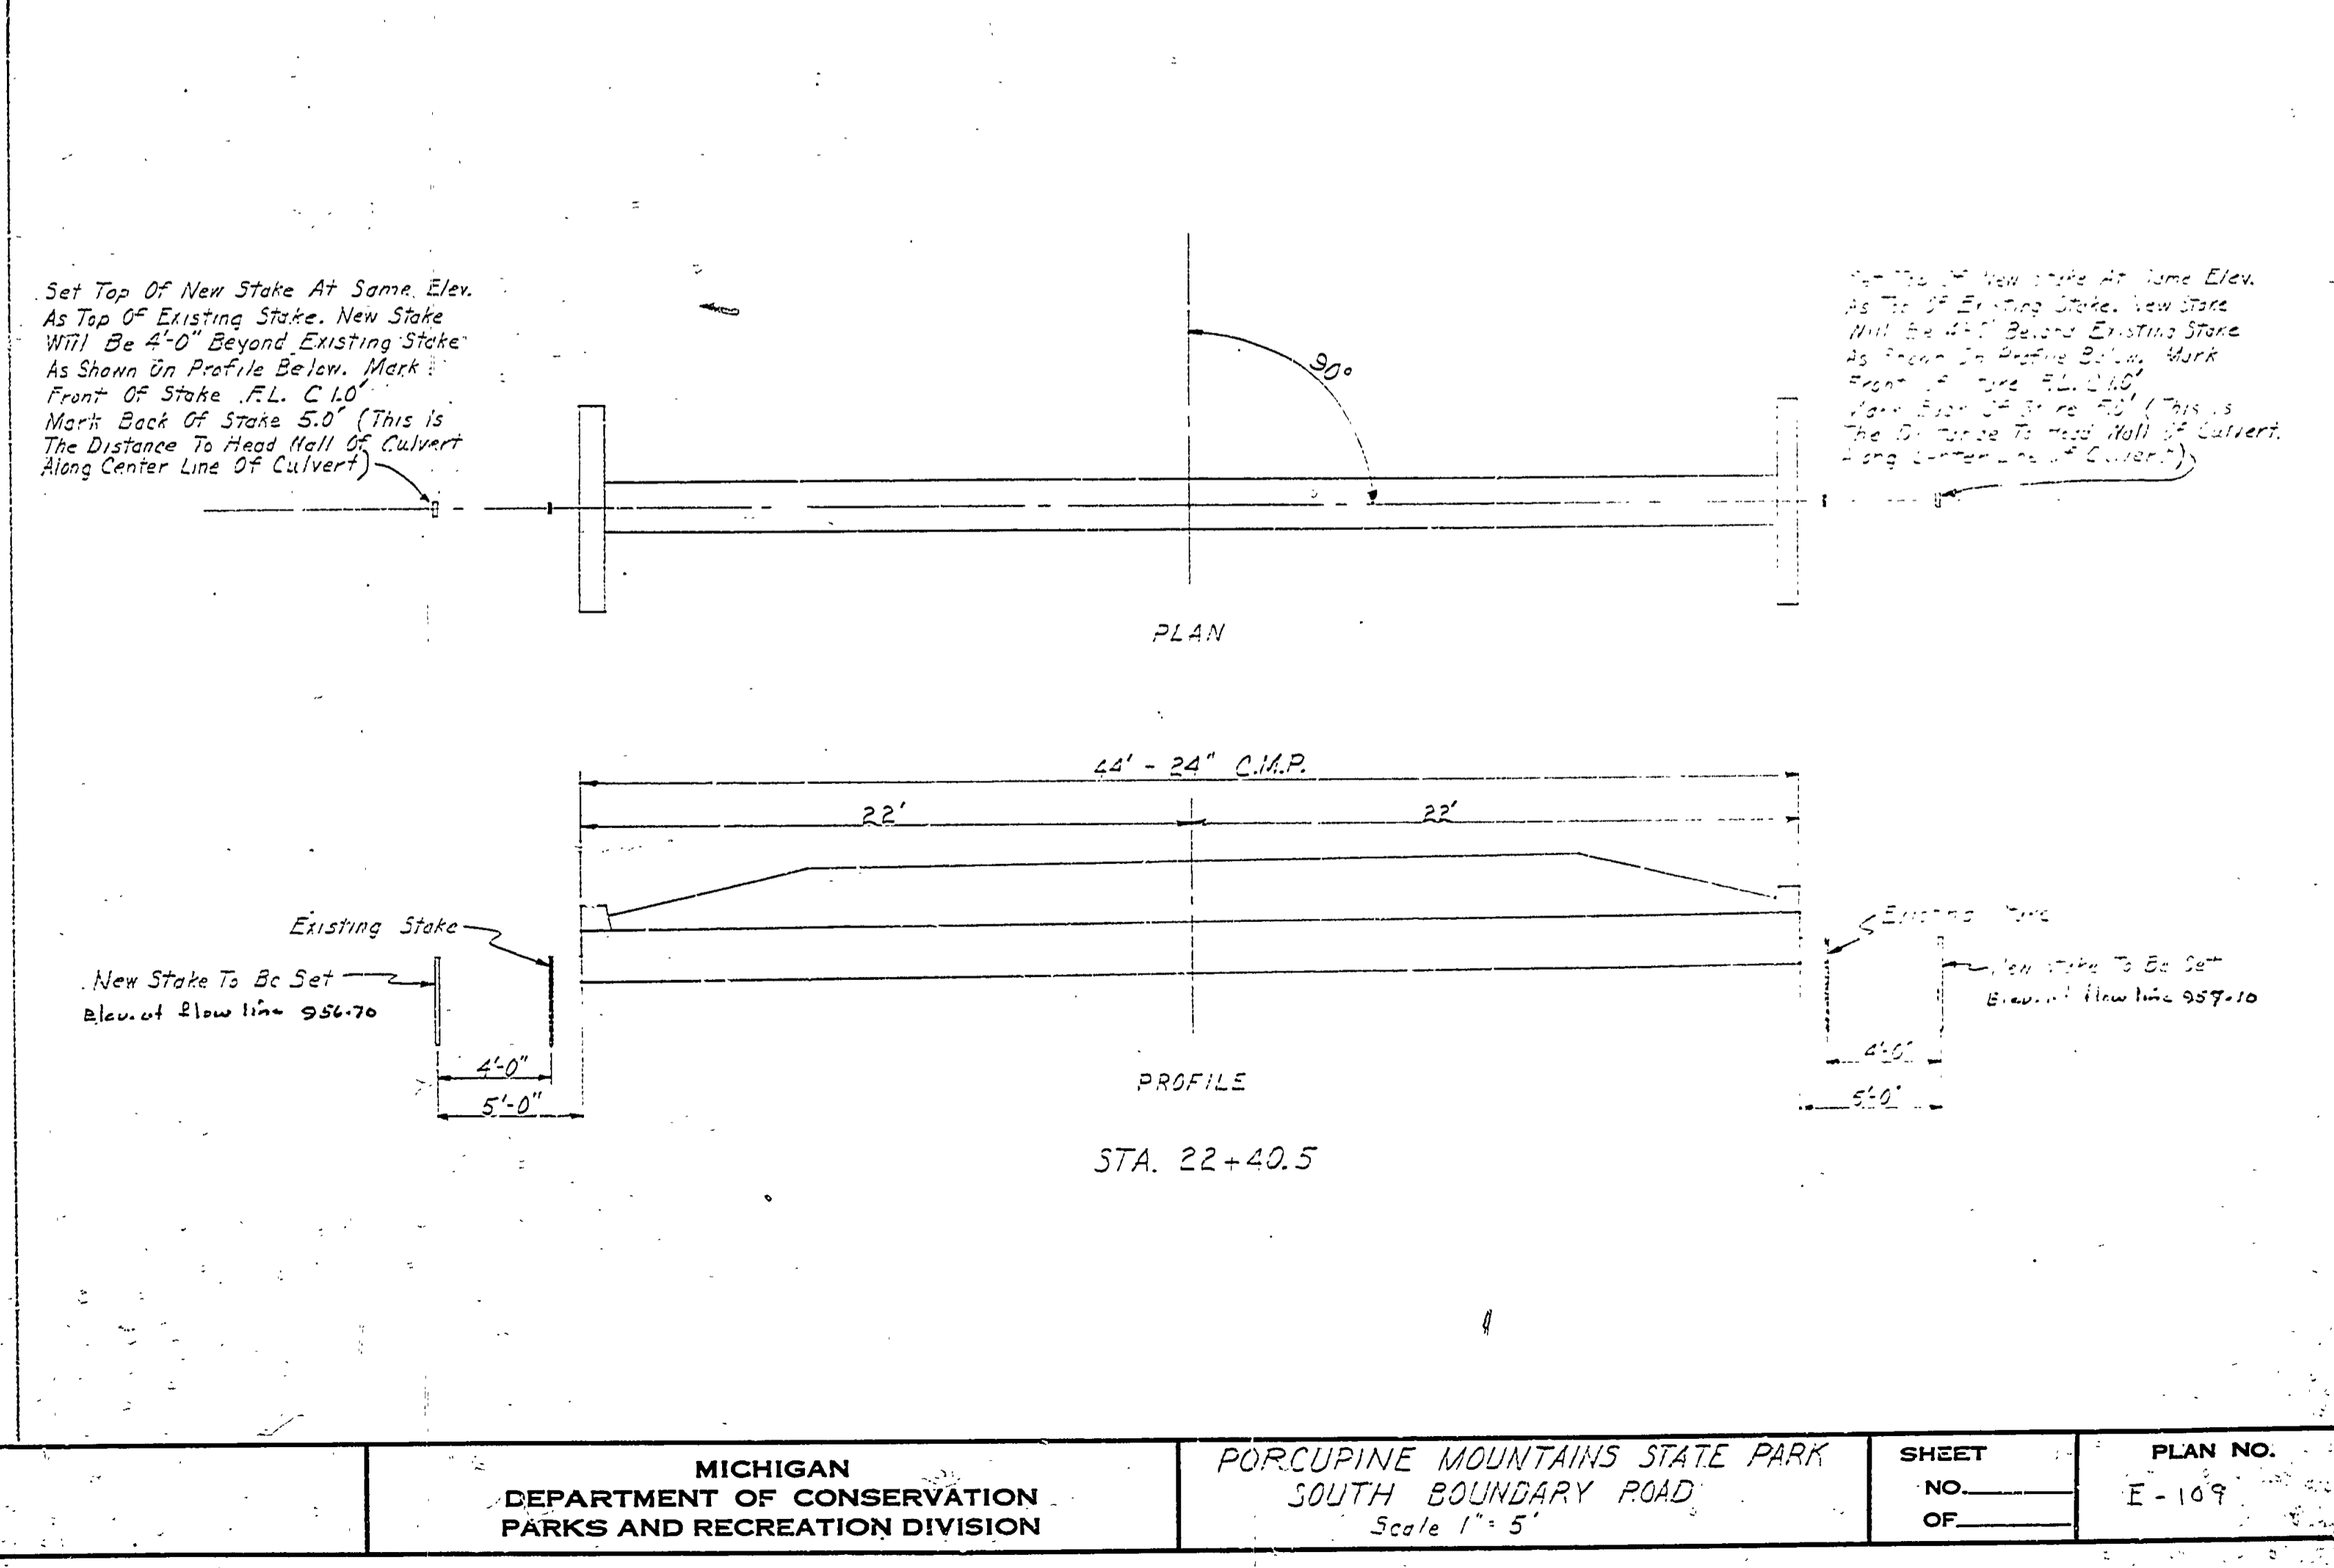
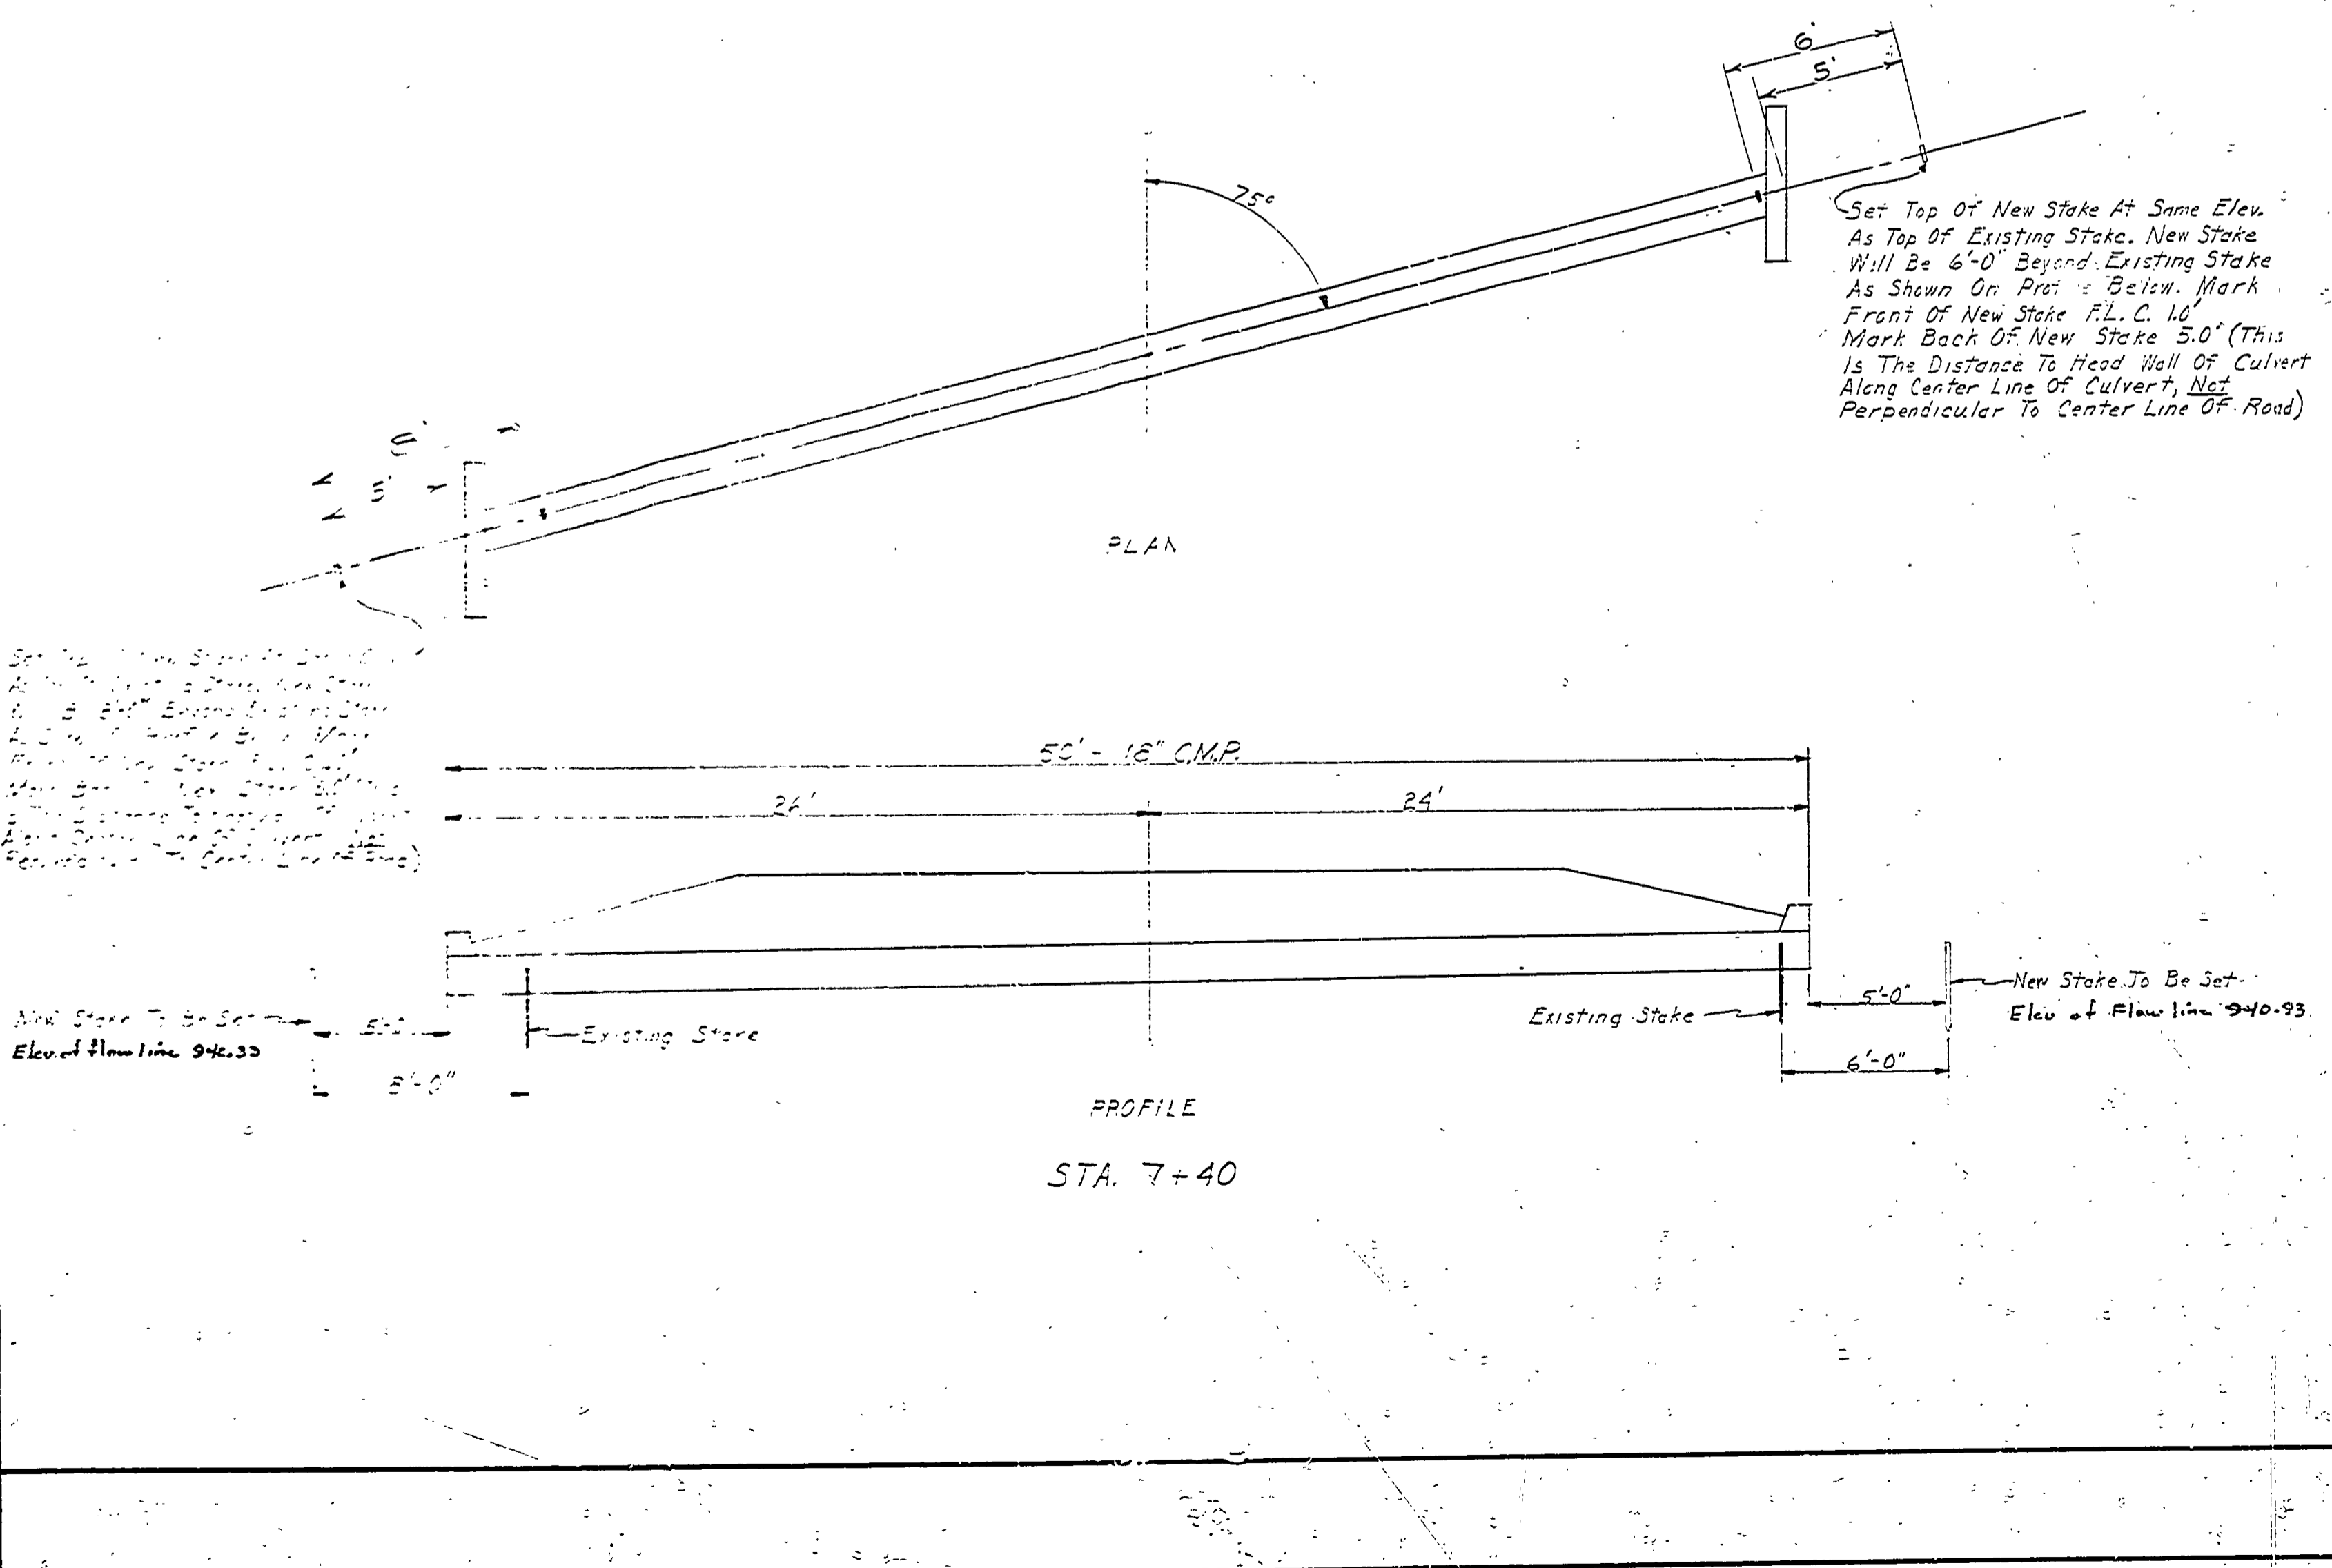
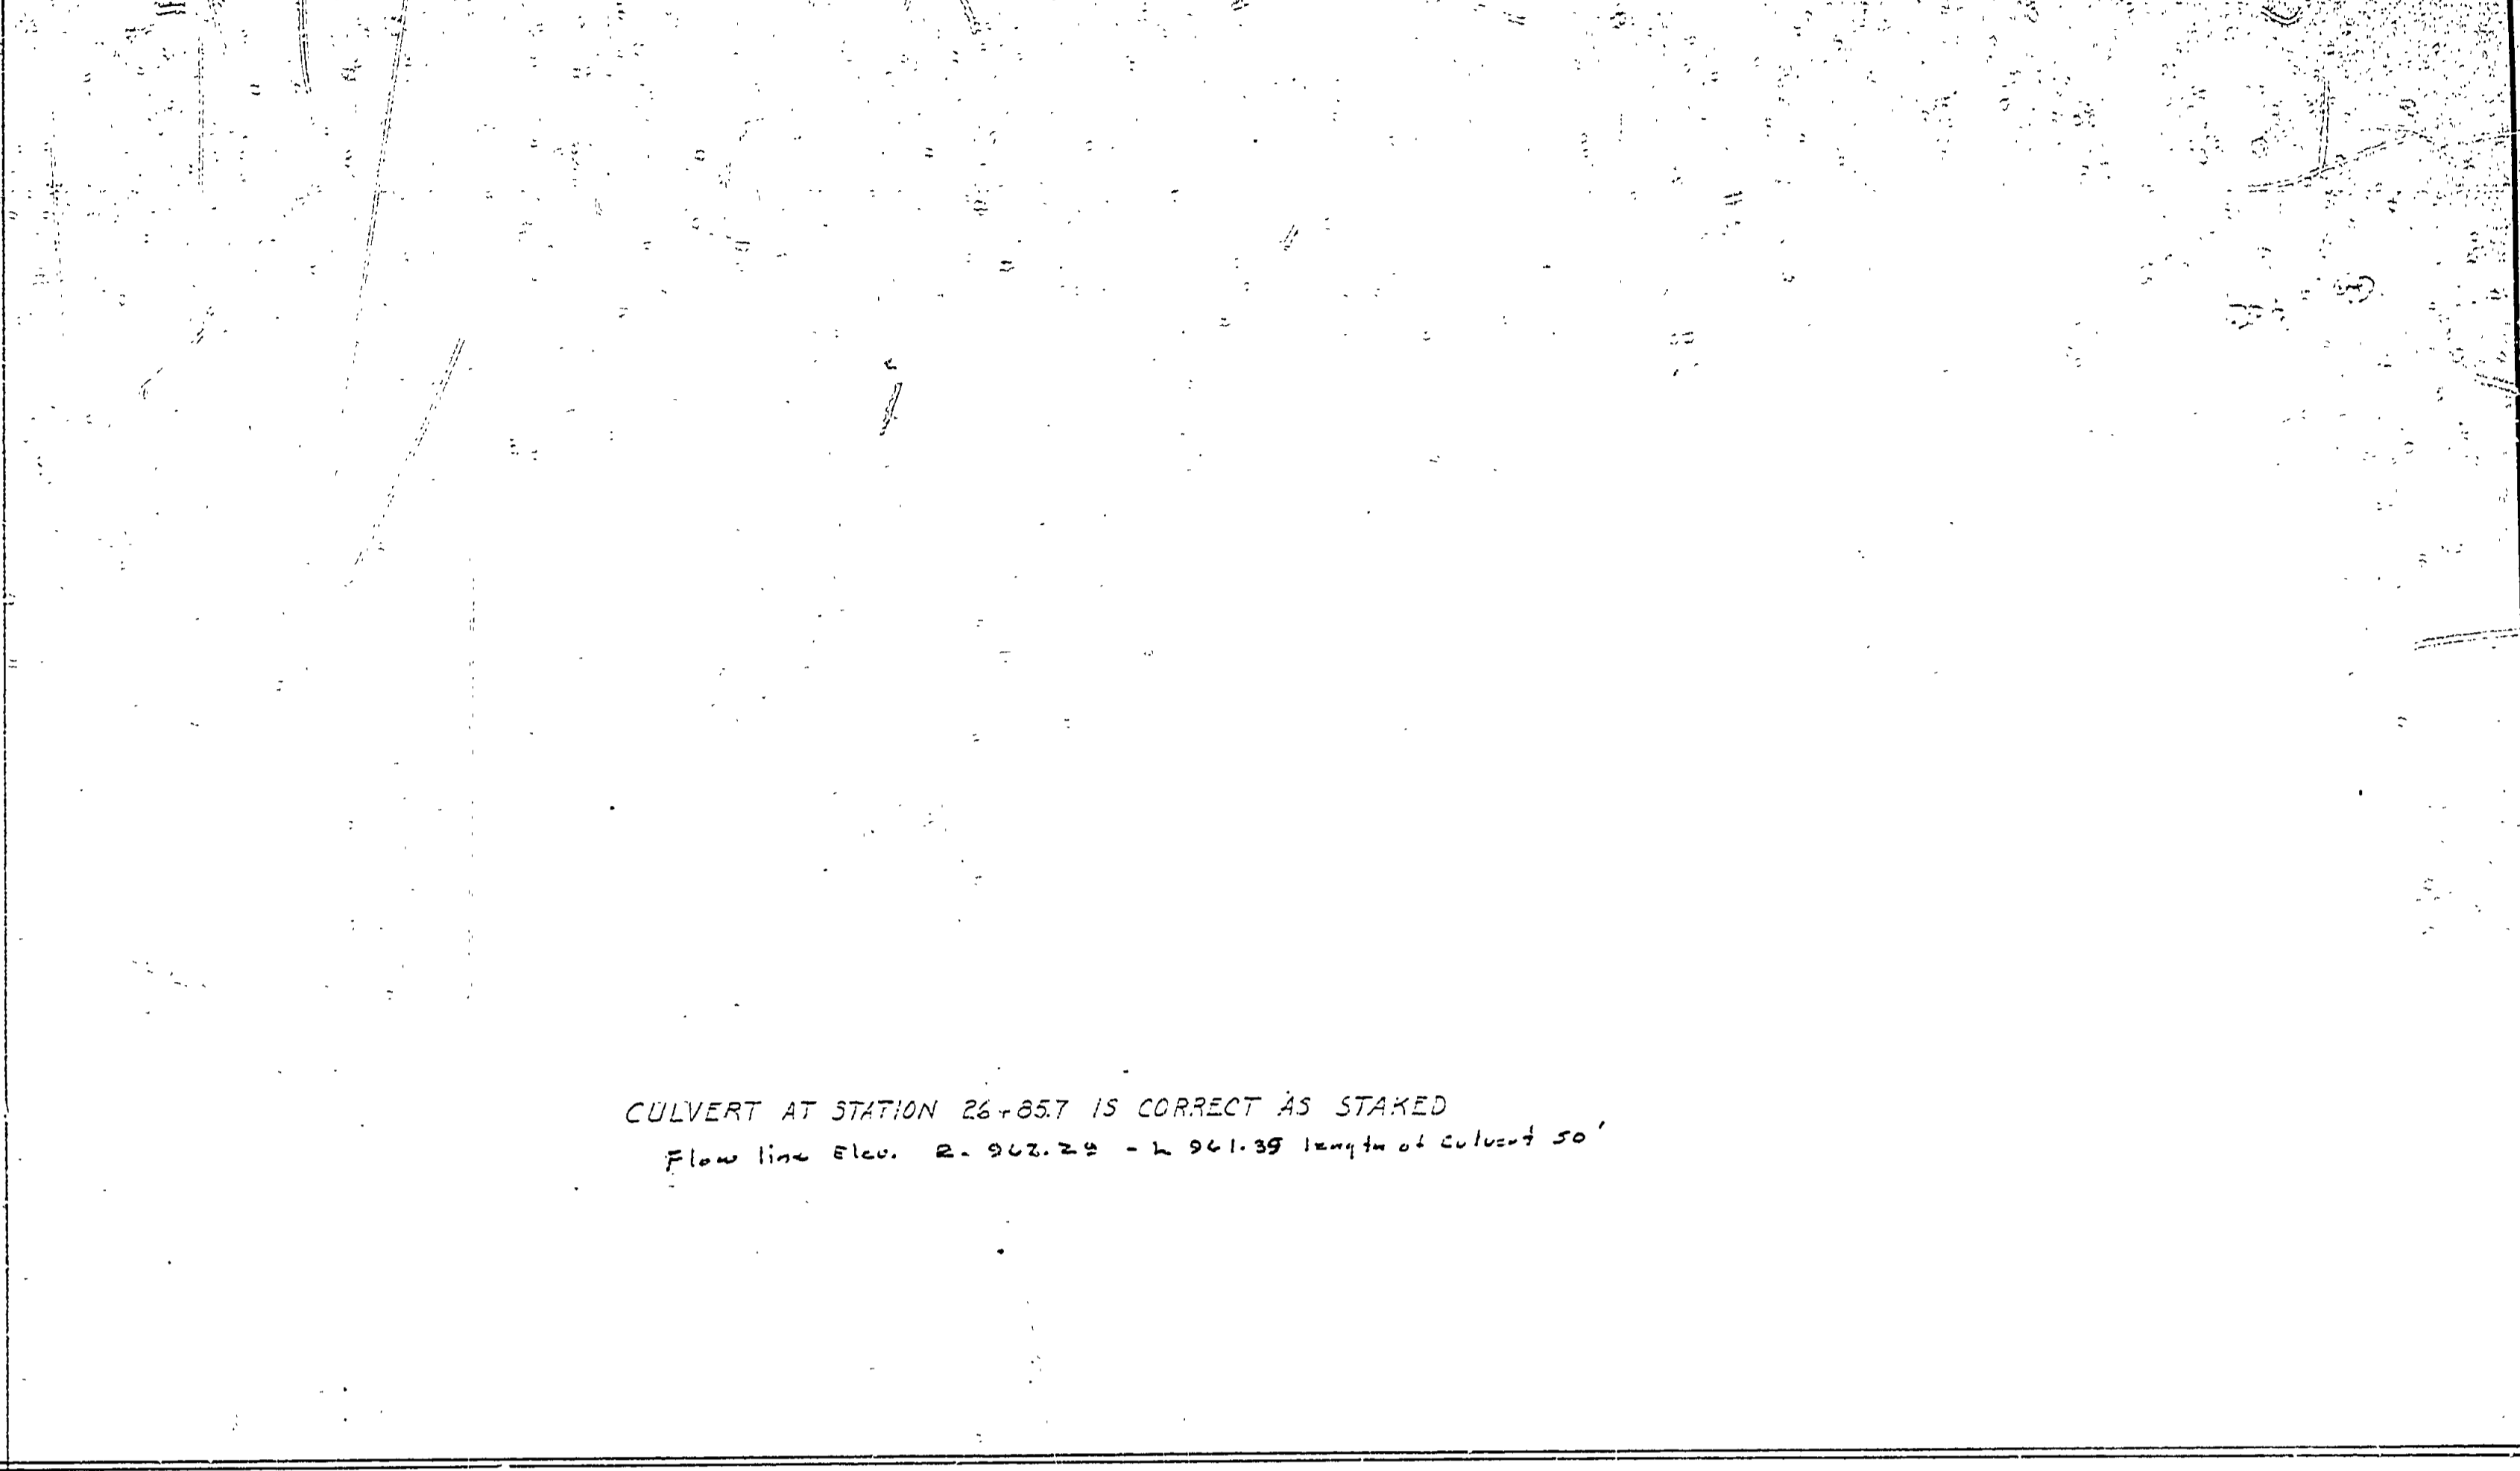


DRAWN BY B.H.G.	CHECKED BY R.H.S.	DATE	REVIEWED BY SECTIONS		APPROVED		NO.	DATE	BY	REVISIONS
			ARCHITECTURAL	LANDSCAPE	DATE	DATE				
			ENGINEERING		ASSISTANT CHIEF IN CHARGE					

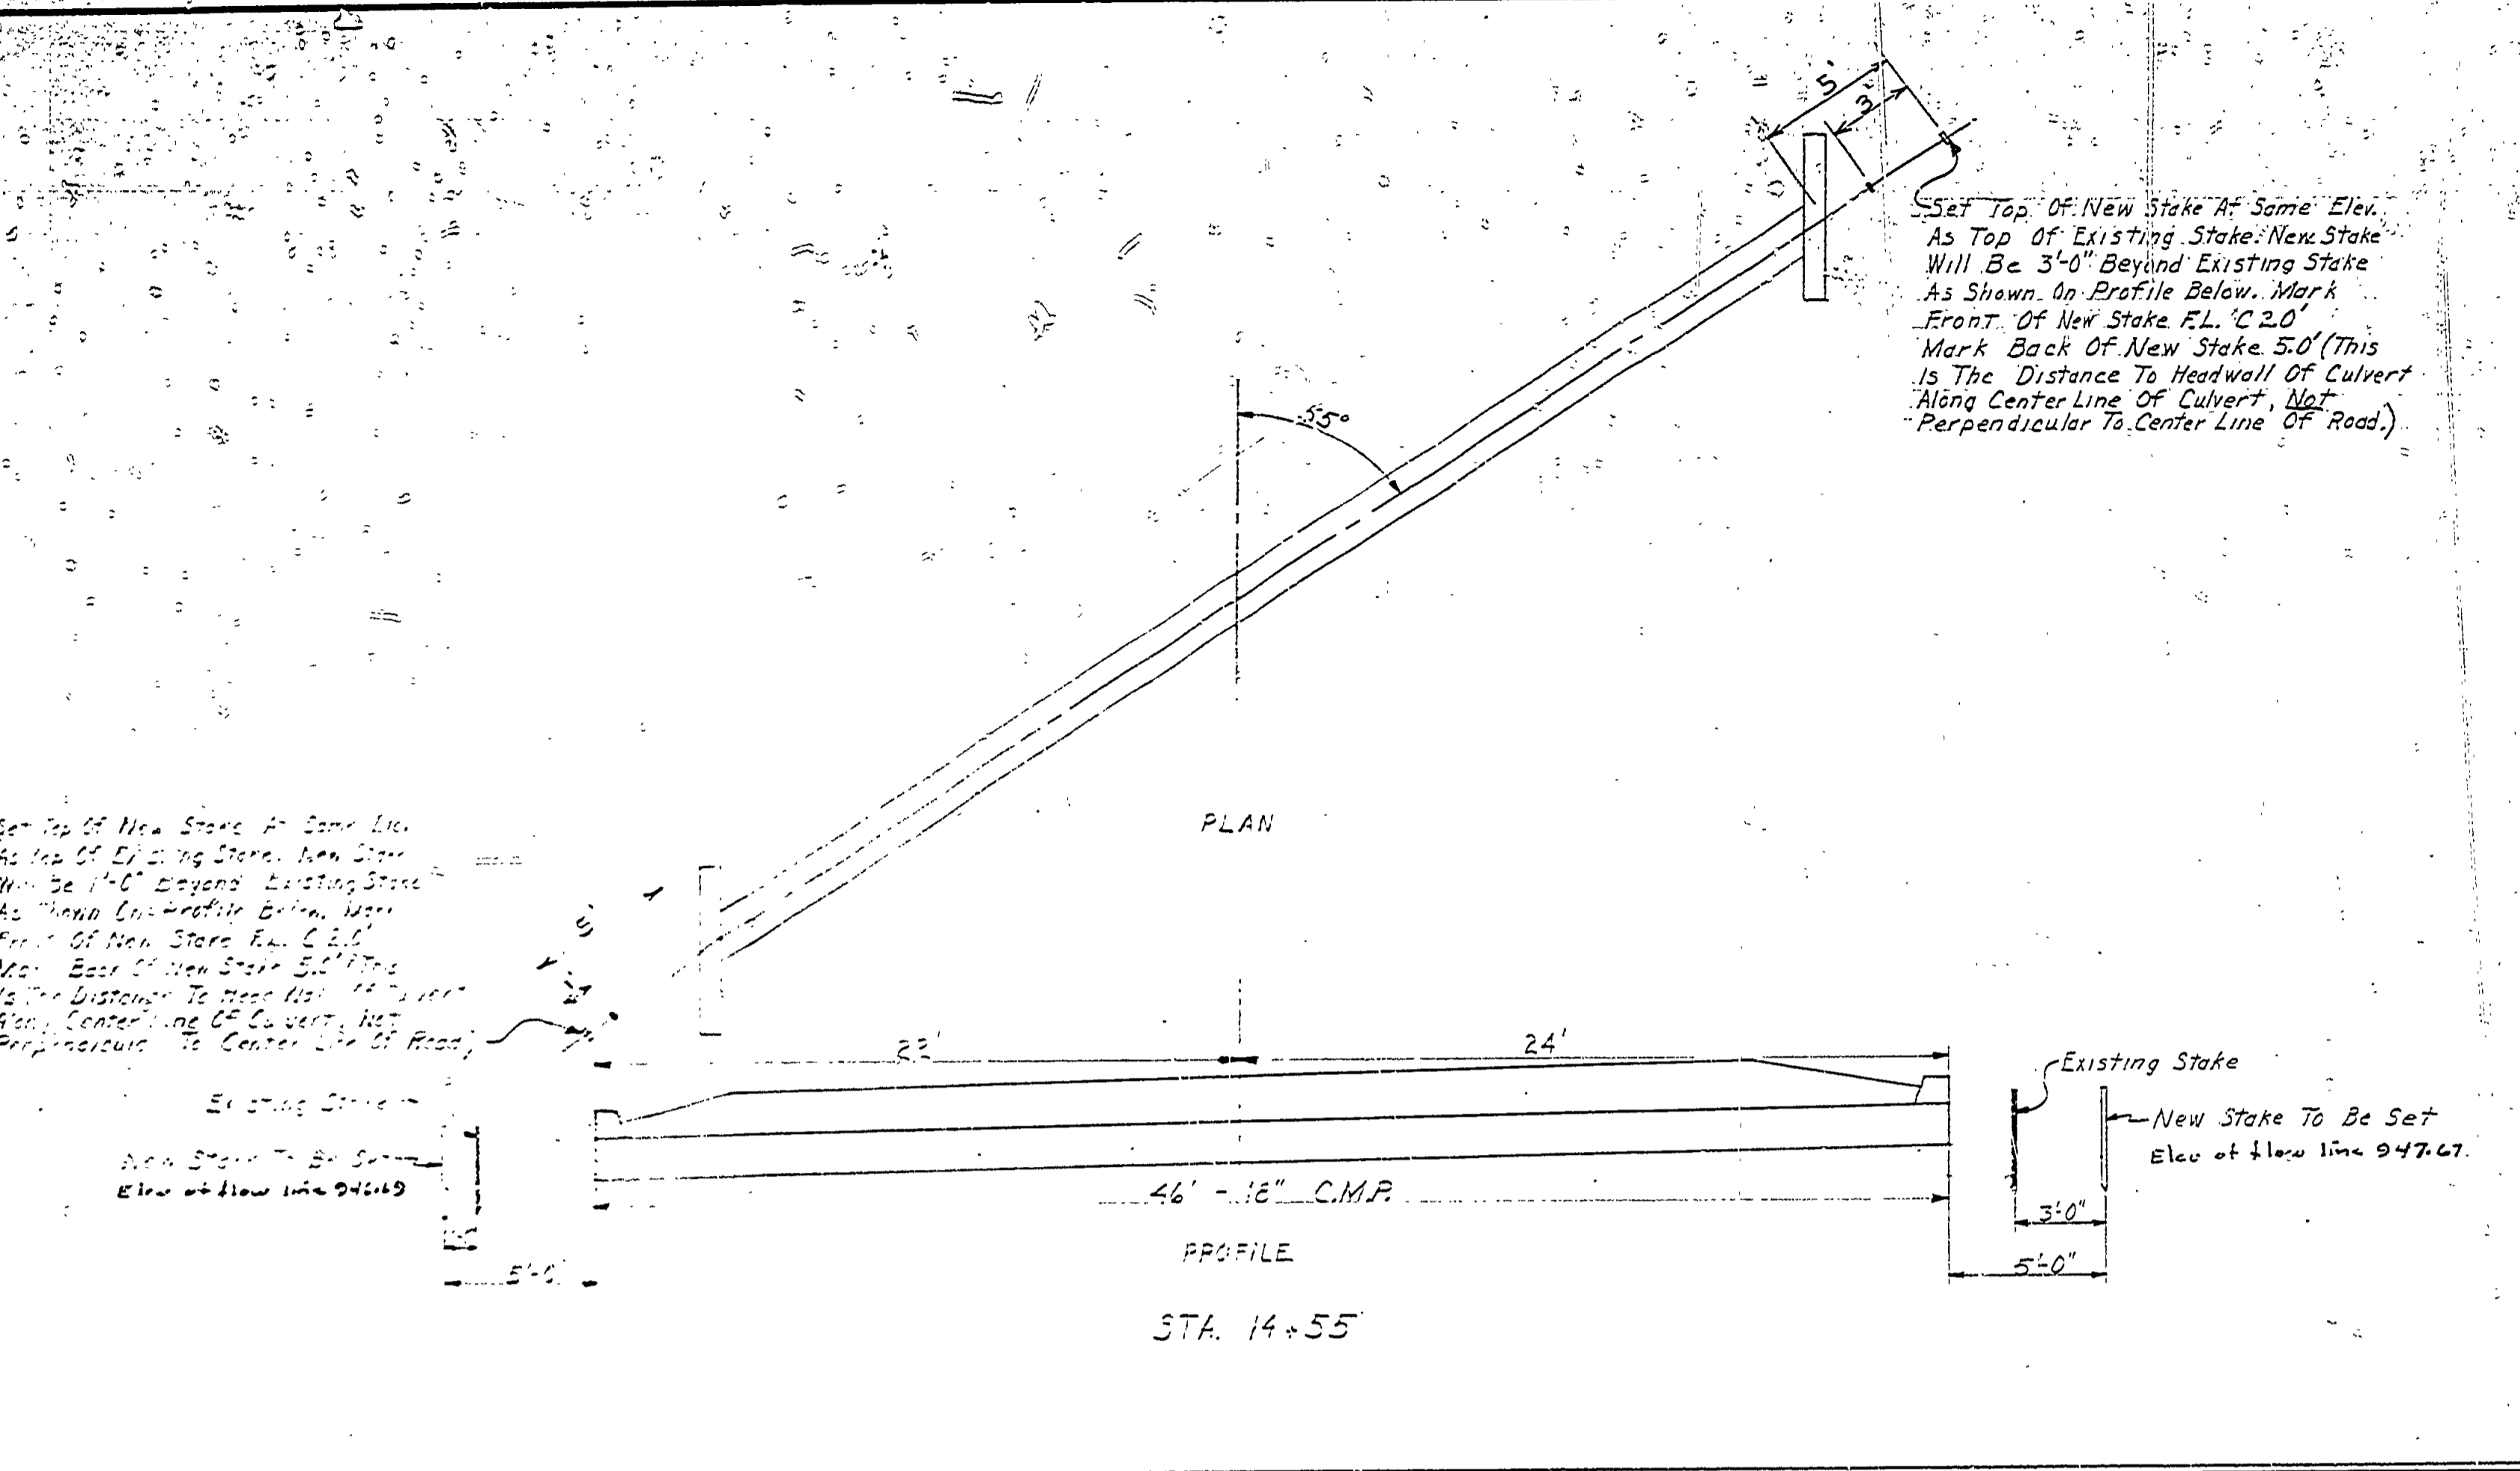

MICHIGAN
DEPARTMENT OF CONSERVATION
PARKS AND RECREATION DIVISION

PORCUPINE MOUNTAINS STATE PARK
SOUTH BOUNDARY ROAD
Scale 1" = 5'

SHEET NO. OF	PLAN NO. E-109
--------------	----------------