


# MASS DIAGRAM

SCALES HOR. 1" = 1000 FT.  
VER. 1" = 2000 CU. YDS.

ROUTE	STATE	PROJECT	SHEET NO.	TOTAL SHEETS
5-1040 (1)	INDIANA		13	14
CS66-55 Ontonagon Corp Lake				
ROUTE	STATE	PROJECT	SHEET NO.	TOTAL SHEETS

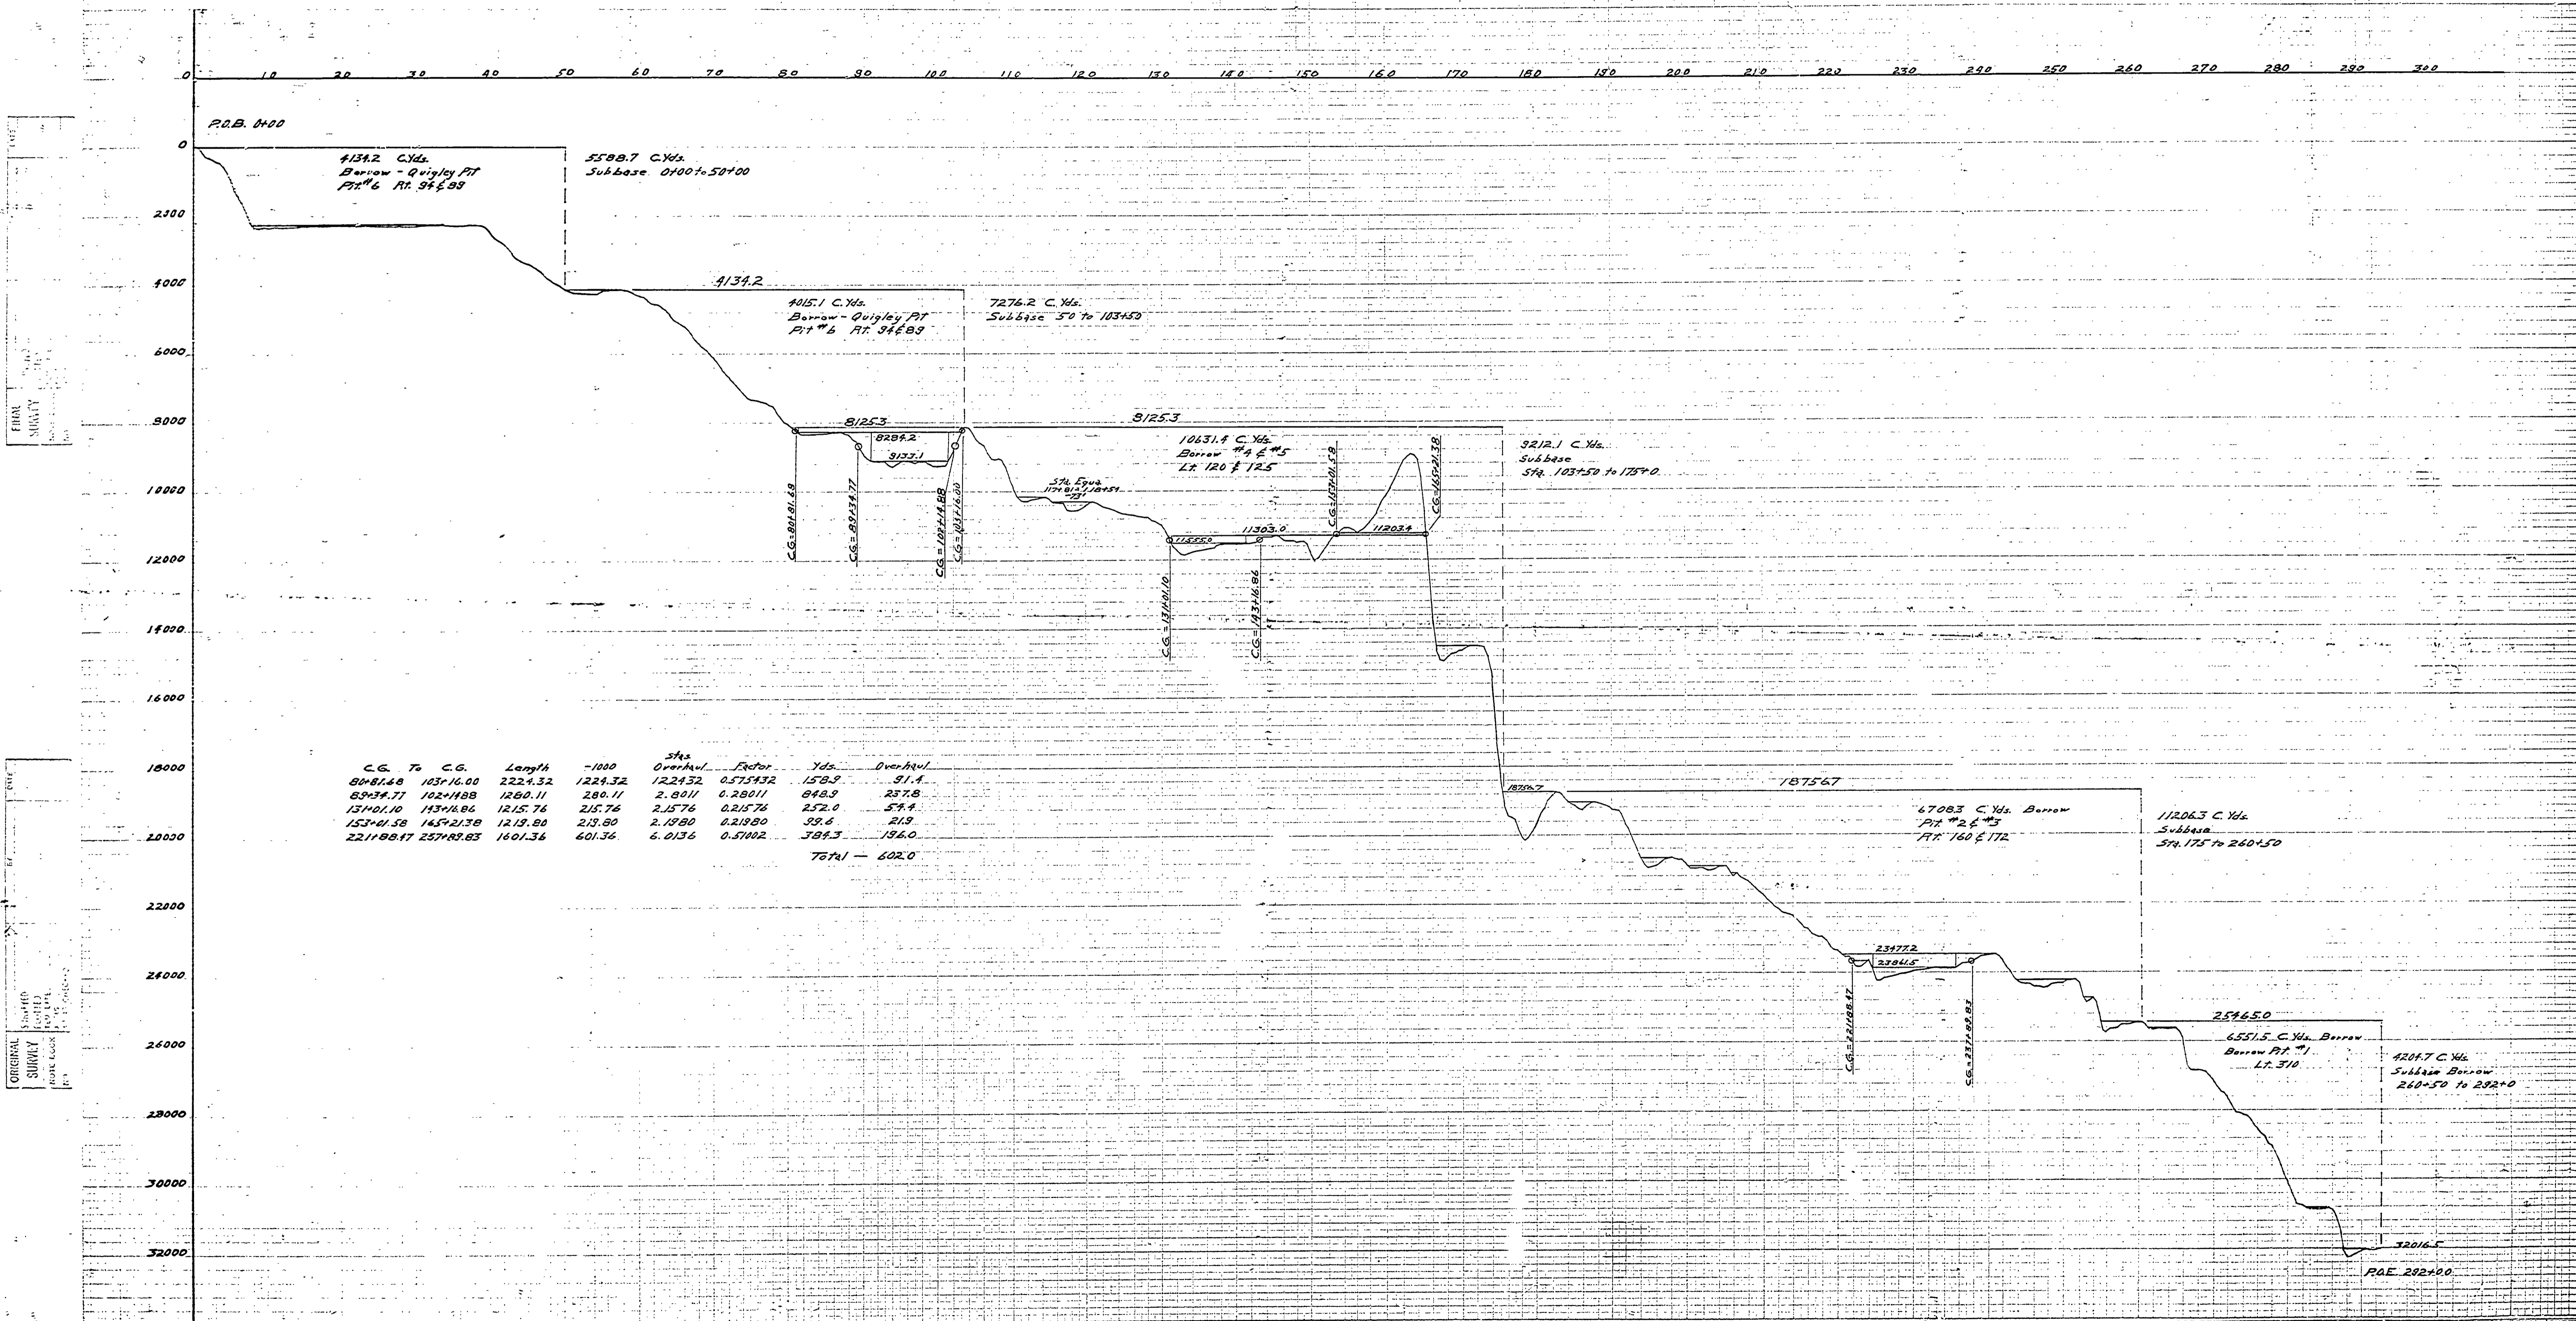

C.G. To C.G.	Length	-1000	Sta	Overhaul	Factor	Yds.	Overhaul
80+81.68	103+16.00	2224.32	1224.32	0.575432	158.9	51.4	
89+34.77	102+14.88	1280.11	2.8011	0.28011	848.9	257.8	
131+01.10	113+14.86	1215.76	215.76	0.21576	252.0	54.4	
153+01.58	165+21.38	1219.80	219.80	0.21980	39.6	21.9	
221+88.17	257+83.83	1601.36	601.36	0.51002	389.3	196.0	
76741 - 602.0							

South Boundary Rd. Sta 0-292 AS CONSTRUCTED

DATE	BY	CHECKED	APPROVED
CS66-55 51040 (1) 13			