

Curve Data  
 $\Delta$  - 11° 01' 00" Lt.  
 D - 3° 00'  
 R - 1910.05'  
 T - 154.2'  
 L - 387.2'  
 E - 8.9'  
 PC Sta. 847+25.9  
 PI Sta. 849+10.1  
 PT Sta. 850+93.8

BM N° 108 - El. 816.59  
 PK Nail, Tag (M&H) & Washer  
 in S. Root of 10" Maple, 70' Rt.  
 of Sta. 855+80.

Curve Data  
 $\Delta$  - 13° 03' 00" Lt.  
 D - 3° 00'  
 R - 1910.05'  
 T - 218.5'  
 L - 437.0'  
 E - 125'  
 PC Sta. 853+94.6  
 PI Sta. 856+13.1  
 PT Sta. 858+29.8

PI Sta. 856+13.1  
 1" Pipe  
 N40°W 76.25' 10" Maple  
 N15°W 62.65' 2" Maple  
 N20°E 59.60' 9" Maple  
 BM N° 109 - El. 801.54  
 PK Nail, Tag (M&H) & Washer  
 in S. Root of 6" Maple,  
 110' Rt. of Sta. 863+50

Curve Data  
 $\Delta$  - 29° 49' 30" Lt.  
 D - 5° 00'  
 R - 1146.28'  
 T - 305.2'  
 L - 537.3'  
 E - 69.9'  
 PC Sta. 863+39.3  
 PI Sta. 866+44.8  
 PT Sta. 869+35.8

PI Sta. 866+44.8  
 1" Pipe  
 S40°E 57.75' 10" Heml.  
 S10°E 46.20' 12" Heml.  
 S20°W 38.30' 22" Maple  
 BM N° 110 - El. 776.95  
 PK Nail, Tag (M&H) &  
 Washer in Root of 12"  
 Hemlock, 80' Rt. of Sta.  
 872+30

Curve Data  
 $\Delta$  - 13° 28' 00" Lt.  
 D - 5° 00'  
 R - 1146.28'  
 T - 135.3'  
 L - 206.4'  
 E - 8.9'  
 PC Sta. 870+80.9  
 PI Sta. 872+16.2  
 PT Sta. 873+50.3

PI Sta. 872+16.2  
 N27°W 52.91' 11" Hemlock  
 N8°E 41.68' 5" Hemlock  
 N43°E 45.63' 7" Ironwood  
 BM N° 111 - El. 767.94  
 PK Nail, Tag (M&H) & Washer  
 in Root 10" Hemlock, 100' Rt.  
 of Sta. 875+70.

S.P. NO.	STATE	PROJ. NO.	FISCAL YEAR	SHEET NO.	TOTAL SHEETS
4	MICH.	51040(5)			
ROUTE	STATE	COUNTY	TWP	SHEET NO.	TOTAL SHEETS
FAS 27-48	Gogebic	Wakefield	10		

S.P. NO.	STATE	PROJ. NO.	FISCAL YEAR	SHEET NO.	TOTAL SHEETS
4	MICH.				
ROUTE	STATE	COUNTY	TWP	SHEET NO.	TOTAL SHEETS

Const & Curve Data  
 $\Delta$  6° 41' Lt.  
 D 2'  
 R 2362.93'  
 T 167.28'  
 L 532.17'  
 E 4.85'  
 PC Sta. 873+26.44  
 PI Sta. 875+65.72  
 PT Sta. 877+32.61  
 Superelevate 0.02'/ft.

Station Equation  
 Sta. 877+32.61 Back=  
 Sta. 877+36.37 Ahead  
 Line Shortens 3.76'


Curve Data Const &  
 $\Delta$  - 24° 04' 00" Lt.  
 D - 2° 30'  
 R - 2292.01'  
 T - 488.58'  
 L - 962.67'  
 E - 51.50'  
 PC Sta. 848+98.20  
 PI Sta. 853+86.78  
 PT Sta. 858+60.87  
 Superelevate 0.02'/ft.

Station Equation Const &  
 Sta. 858+60.87 Back equals  
 Sta. 858+67.78 Ahead  
 Line shortens 6.91'

Const & Curve Data  
 $\Delta$  23° 02' 22"  
 D 5°  
 R 1126.28'  
 T 233.56'  
 L 460.67'  
 E 23.55'  
 PC Sta. 863+39.35  
 PI Sta. 865+72.83  
 PT Sta. 867+99.97  
 Superelevate 0.03'/ft.

Gogebic County  
 Wakefield Township  
 T50 N, R 45 W

Spiegel Dindemann 1963

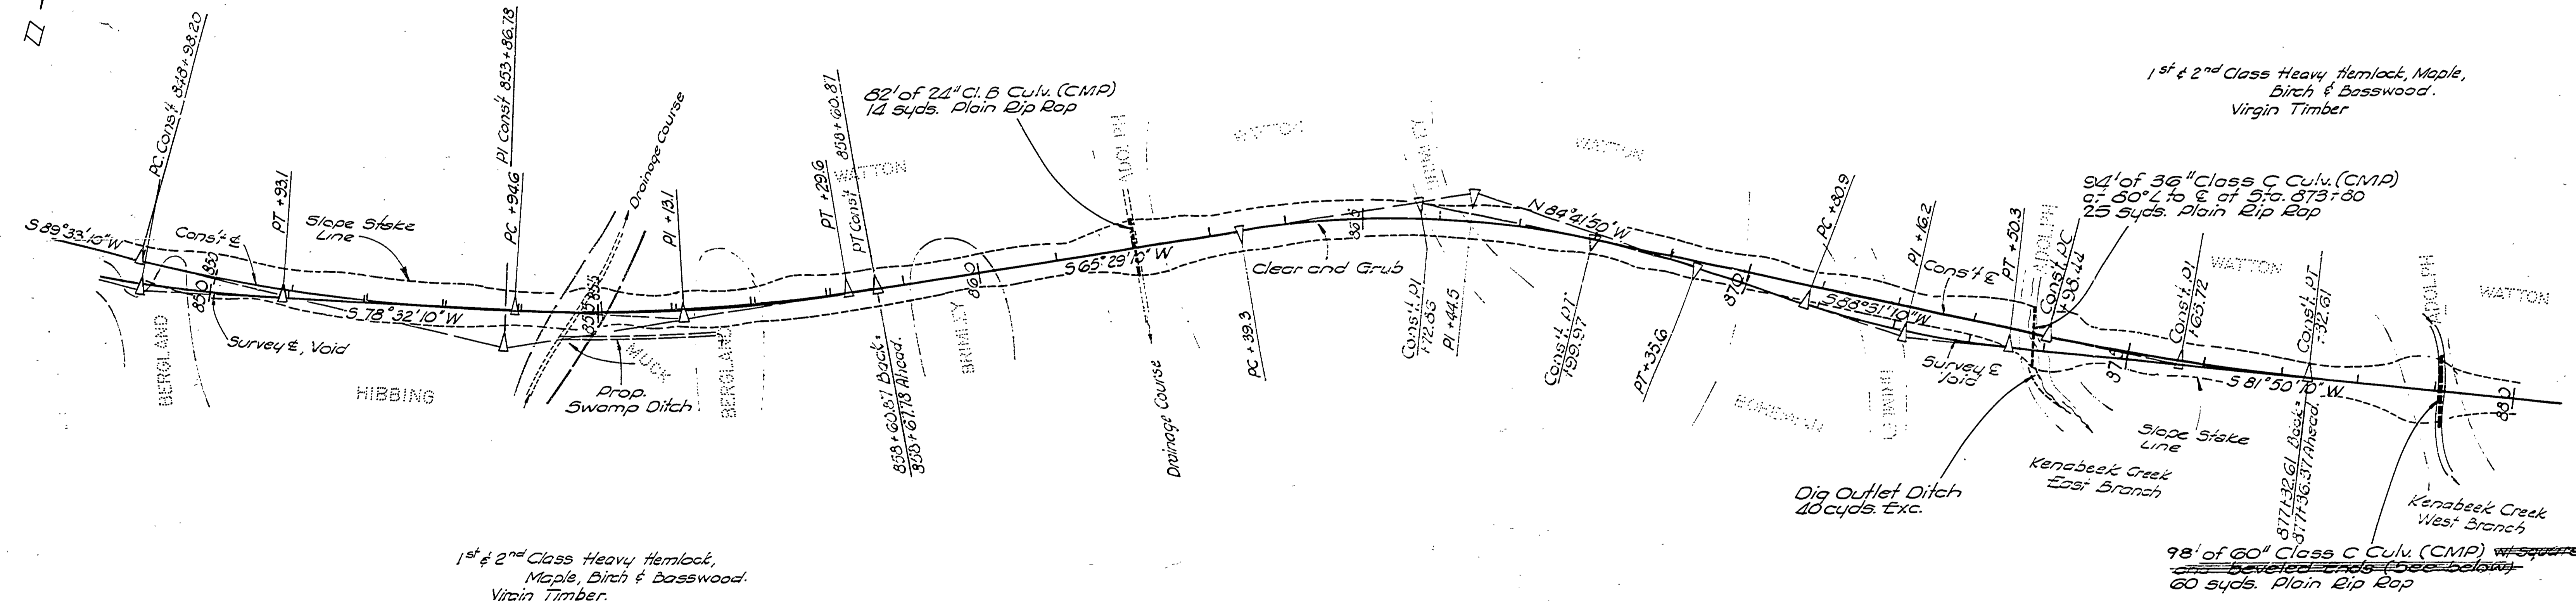

1st & 2nd Class Heavy Hemlock,  
 Maple, Birch & Basswood  
 Virgin Timber.

Sta. 850+00 to Sta. 880+00  
 Clearing (Special) 3.9 acres  
 Grubbing 624 sq. rds.

