




DESIGNED BY	DATE	REVIEWED	DATE	APPROVED	NO.	DATE	BY
ARCHITECTURAL	11-23-64	ENGINEERING	11-23-64		1		
ENGINEERING	11-23-64	LANDSCAPE	11-23-64		2		
LANDSCAPE	11-23-64				3		
CHECKED BY					4		
					5		
					6		

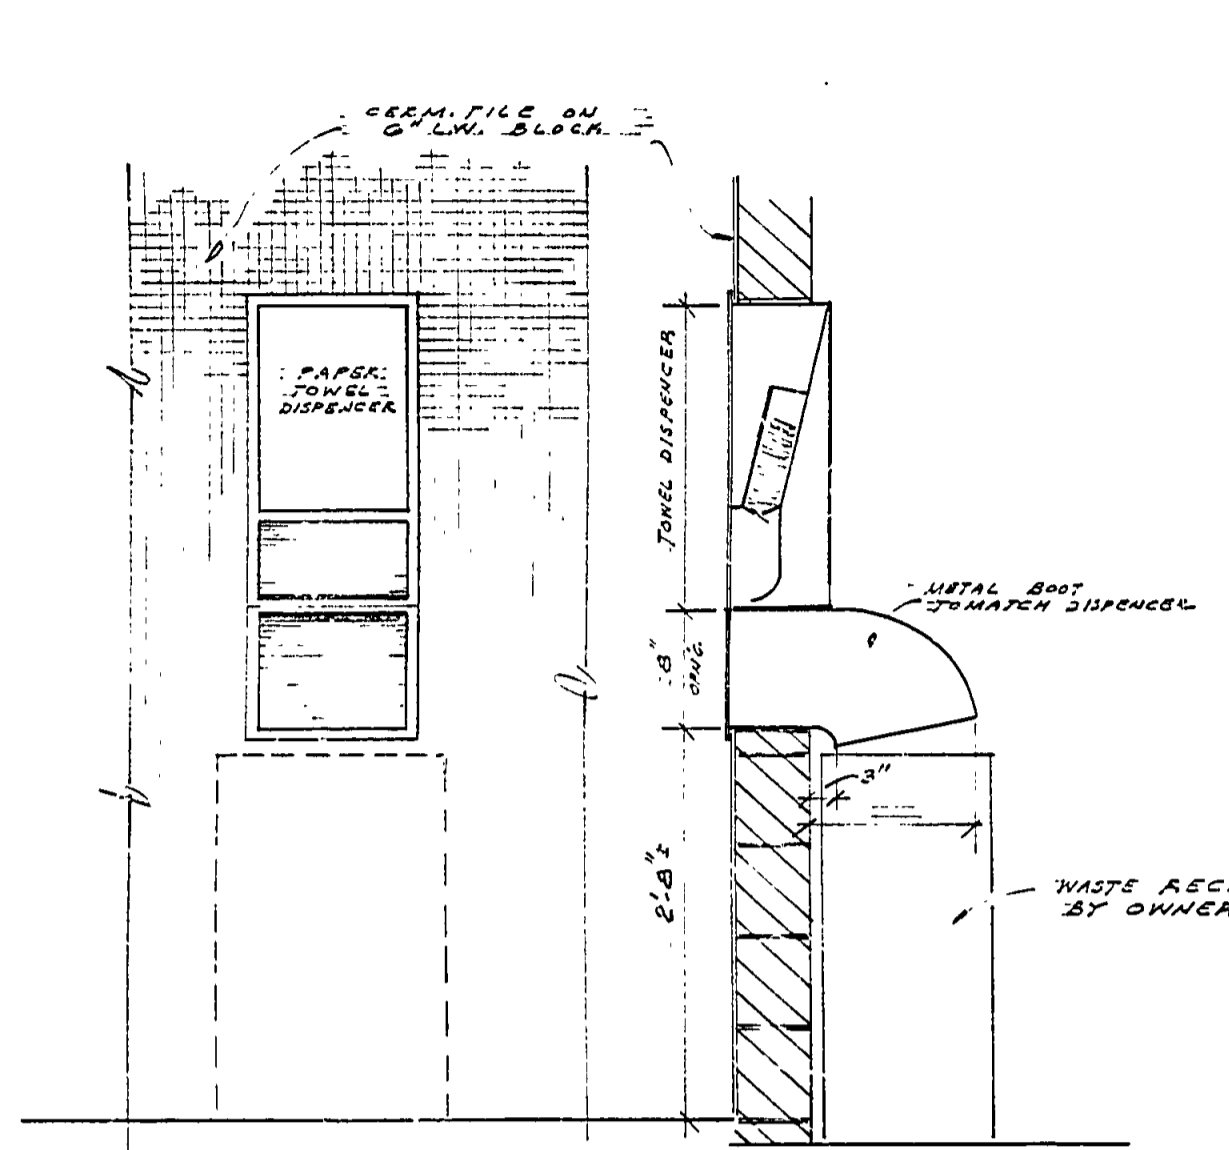


ELEVATION SECTION
RECESSED TOWEL DISPENSER
& WASTE DISPOSAL CHUTE
SCALE 3/4"=1'-0"

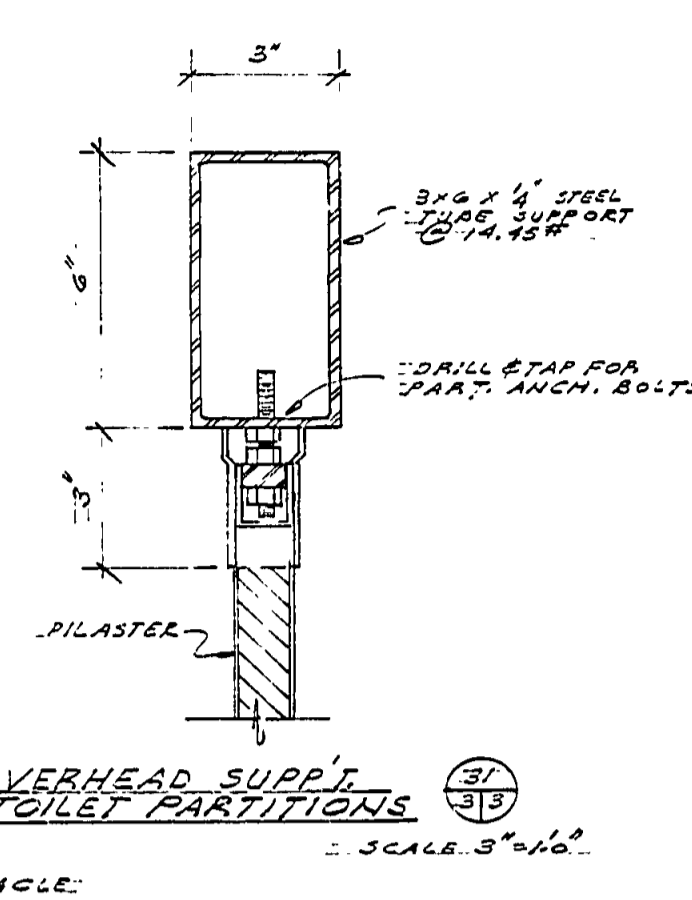


OVERHEAD SUPPT.
TOILET PARTITIONS
SCALE 3/4"=1'-0"

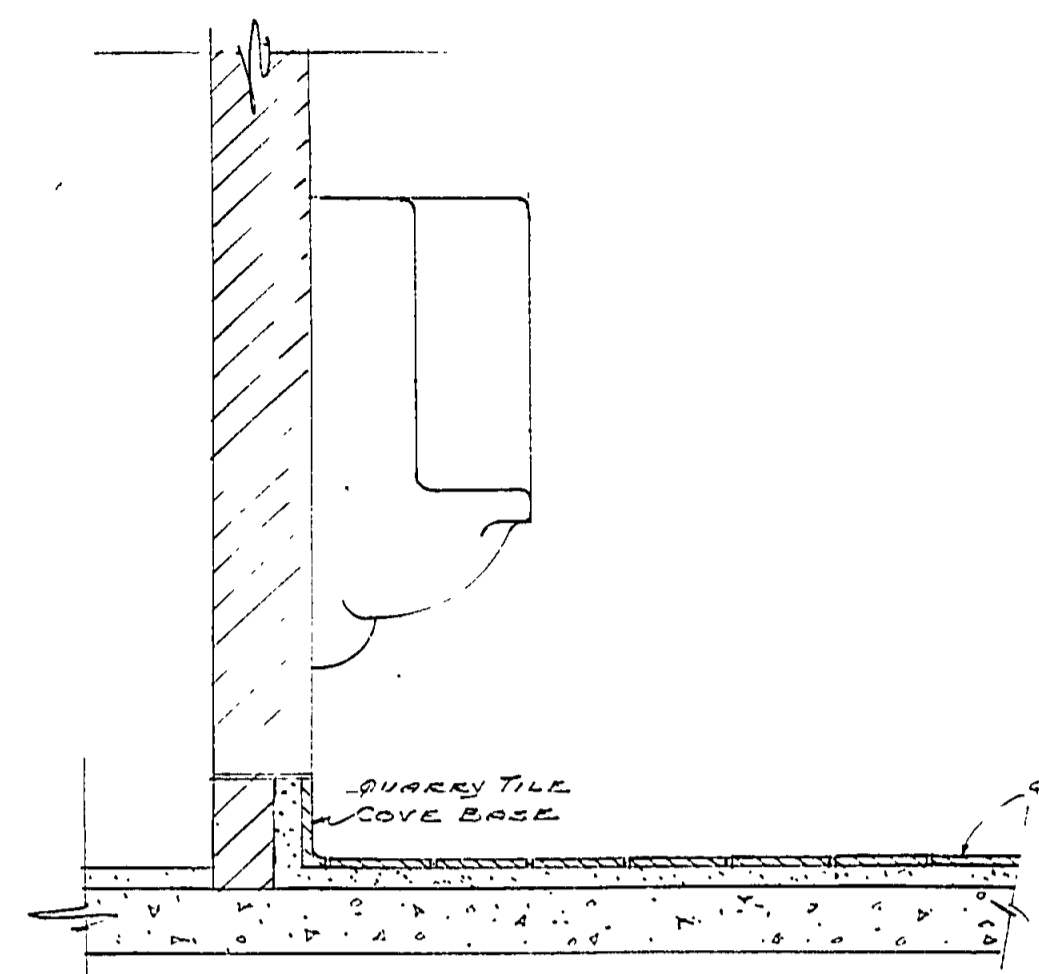


URINAL DETAIL
SCALE 1/2"=1'-0"

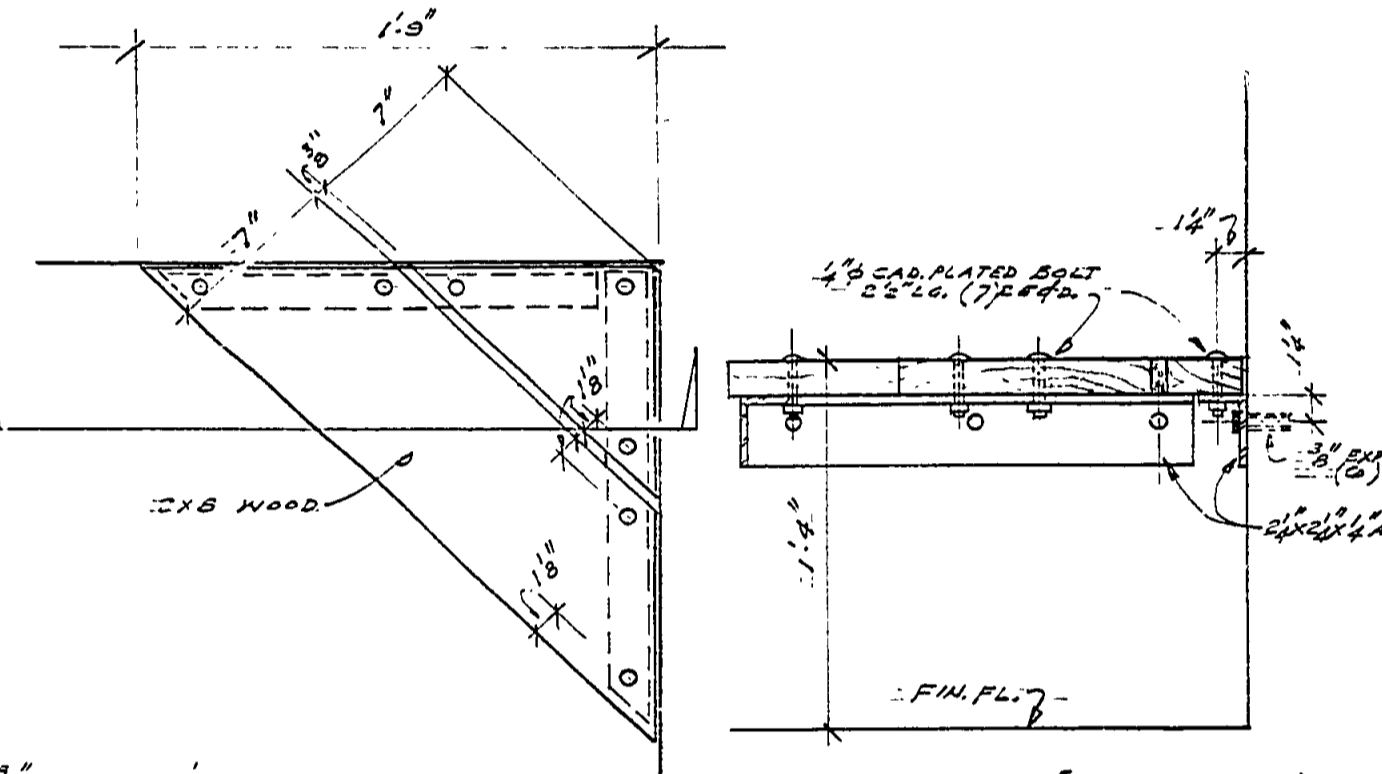


CORNER BENCH DETAIL (WOMENS RM)
SCALE 1/2"=1'-0"

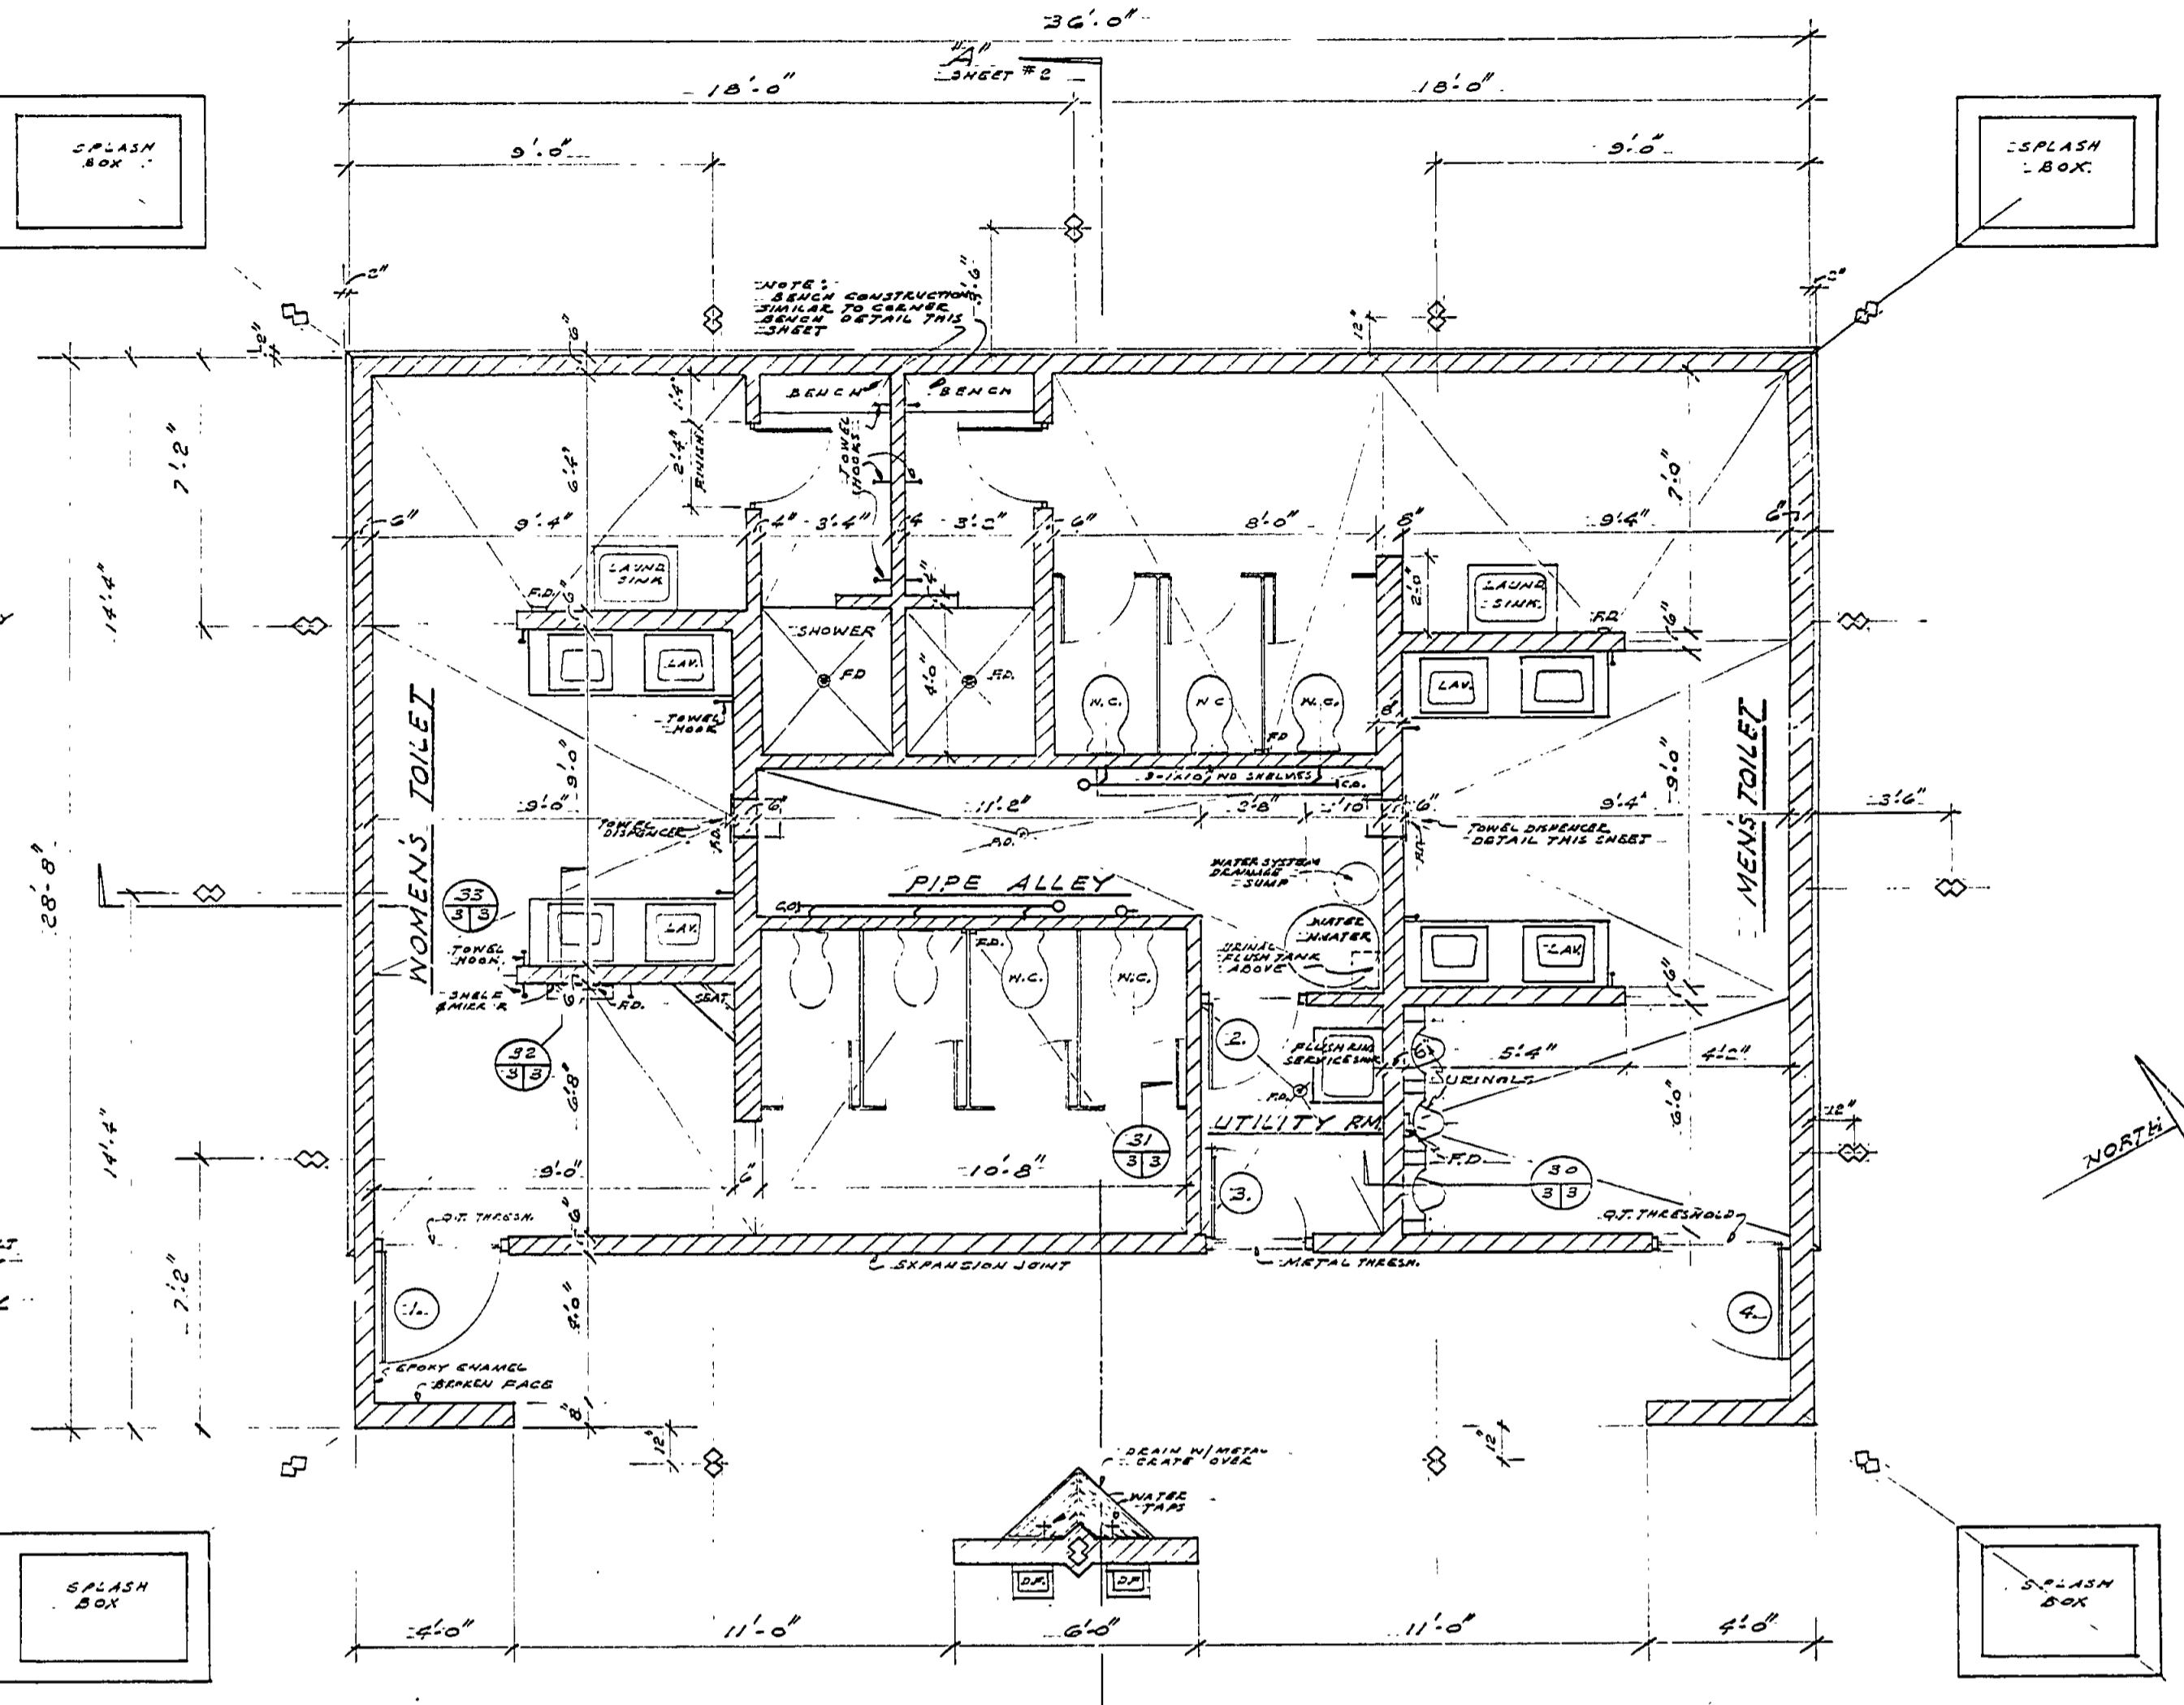


FLOOR PLAN
SCALE 1/8"=1'-0"

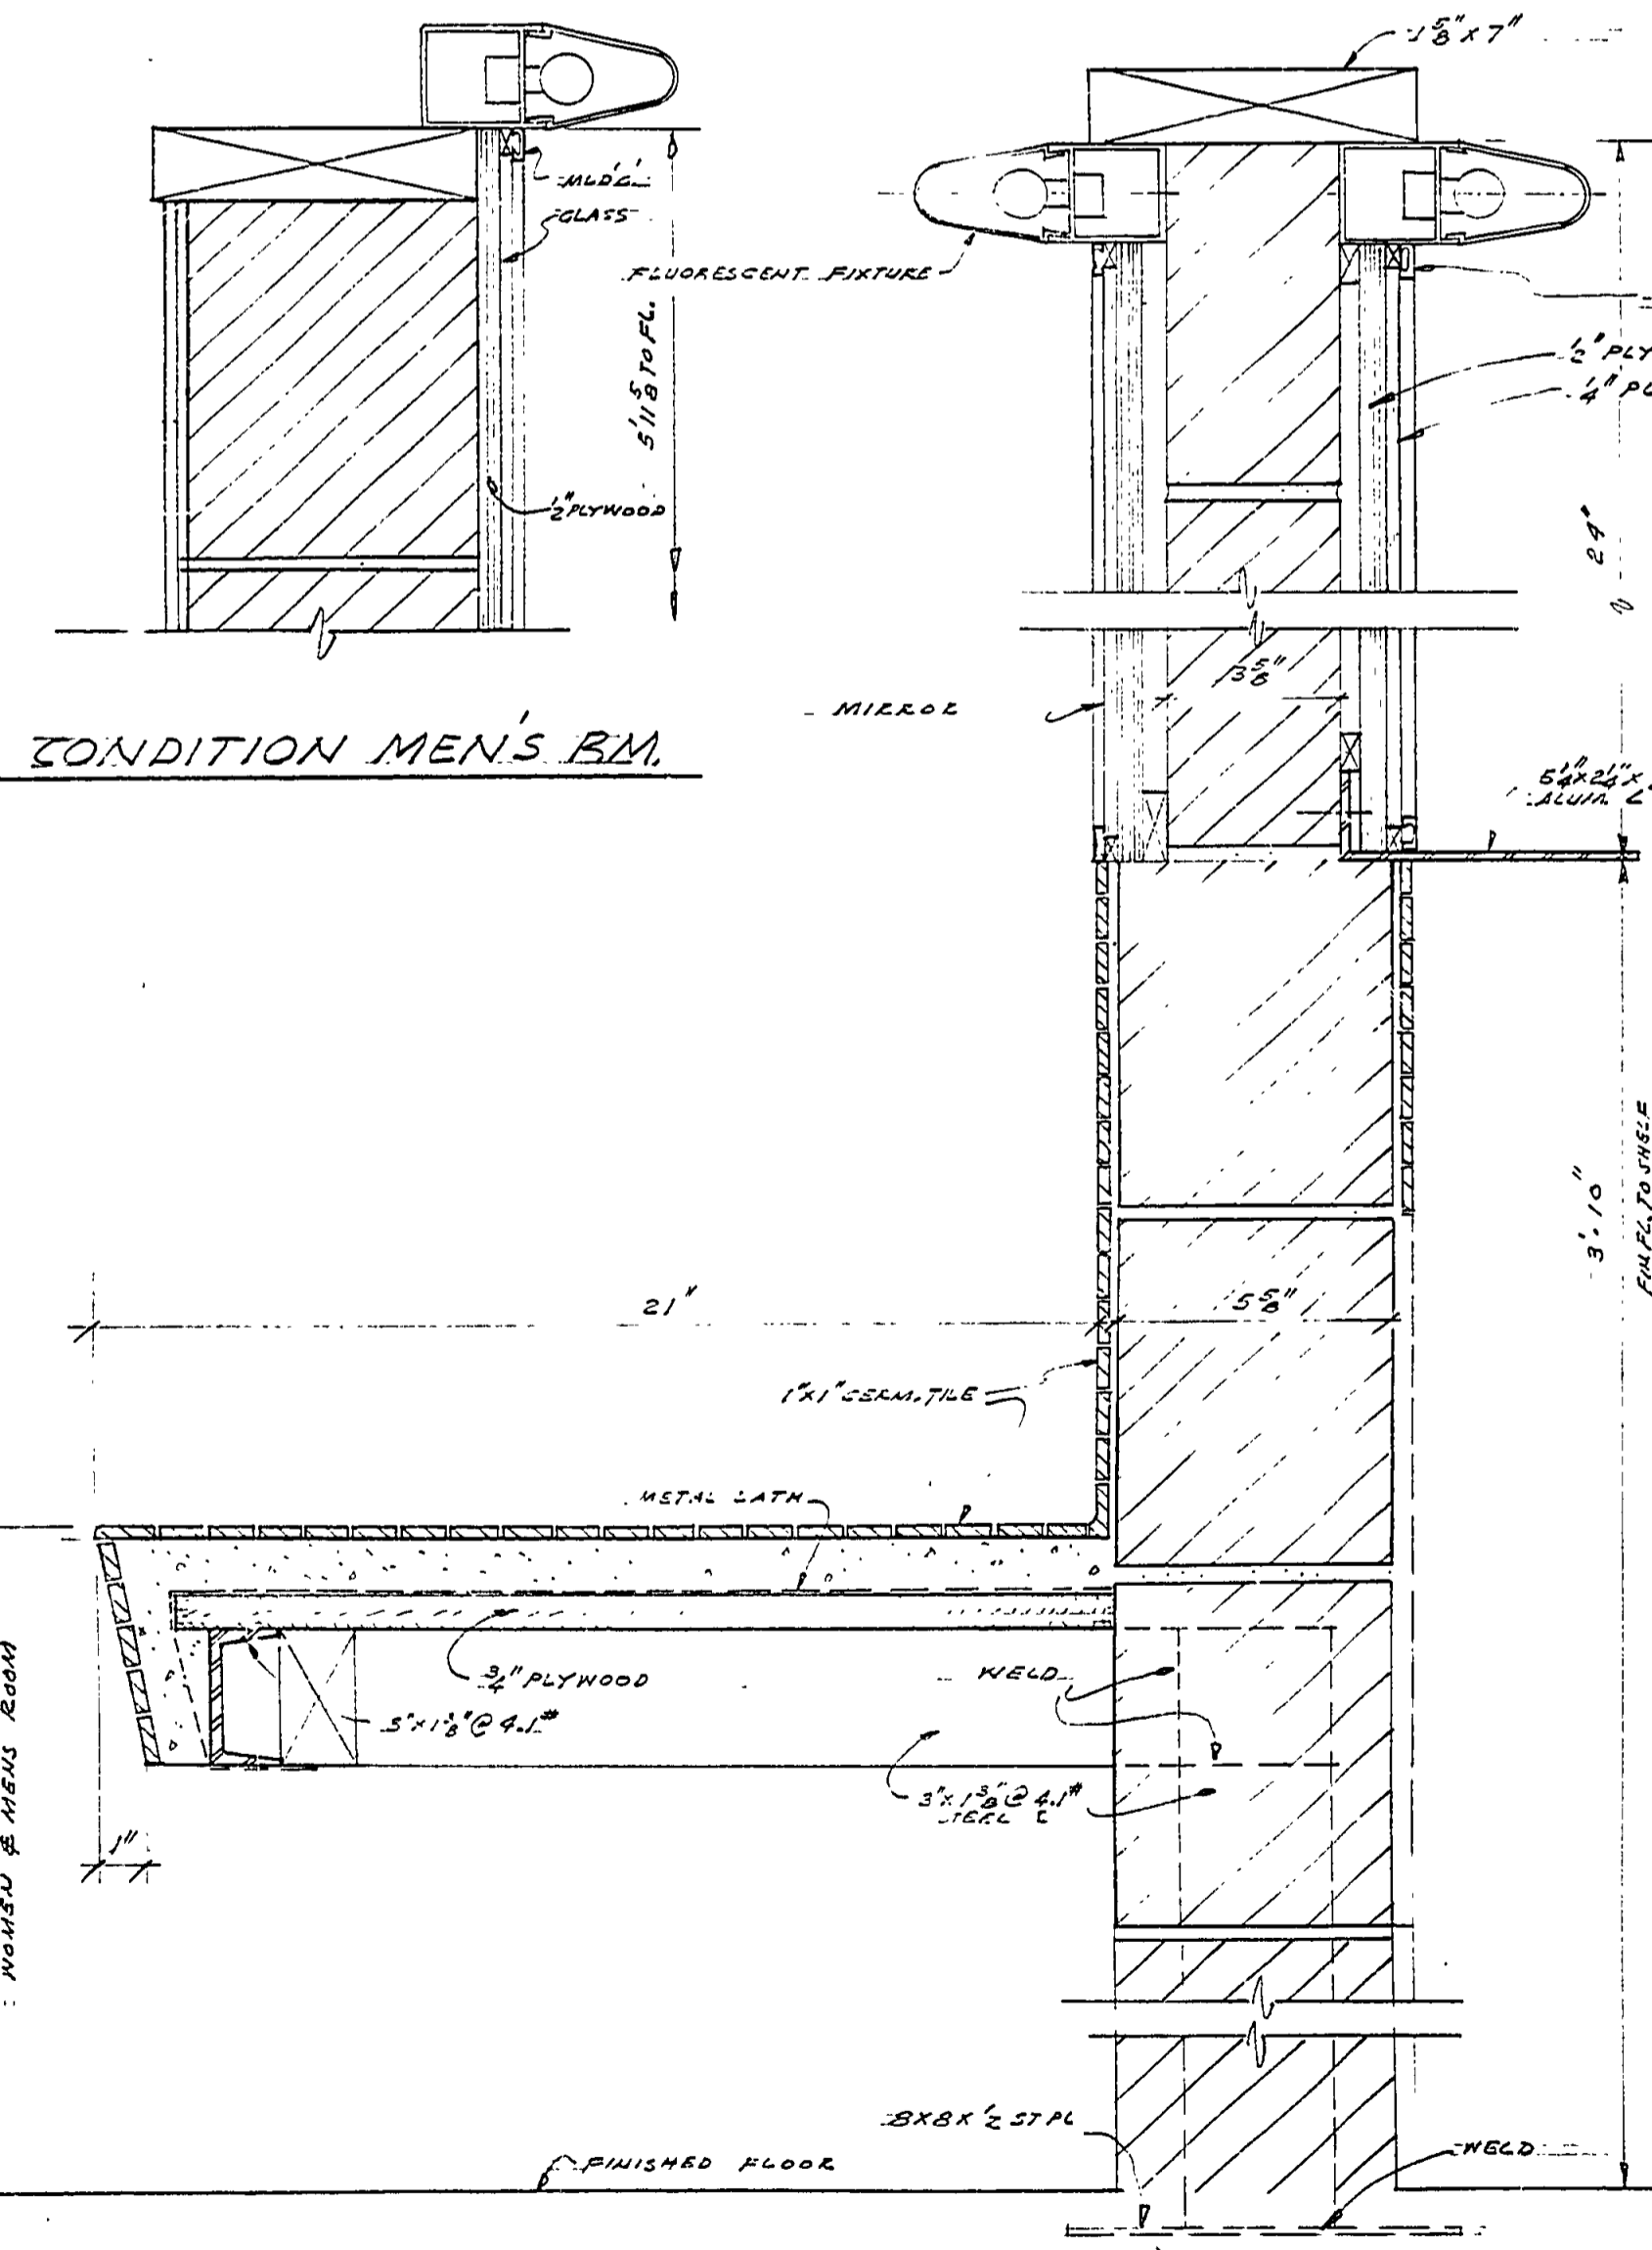

VANITY & SHELF SECT.
SCALE 1/2"=1'-0"

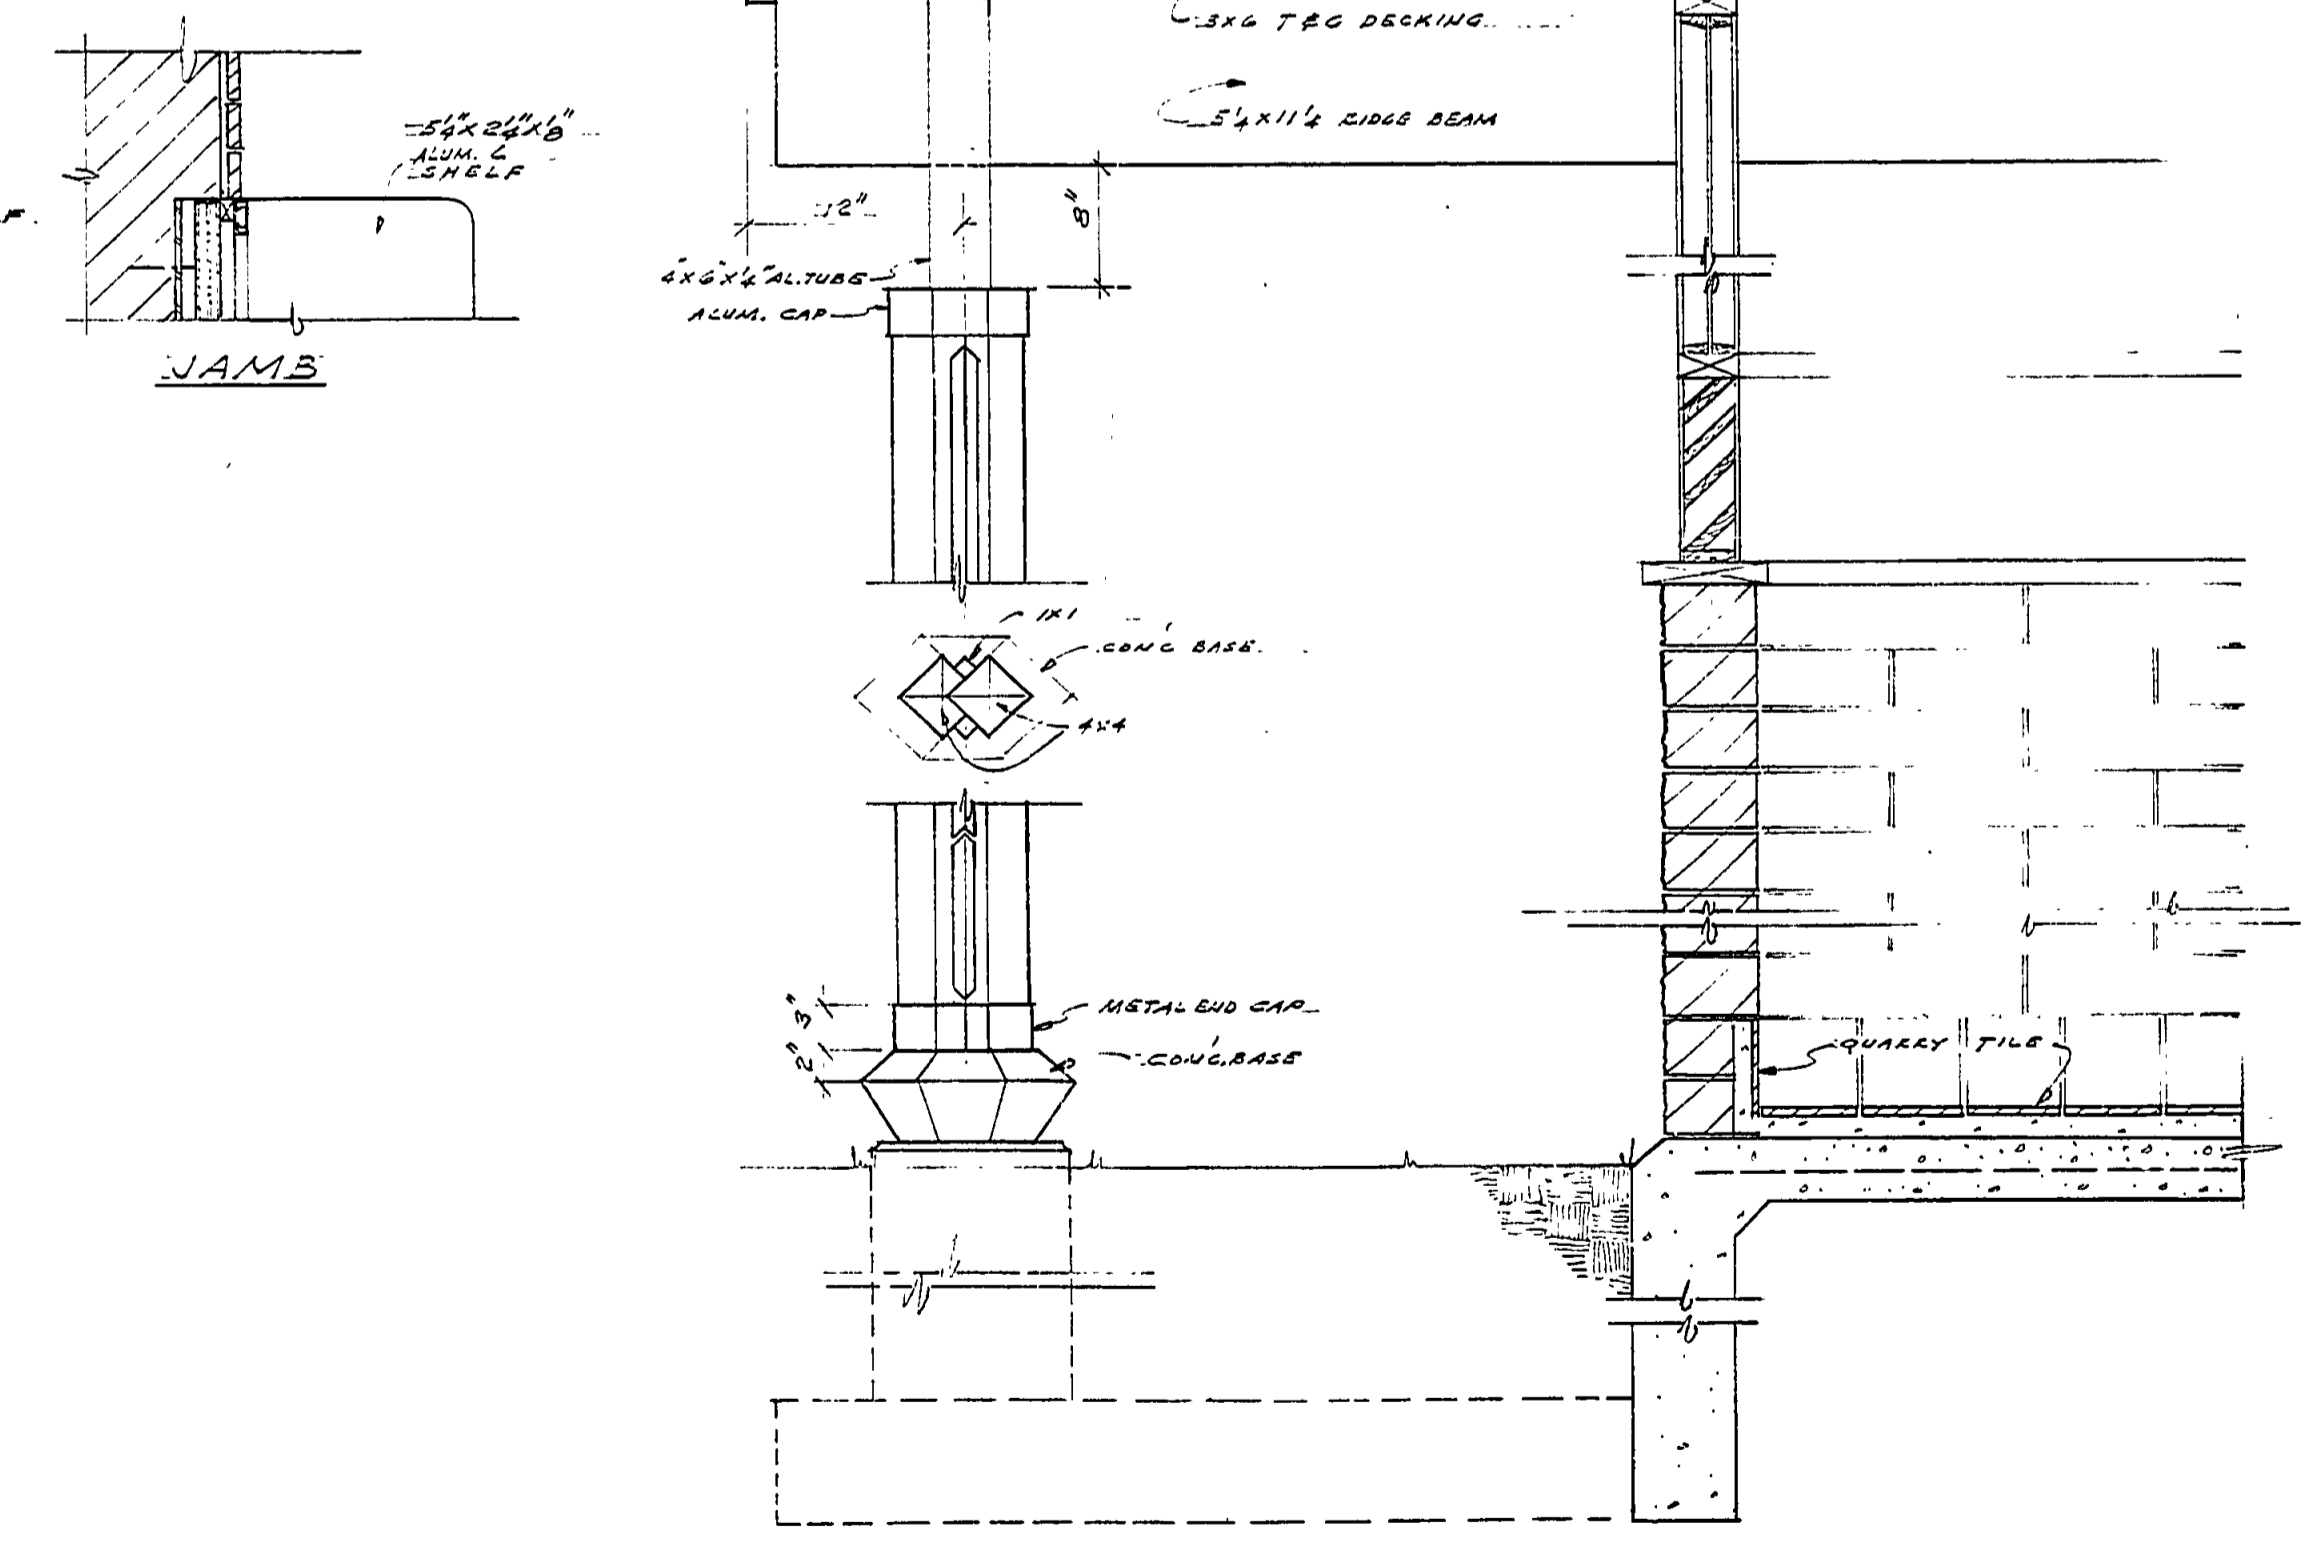

SECTION
SCALE 1/2"=1'-0"

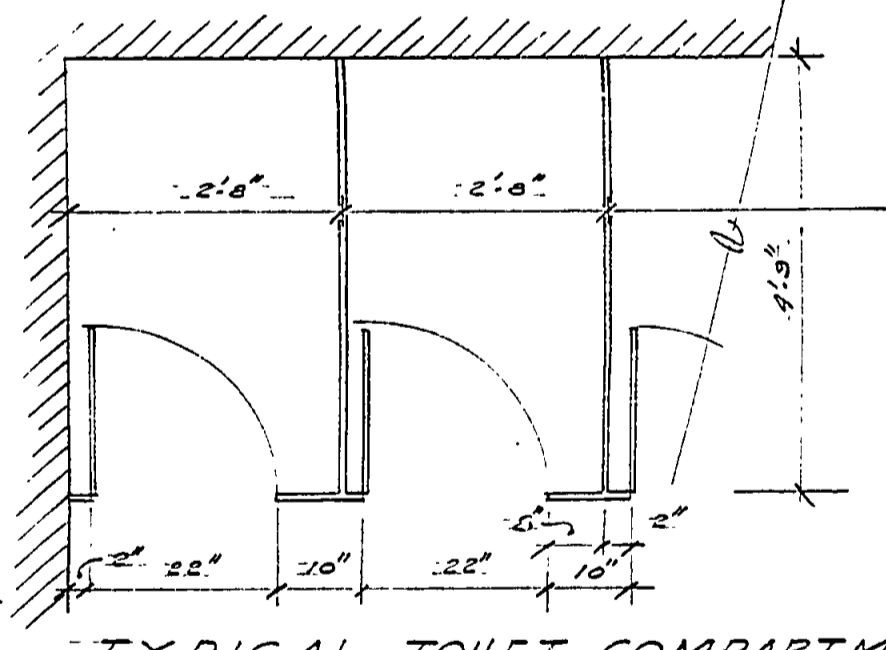

TYPICAL TOILET COMPARTMENTS
SCALE 1/8"=1'-0"

CHANGES

NO.	DESCRIPTION	BY	DATE
1	CHANGE BUILT-IN URINAL TO WALL MOUNTED URINALS (S)		
2	CHANGE TILES TO CERAMIC (S)		
3	CHANGE TILES TO METAL CLUSTERS (S)		

FINISH SCHEDULE

ROOMS	CEILING	FLOOR	BASE	WALLS	WOOD FIN.	REMARKS
MEN'S TOILET	○	○	○	○	○	CERAM TILE EXTER. WALL SHOWER
WOMEN'S TOILET	○	○	○	○	○	"
UTILITY ROOM	○	○	○	○	○	"
PIPE ALLEY	○	○	○	○	○	"

DOOR SCHEDULE

DESIGNATION	TYPE	NO.	SIZE	REMARKS
①	FLOOR	18	24	SOLID CORE
②	"	18	24	"
③	"	18	24	"
④	"	18	24	"